SEE 18-00-021-C
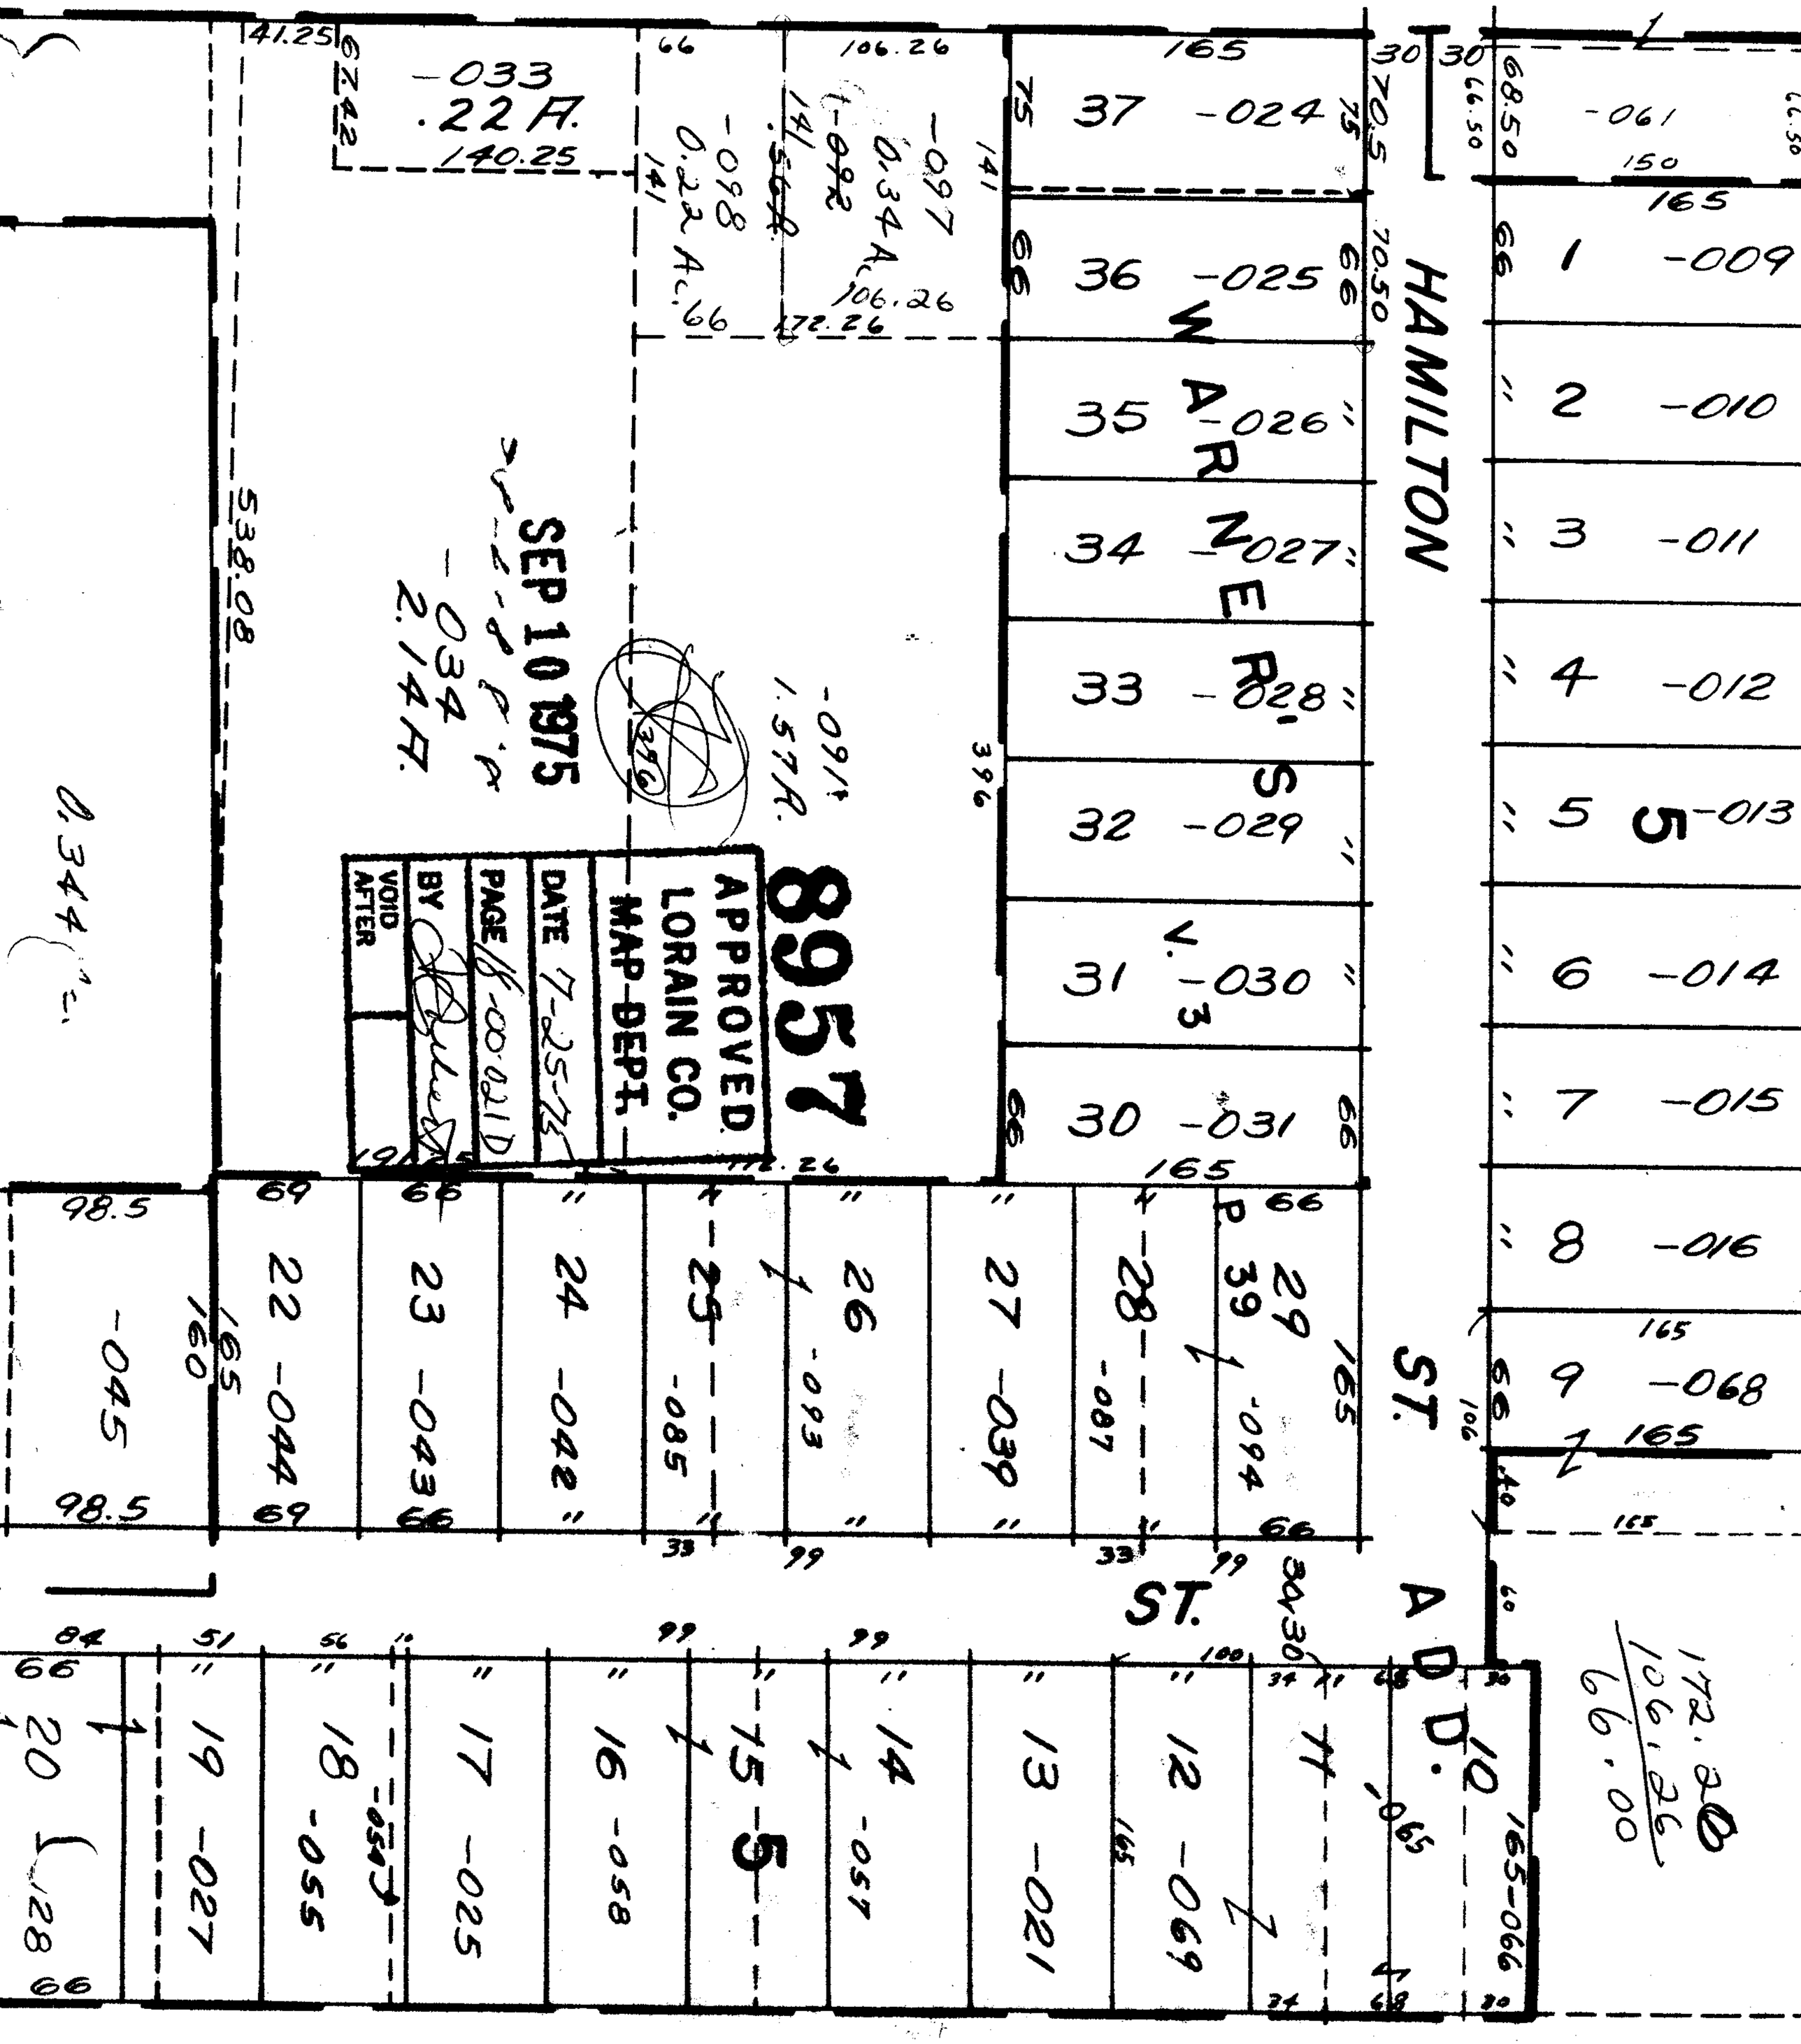
JUL 25 1975