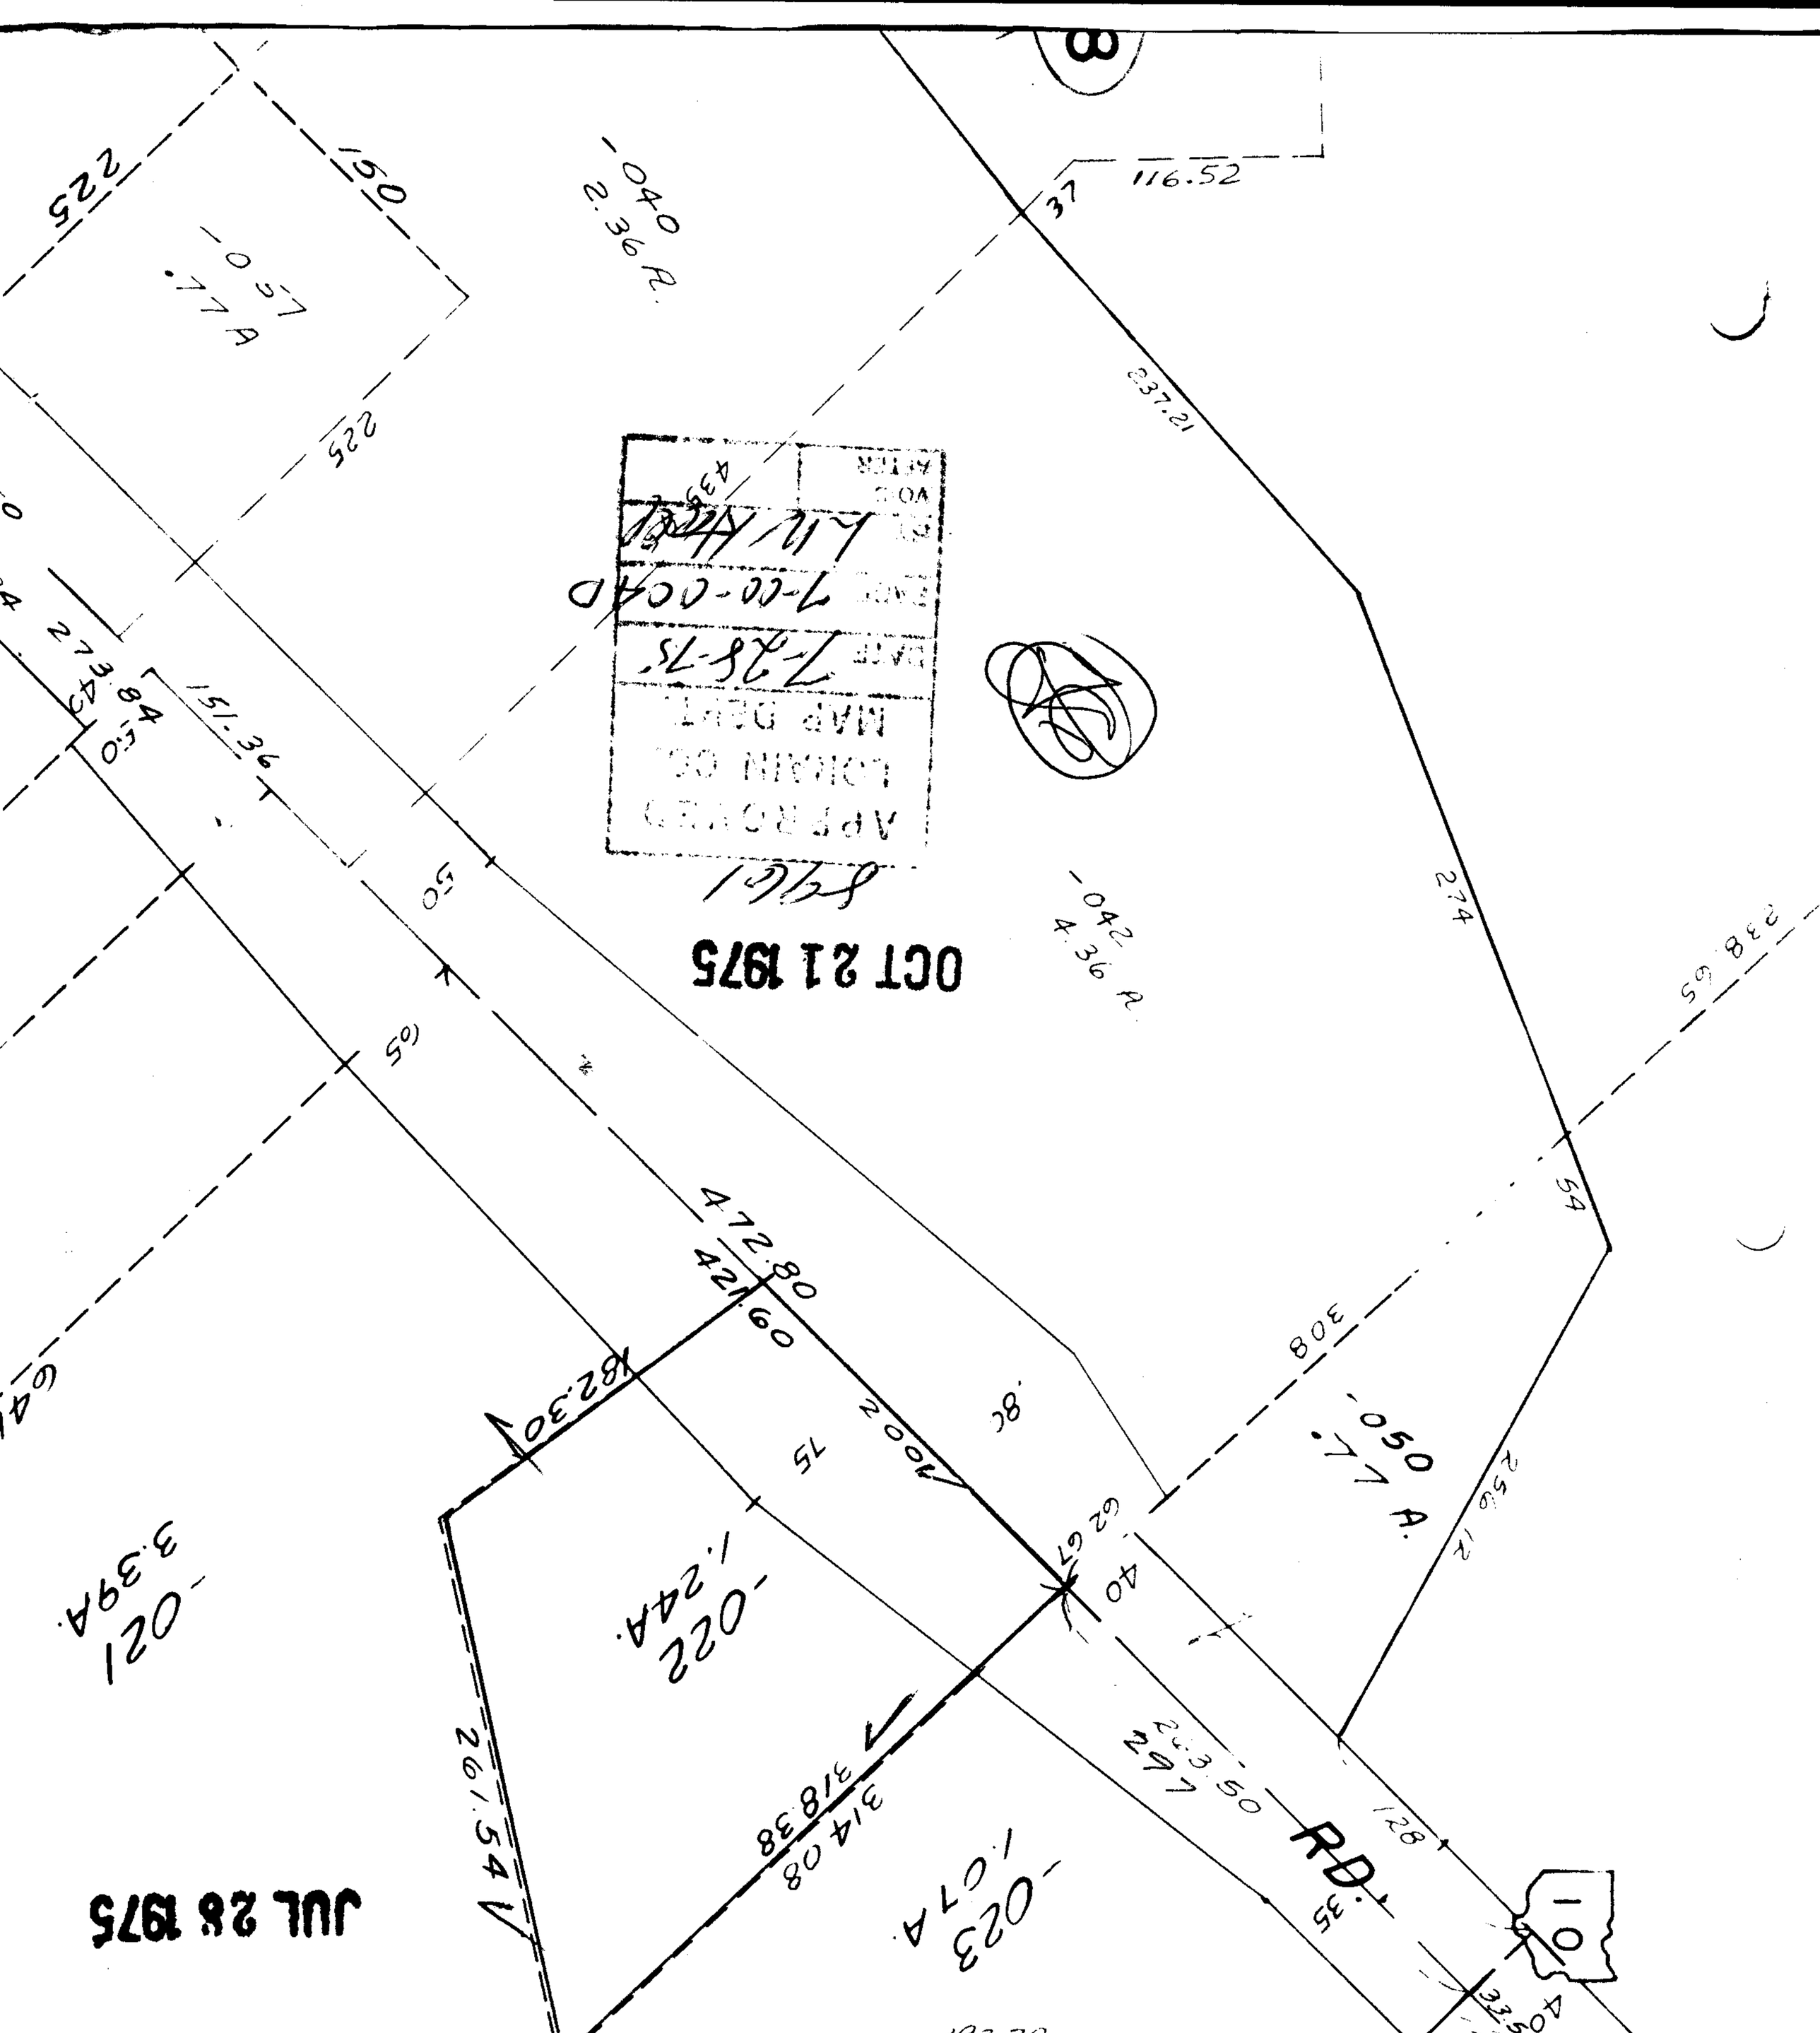
225
150
-057
.77 A
225
-040
2.36 A.
116.52
37
237.21
APPROVED
LORAIN CO.
MAP DEPT.
DATE 7-28-75
OCT 21 1975
-042
4.36 A.
274
238.65
273.84
E.O.
151.36
50
65
472.80
421.60
82.30
100.2
75
80
308
-050
.77 A.
250.12
62.67
40
-021
3.39A.
-022
1.24A.
261.54
314.08
318.38
-023
1.07A.
223.50
RD.
35
128
JUL 28 1975
393.28
CUYAHOGA CO.
1928