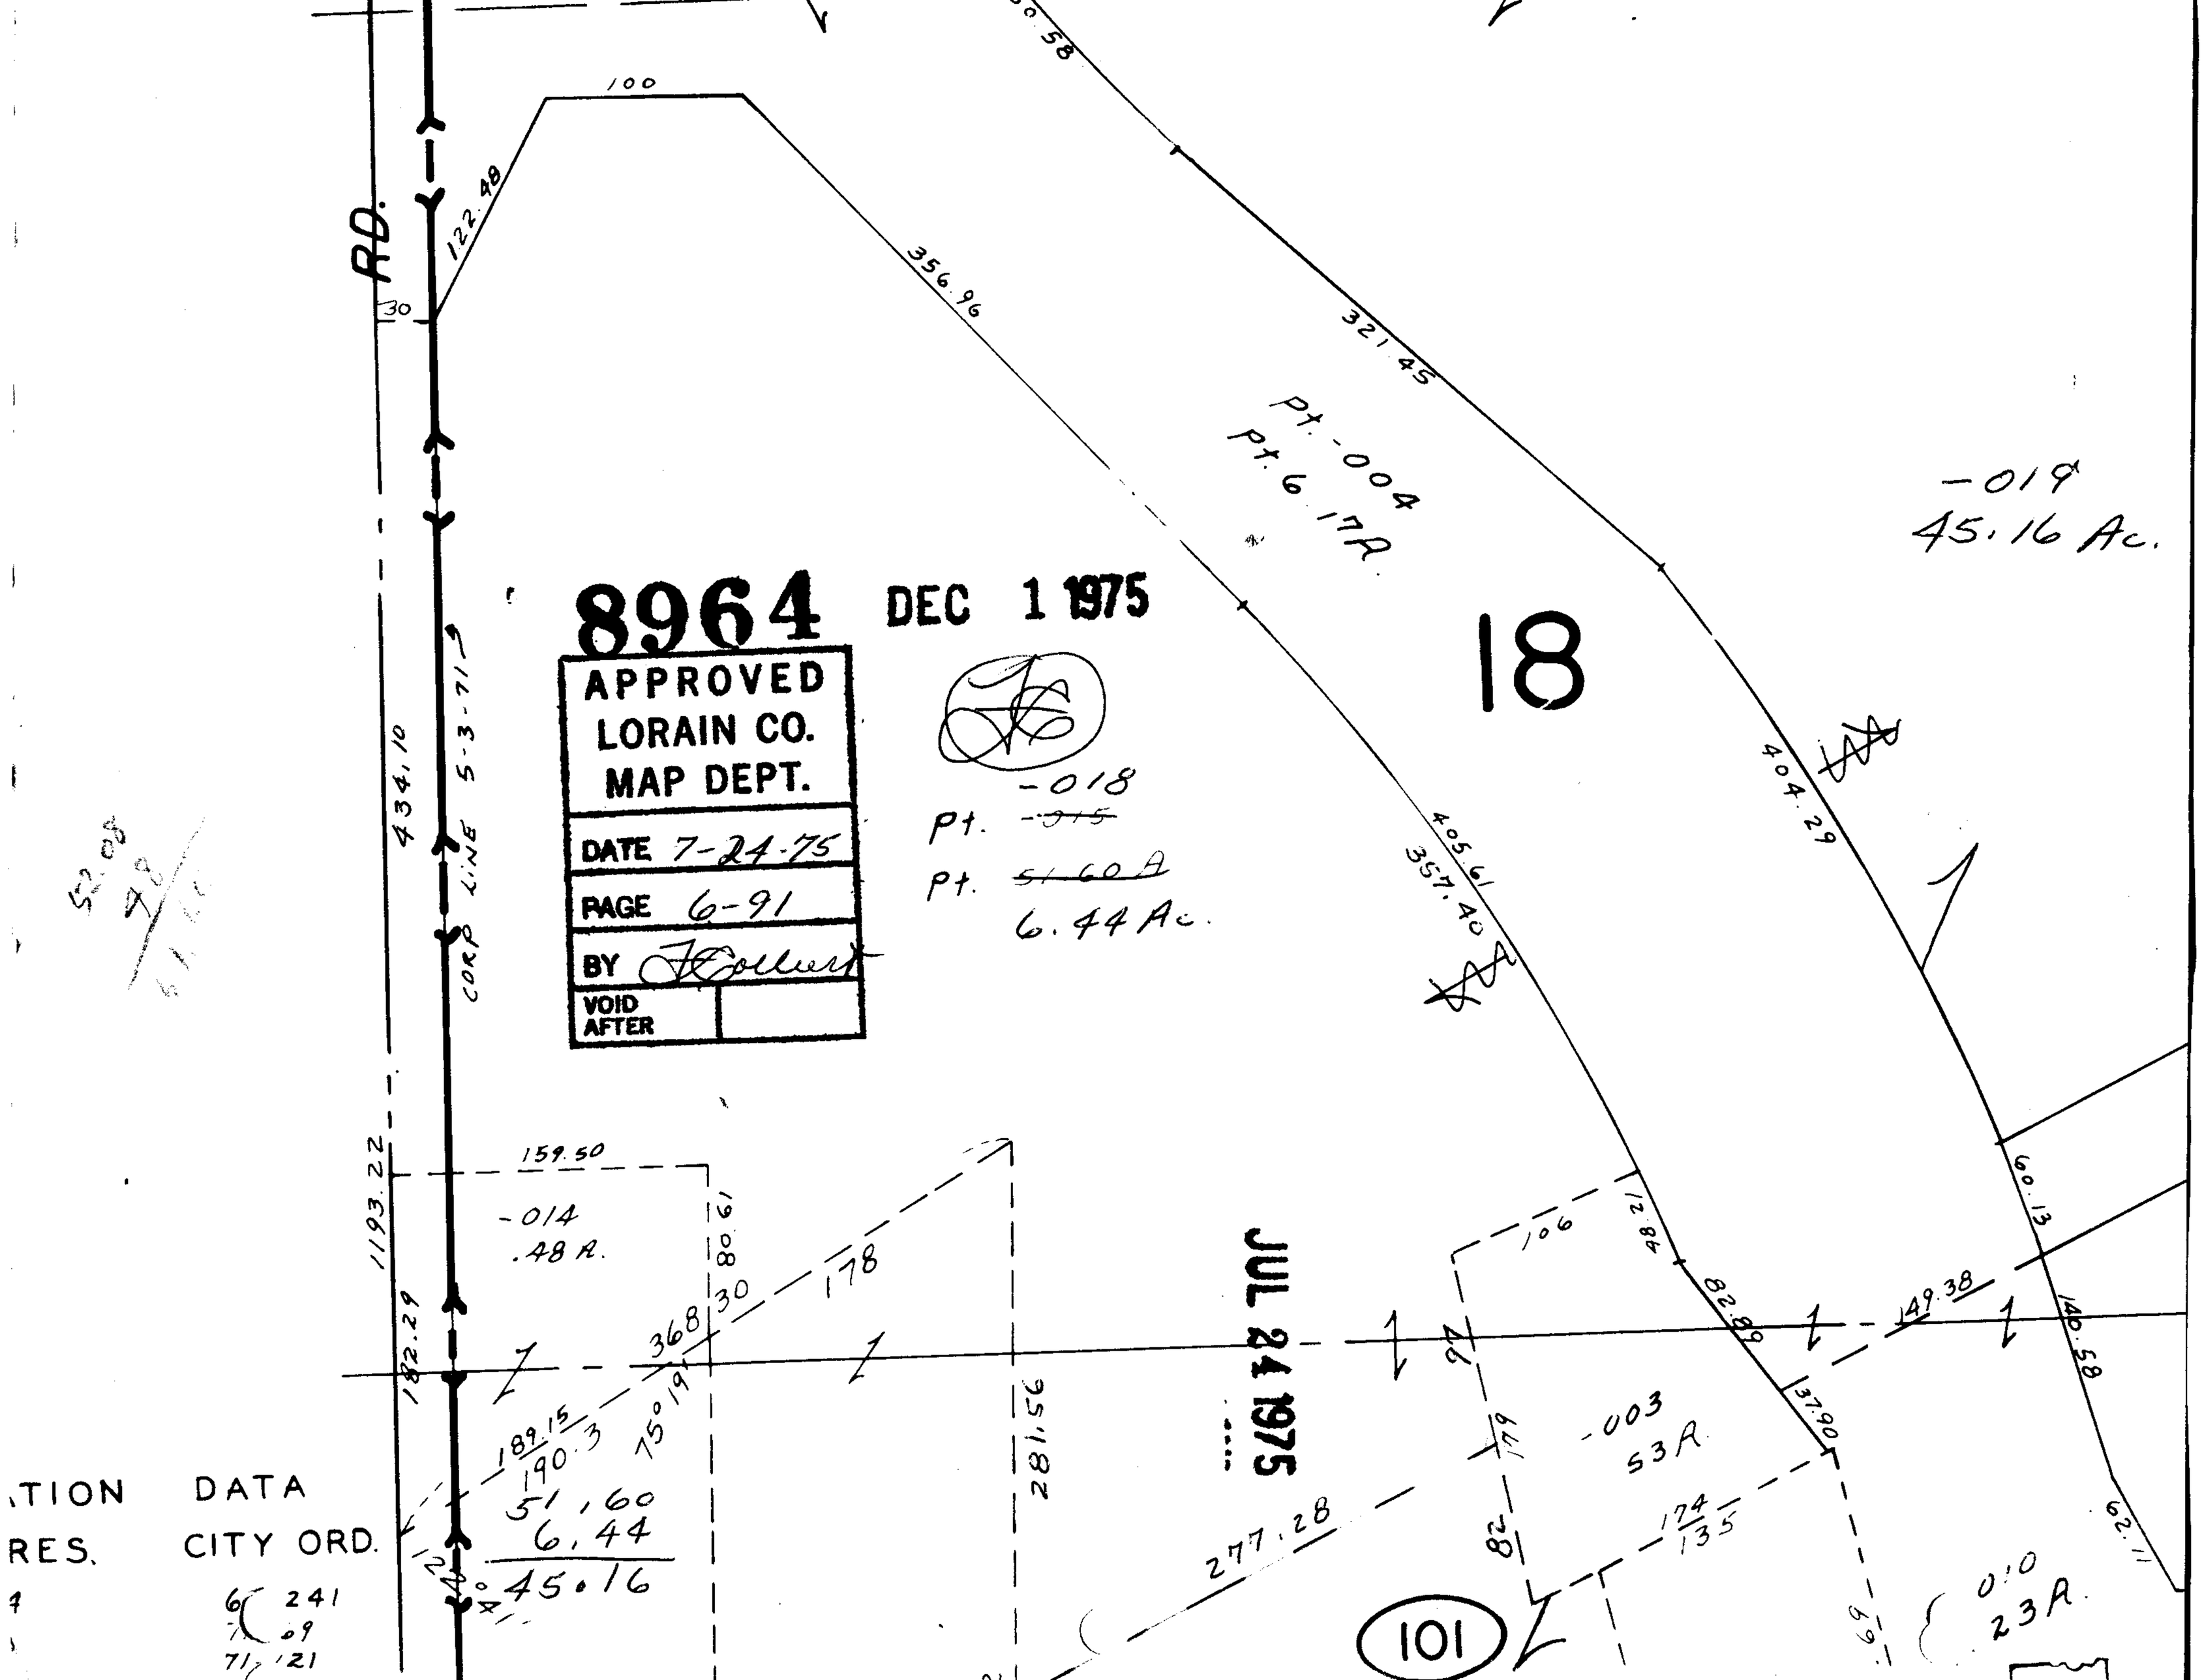

RD.
100
122.48
30
356.96
321.45
Pt. -004
Pt. 6.17A.
-019
45.16 Ac.
8964 DEC 1 1975
APPROVED
LORAIN CO.
MAP DEPT.
DATE 7-24-75
PAGE 6-91
BY
VOID AFTER
-018
Pt. ~~-015~~
Pt. ~~51.60 A~~
6.44 Ac.
18
404.29
405.61
357.40
434.10
CORP LINE 5-3-71
52.08
1193.22
159.50
-014
.48 A.
80.61
178
368.30
182.29
189.15
190.3
75°19'
281.56
JUL 24 1975
106
12.84
82.89
149.38
60.13
140.58
37.90
-003
53 A.
174
135
277.28
62.11
010
23 A.
101
TION DATA
RES. CITY ORD.
6 241
71 09
71 121
51.60
6.44
45.16