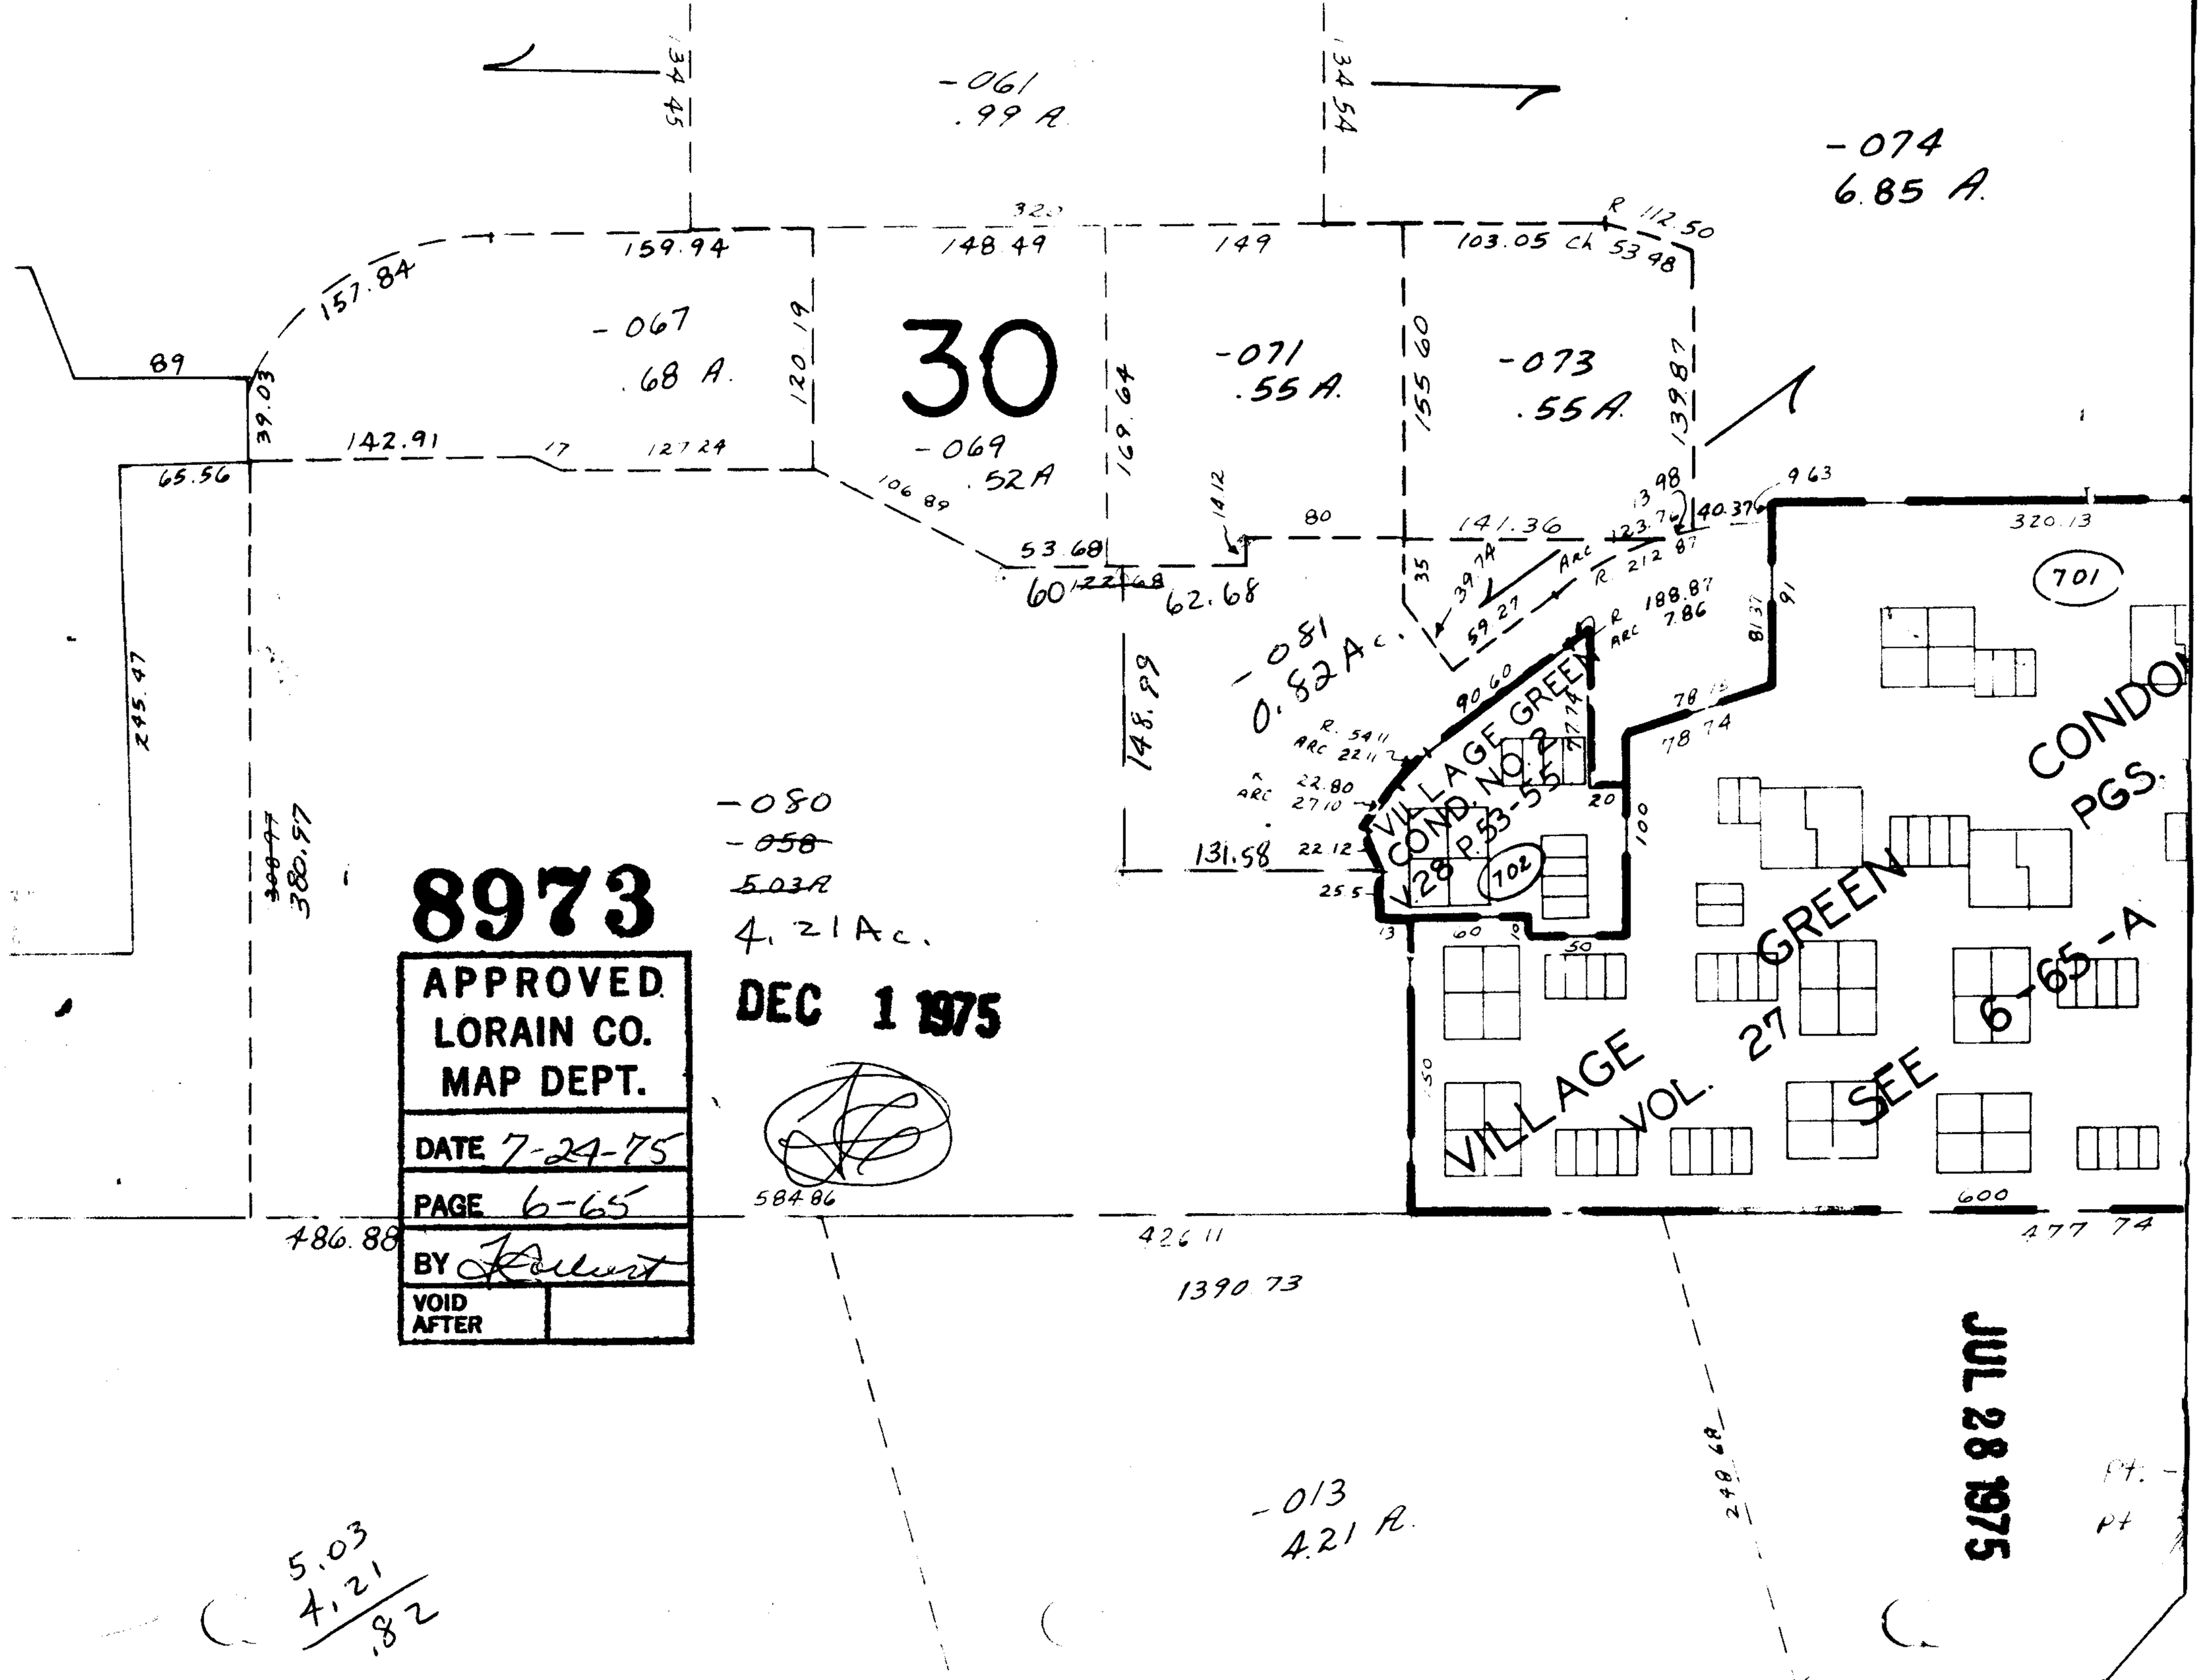

8973

APPROVED
LORAIN CO.
MAP DEPT.

DATE 7-24-75

PAGE 6-65

BY [signature]

VOID AFTER

DEC 1 1975

JUL 28 1975