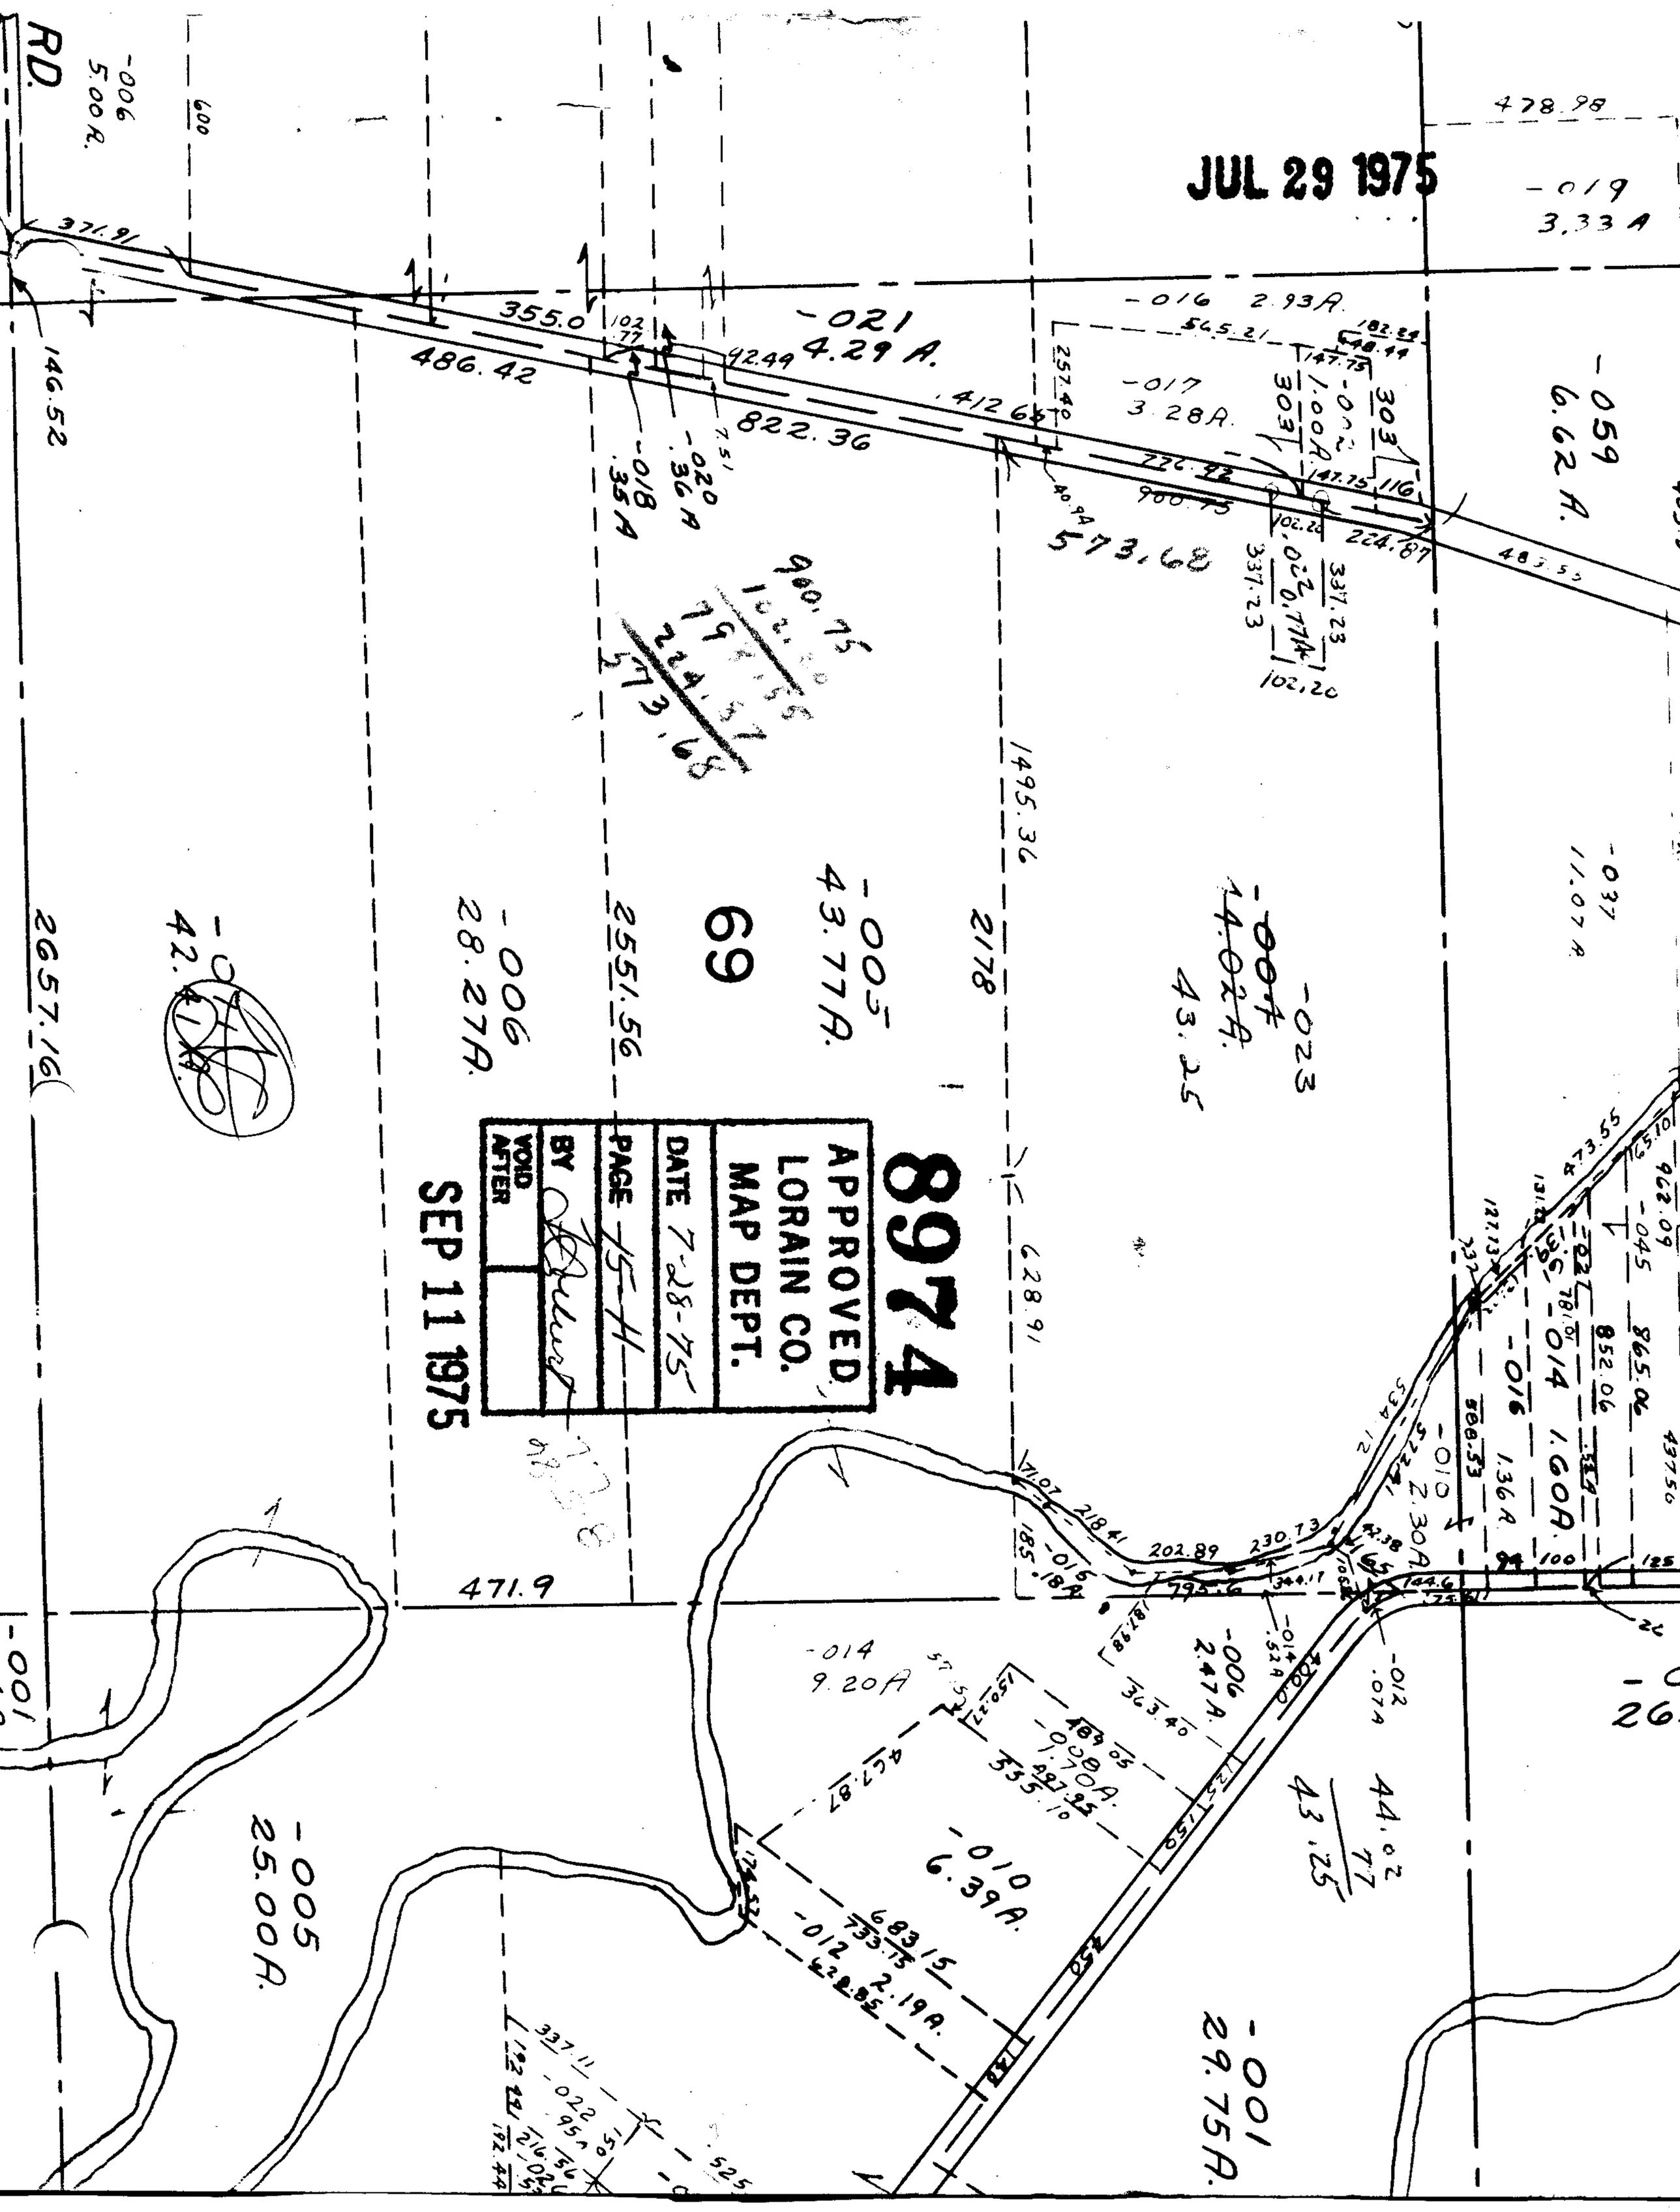

JUL 29 1975
8974
APPROVED
LORAIN CO.
MAP DEPT.
DATE 7-28-75
PAGE 15-H
BY
VOID AFTER
SEP 11 1975
RD.
-006 5.00 A.
371.91
146.52
355.0
486.42
-021 4.29 A.
822.36
-018 .35 A
-020 .36 A
-016 2.93 A.
-017 3.28 A.
-019 3.33 A
-059 6.62 A.
573.68
1495.36
2178
-005 43.77 A.
69
2551.56
-006 28.27 A.
-023 43.25
-037 11.07 A
2657.16
471.9
-014 9.20 A
-010 6.39 A.
-012 2.19 A.
-005 25.00 A.
-001 29.75 A.
-014 1.60 A.
-016 1.36 A.
-010 2.30 A.
-006 2.47 A.
-012 .07 A
44.02
43.25