


8986

JUL 31 1975

13.78 H.

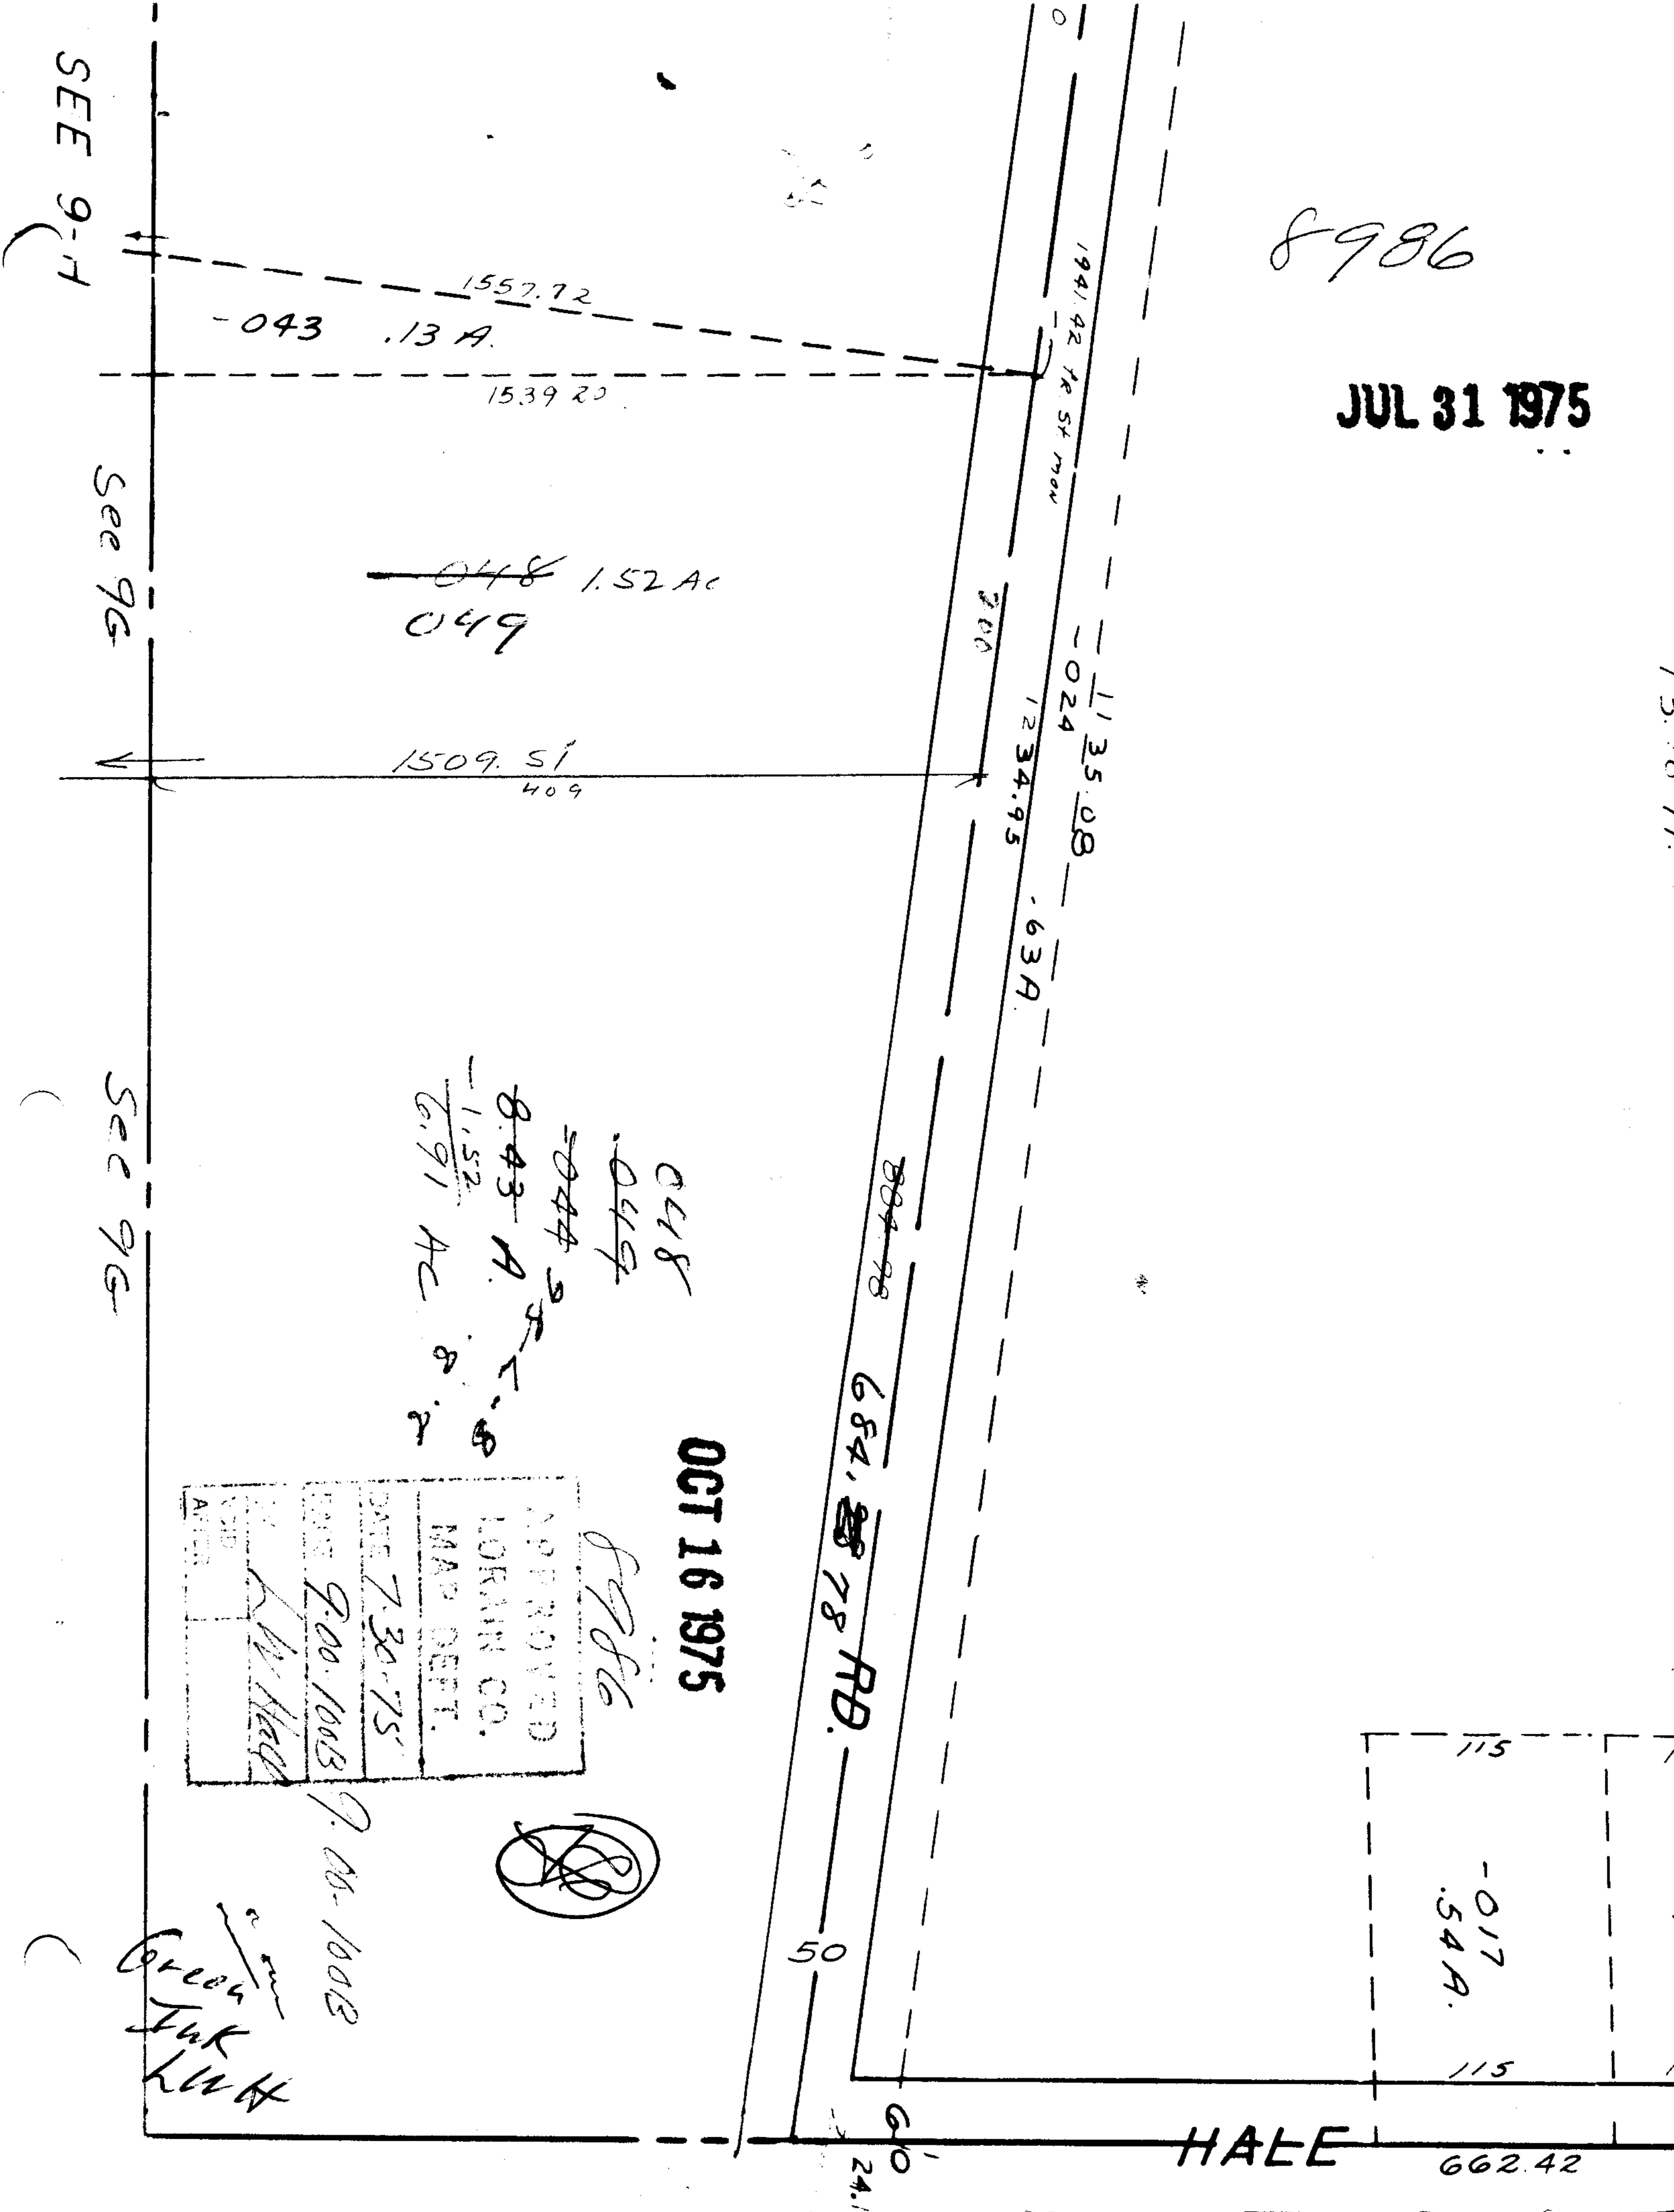

~~048~~ 1.52 AC  
049

048  
~~1.52~~  
 6.91 AC 8.8

OCT 16 1975

8986

APPROVED
LORAIN CO.
MAP DEPT.
DATE 7-30-75
TIME 9:00-10:03
BY <i>[Signature]</i>

9.06-100B

Green  
Tuk  
HWH

SEE 9-F

See 9G

See 9G