


SA 4

9002

Sec 8852
8853

PG.

AUG 20 1975

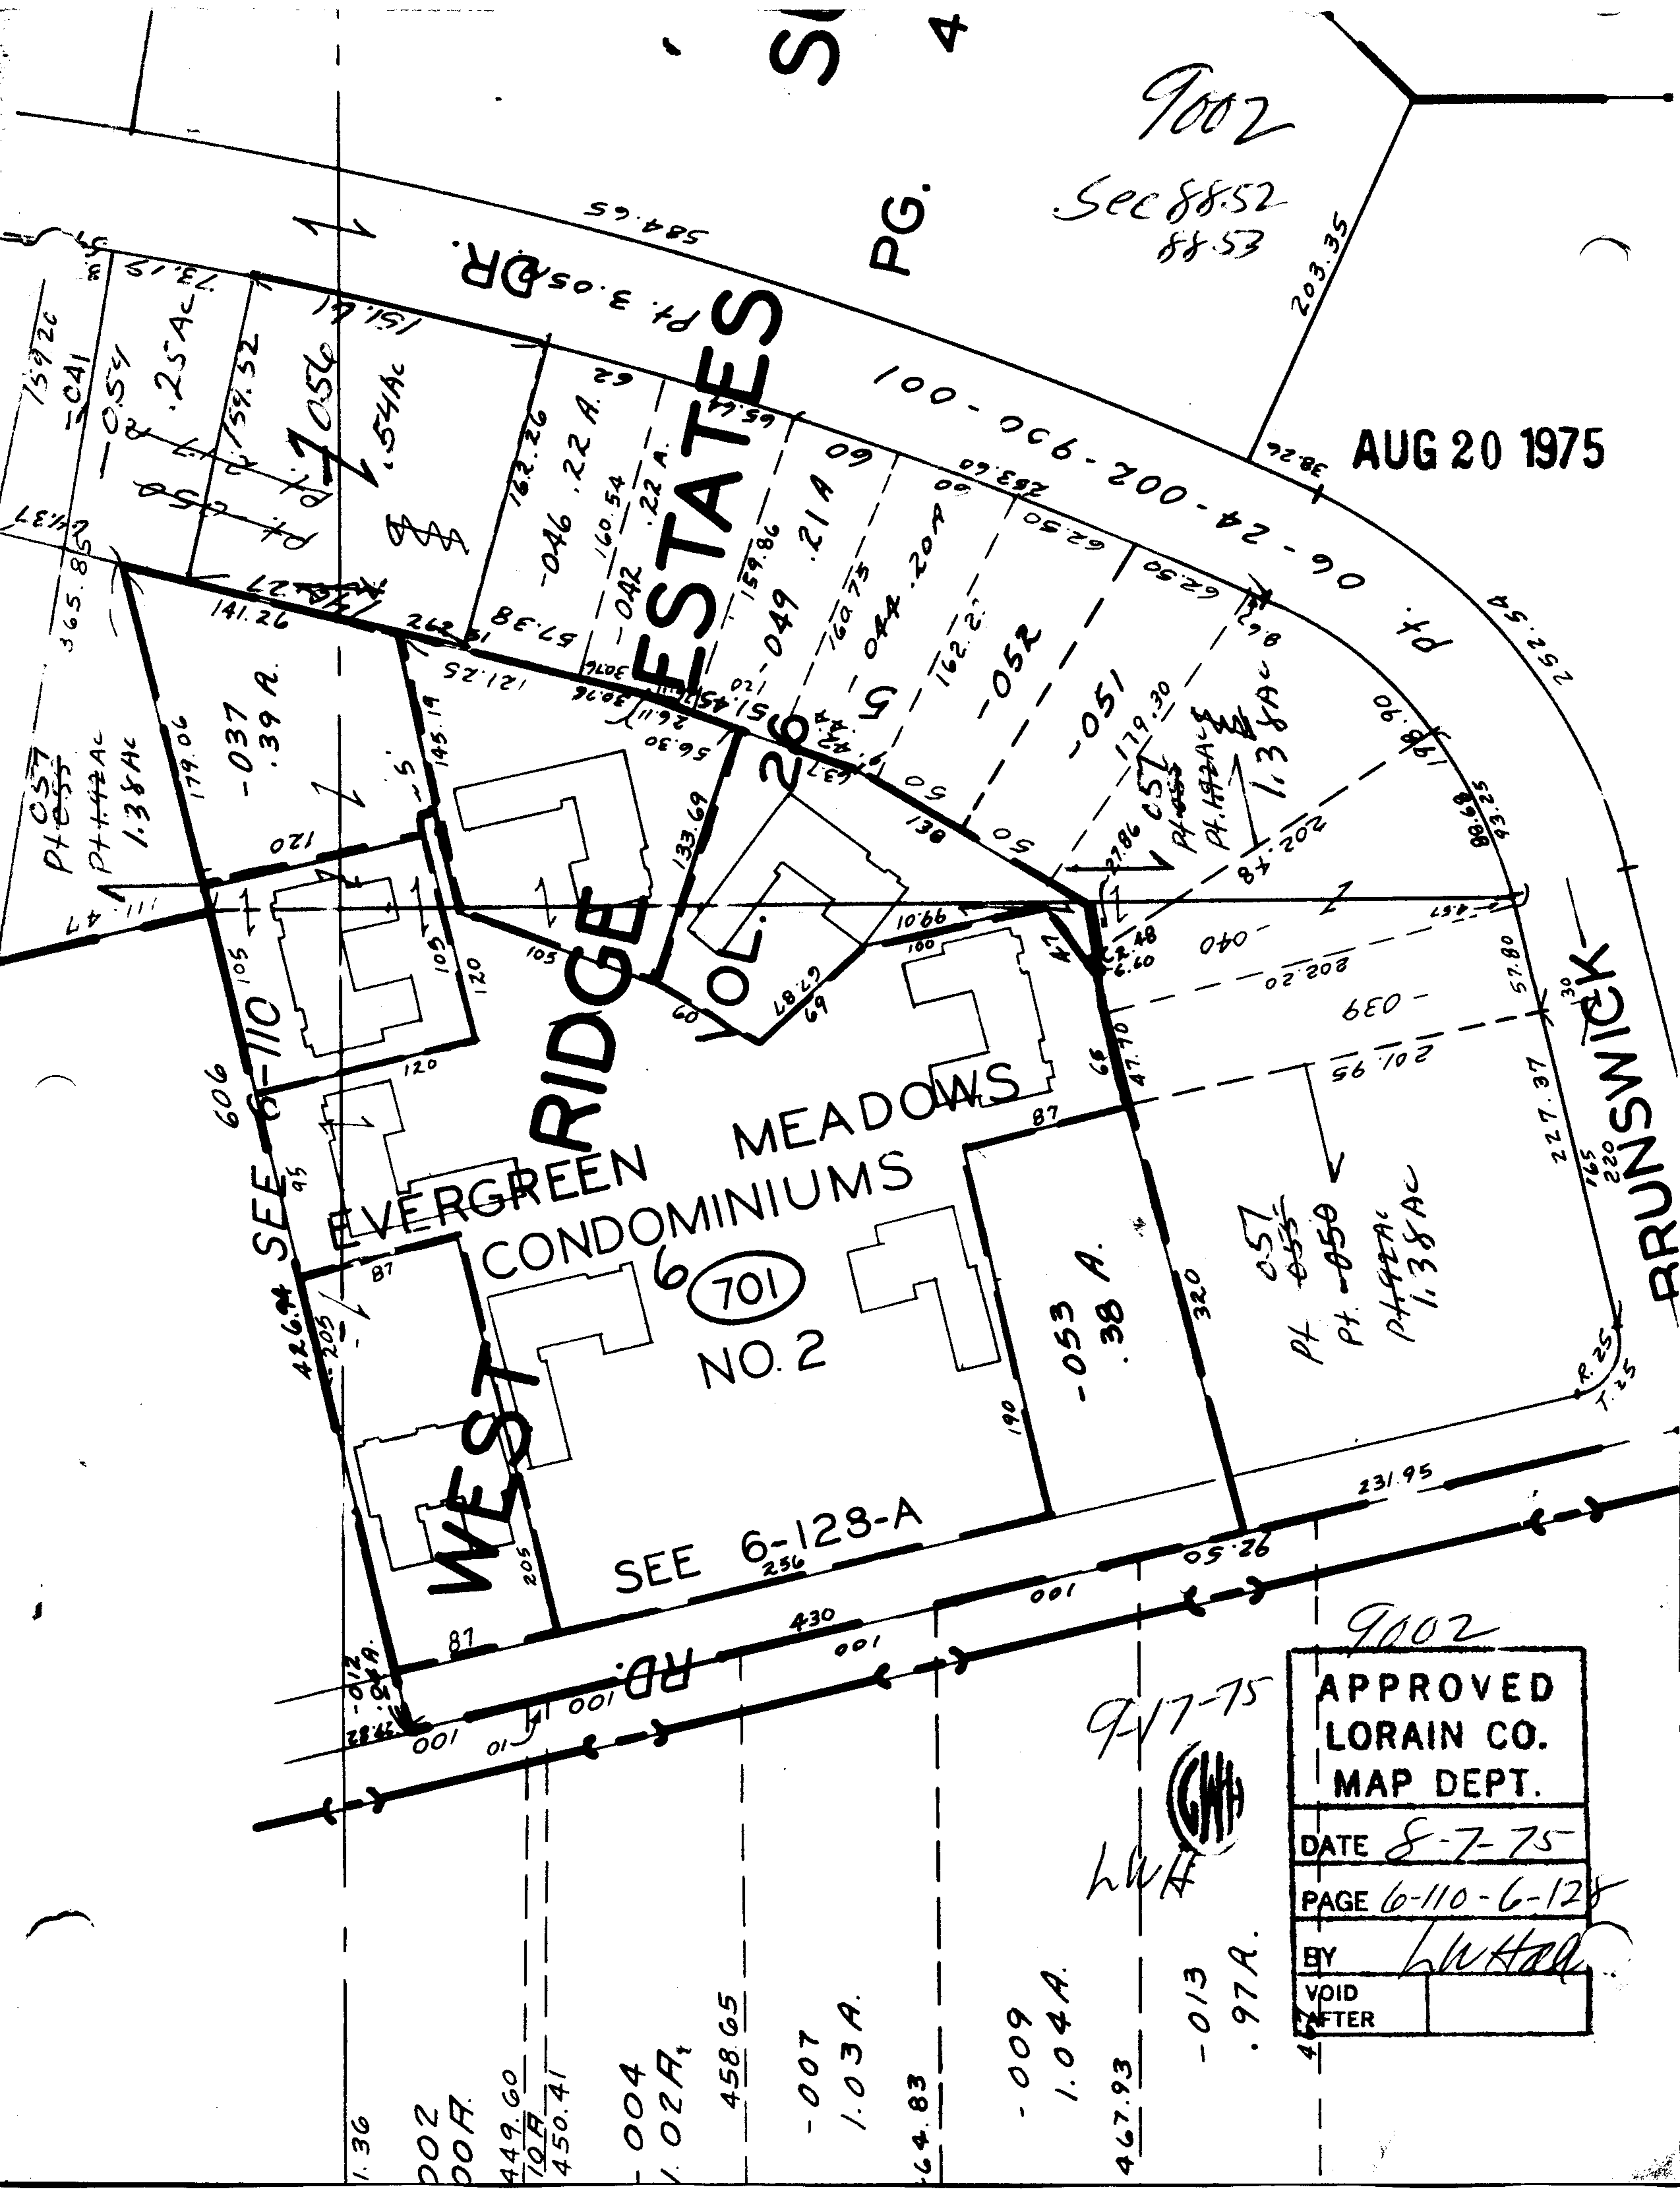

SEE 6-110

WEST RIDGE

ESTATES
VOL. 26

EVERGREEN MEADOWS
CONDOMINIUMS
NO. 2

701

SEE 6-128-A

RD. 6-128-A

BRUNSWICK

9002

APPROVED LORAIN CO. MAP DEPT.	
DATE	8-7-75
PAGE	6-110-6-128
BY	hwh
VOID AFTER	

9-17-75



hwh

- 1.36
- 202
- 00A
- 449.60
- 10A
- 450.41
- 004
- 1.02A₁
- 458.65
- 007
- 1.03A
- 64.83
- 009
- 1.04A
- 467.93
- 013
- .97A