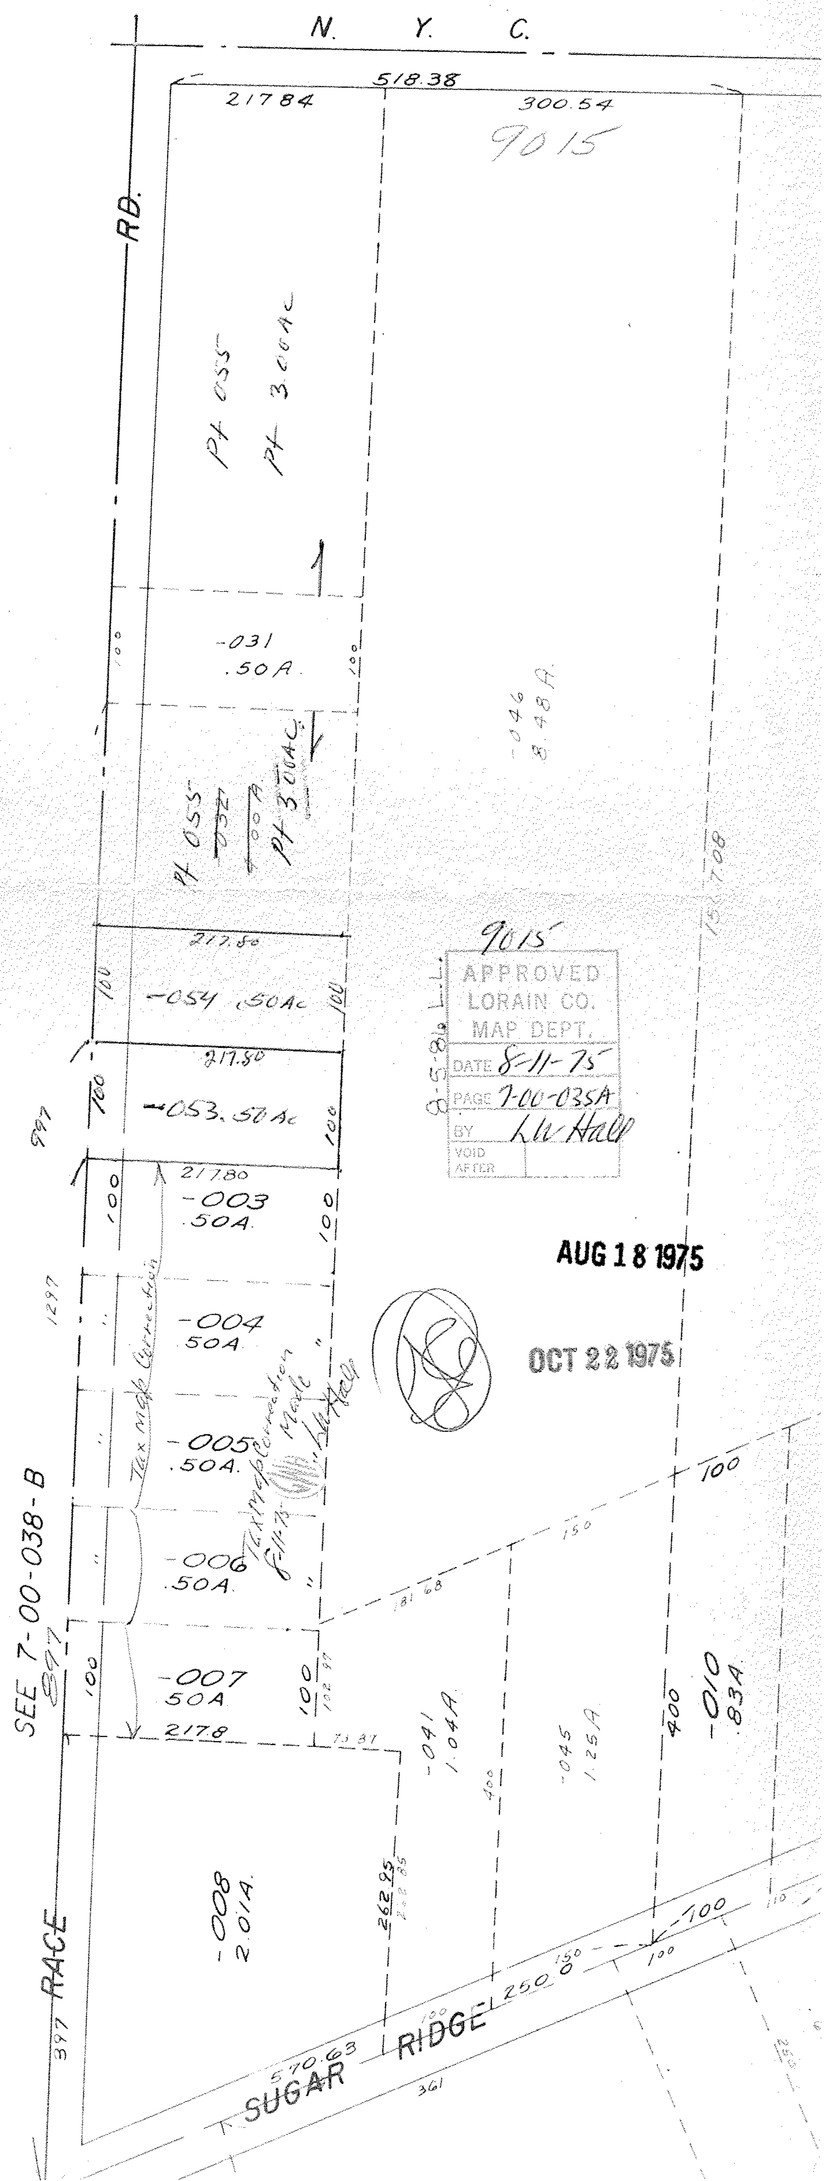
N. Y. C.
518.38
217.84
300.54
9015
RD.
Pt 0.55
Pt 3.66Ac
-031
.50A.
100
200
-046
8.48A.
Pt 0.55
.027
1.00A.
Pt 3.66Ac.
217.80
-054 .50Ac
100
217.80
-053. 50 Ac
997
100
21780
-003
.50A.
1297
-004
.50A.
-005
.50A.
-006
.50A.
-007
.50A
2178
-008
2.01A.
262.25
-041
1.04A.
-045
1.25A.
400
-010
.83A.
SEE 7-00-038-B
397
RACE
SUGAR
RIDGE
570.63
361
25.0
150
100
APPROVED
LORAIN CO.
MAP DEPT.
DATE 8-11-75
PAGE 7-00-035A
BY L.W. Hall
VOID
AFTER
AUG 18 1975
OCT 22 1975
Tax map Correction
Transferred from Map "