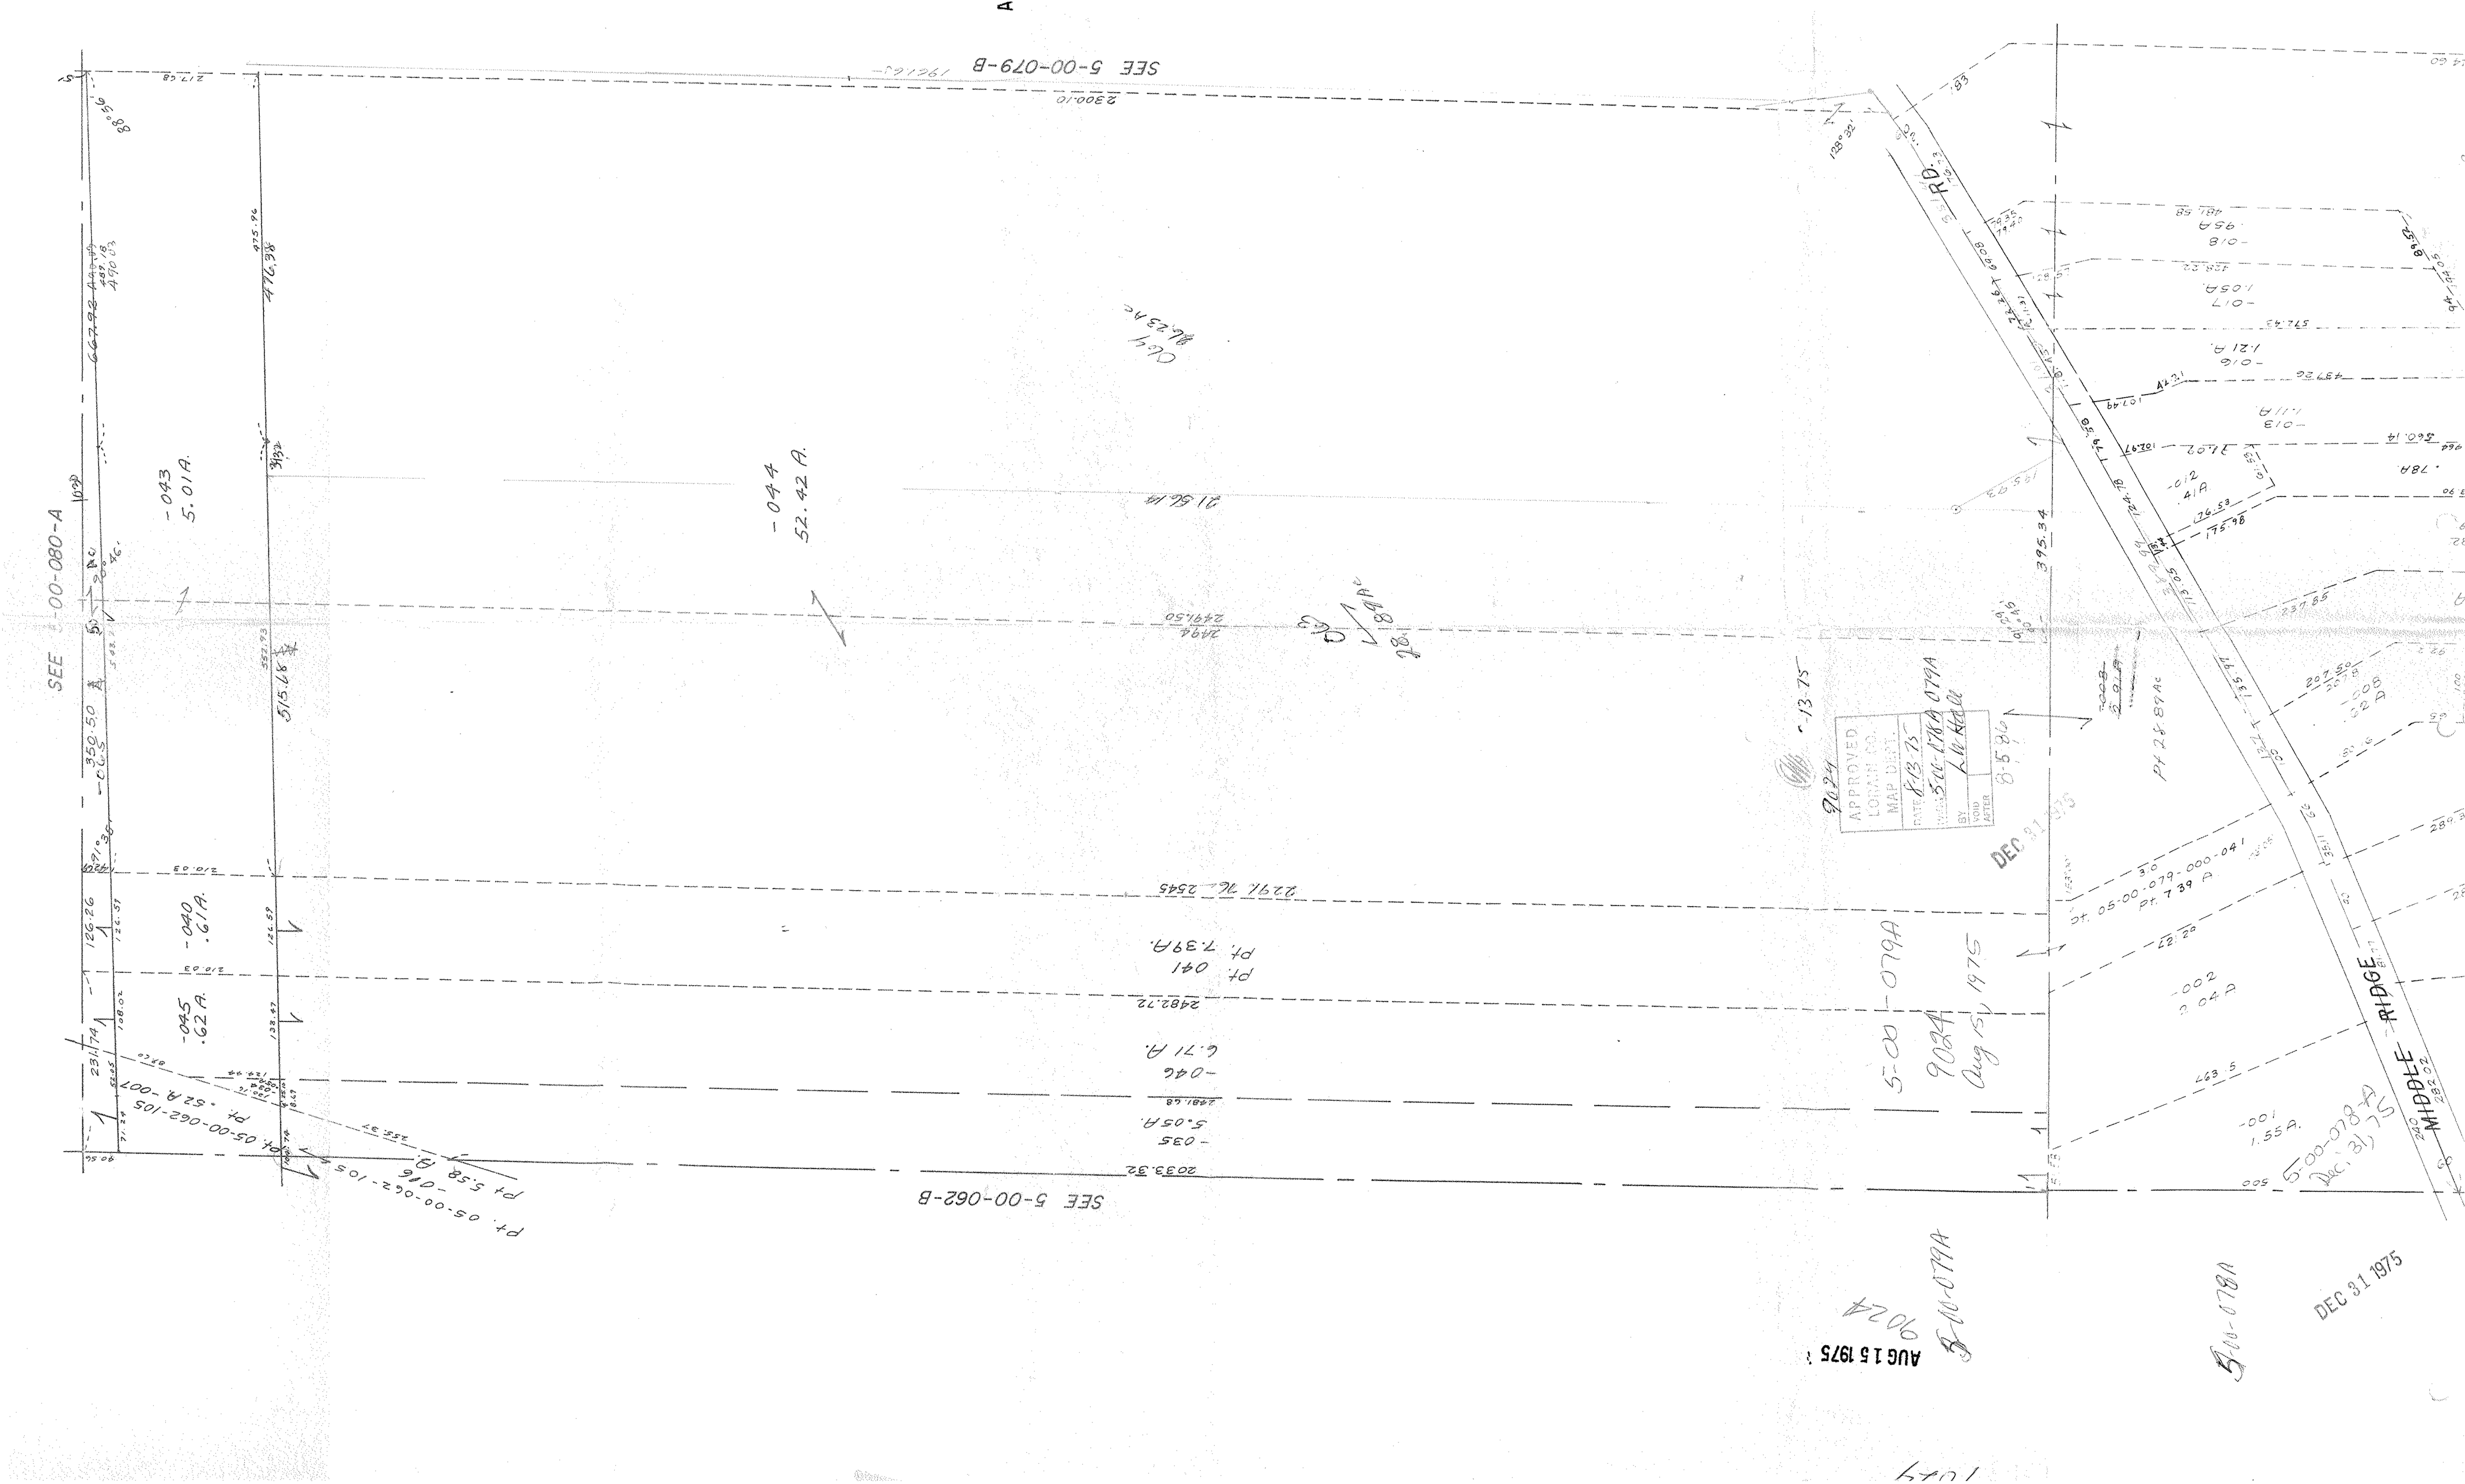
SEE 5-00-079-B
SEE 5-00-080-A
SEE 5-00-062-B
-043
5.01A.
-044
52.42 A.
-040
.61A.
-045
.62A.
-046
6.71 A.
-035
5.05A.
Pt. 05-00-062-105
Pt. 5.58 A.
Pt. 05-00-062-105
Pt. -52A-007
Pt. 041
Pt. 7.39A.
5-00-079A
9024
Aug 15, 1975
5-00-078-A
Dec. 31, 75
MIDDLE RIDGE
-001
1.55A.
-002
2.04A
-017
1.05A
-018
.95A
-016
1.21 A.
-013
1.11A
-012
.41A
.78A
-008
.02 A
Pt 26.89 Ac
APPROVED
LORAIN CO.
MAP DEPT.
DATE 8-13-75
TRANSFER 5-00-178A 079A
BY N. Hader
VOID AFTER 8-5-86
DEC 31 1975
AUG 15 1975
5-00-078A
DEC 31 1975