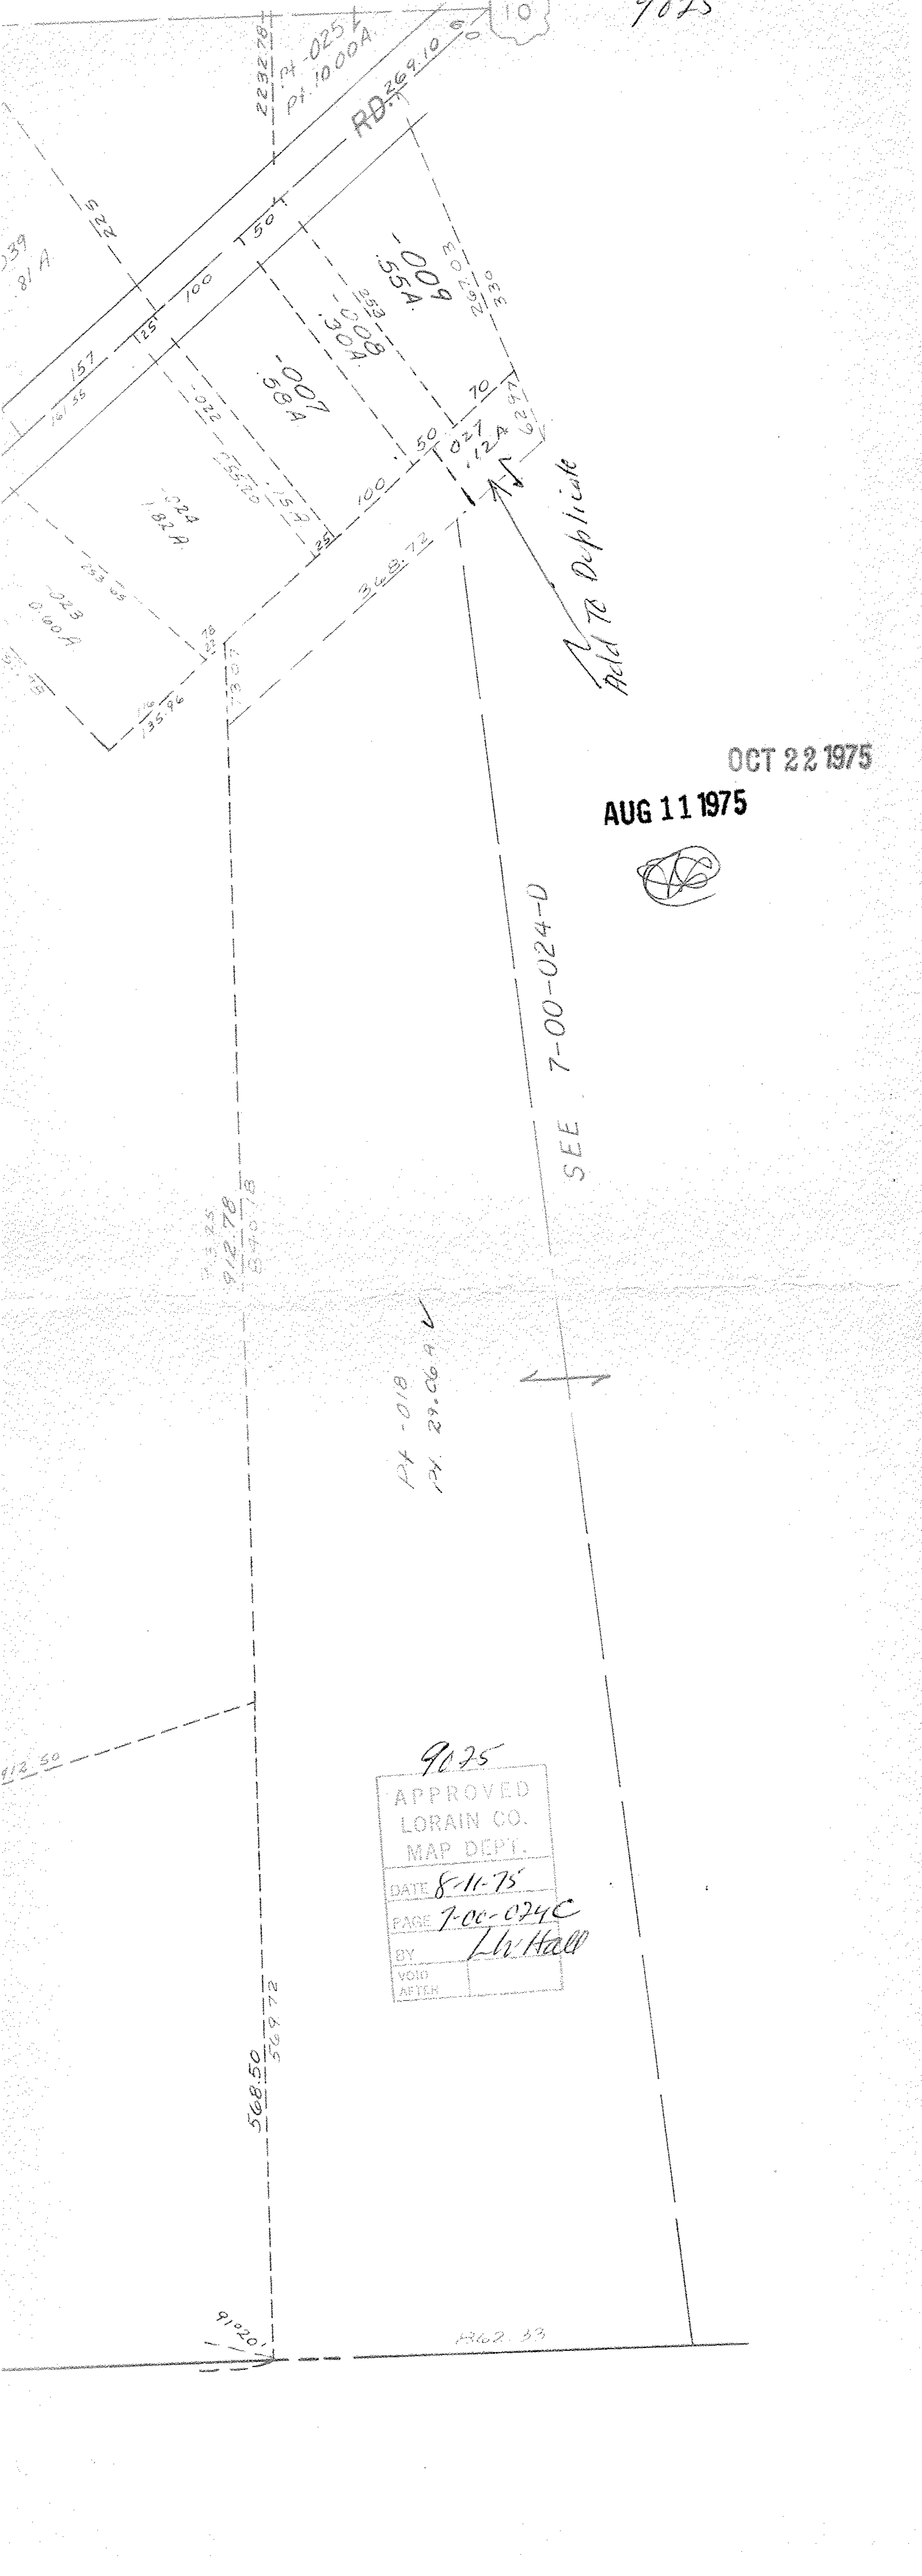
9025
RD.
Pt. 025
Pt. 10.00A.
-009
.55A.
-008
.30A.
-007
.58A.
-022
-024
1.82 A.
-023
0.00A
-027
.12A
Held To Duplicate
OCT 22 1975
AUG 11 1975
SEE 7-00-024-D
Pt. -018
Pt. 29.06 A
568.50
9025
APPROVED
LORAIN CO.
MAP DEPT.
DATE 8-11-75
PAGE 7-00-024C
BY L.W. Hall
VOID
AFTER