


Pt. 11.92 Ac.  
Pt. 05-00-025-109-022

DEC 31 1975  
107

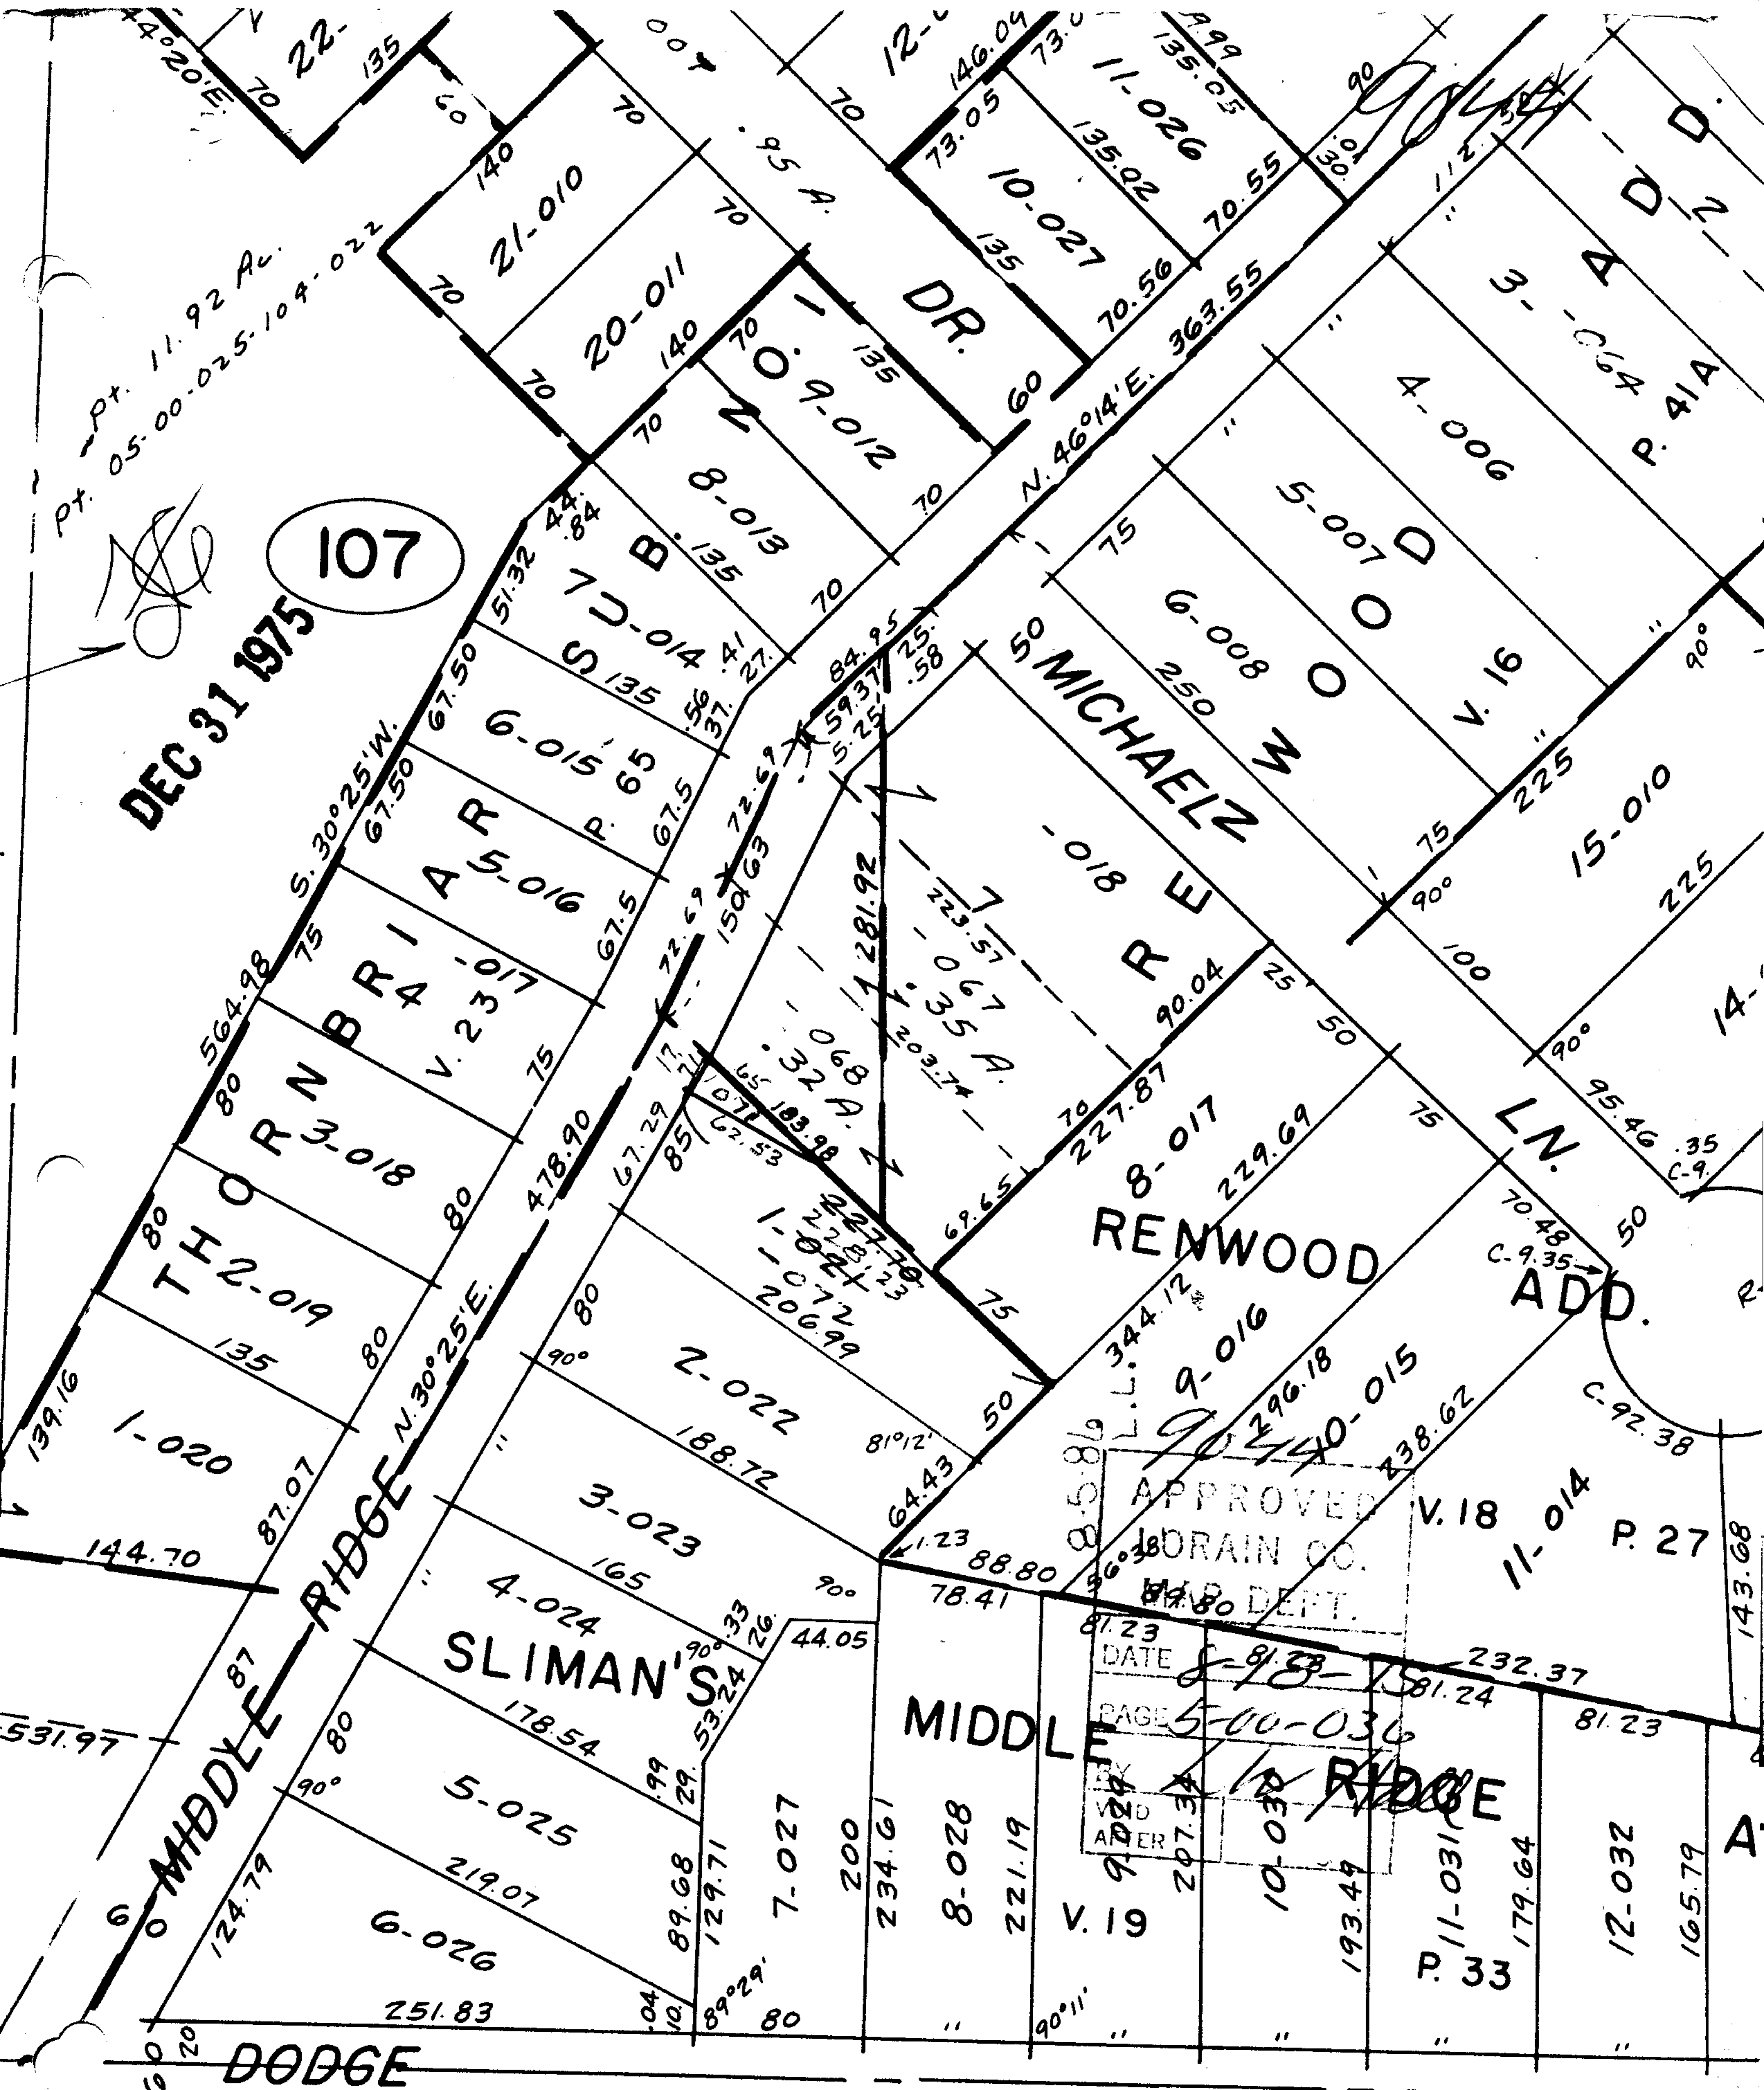

APPROVED  
BORAIN CO.  
MAP DEPT.  
DATE 8-18-75  
PAGE 5-00-036  
BY [Signature]  
V. 19  
207.34  
10-01  
193.49  
P. 11-031  
33  
179.64  
12-032  
165.79

85.00  
- 17.71  
67.29

AUG 19 1975 SEE 5-00-035-A