

-056
2.74A

335

-055
.52A
323

AUG 20 1975

9051

-061
.99A

-074
6.85A

80
7.75
72.25

-067
.68A

30

149
141.25
083
-071
.55A
.52AC

-073
.55A

-069
.52A

DEC 1 1975

-058
5.03A

9051


APPROVED BY	LORAIN CO.
MAP DEPT.	
DATE	8-26-75
PAGE	6-65
BY	L.W. HALL
VOID AFTER	

VILLAGE GREEN


VILLAGE GREEN
VOL. 27
SEE

6-65-A

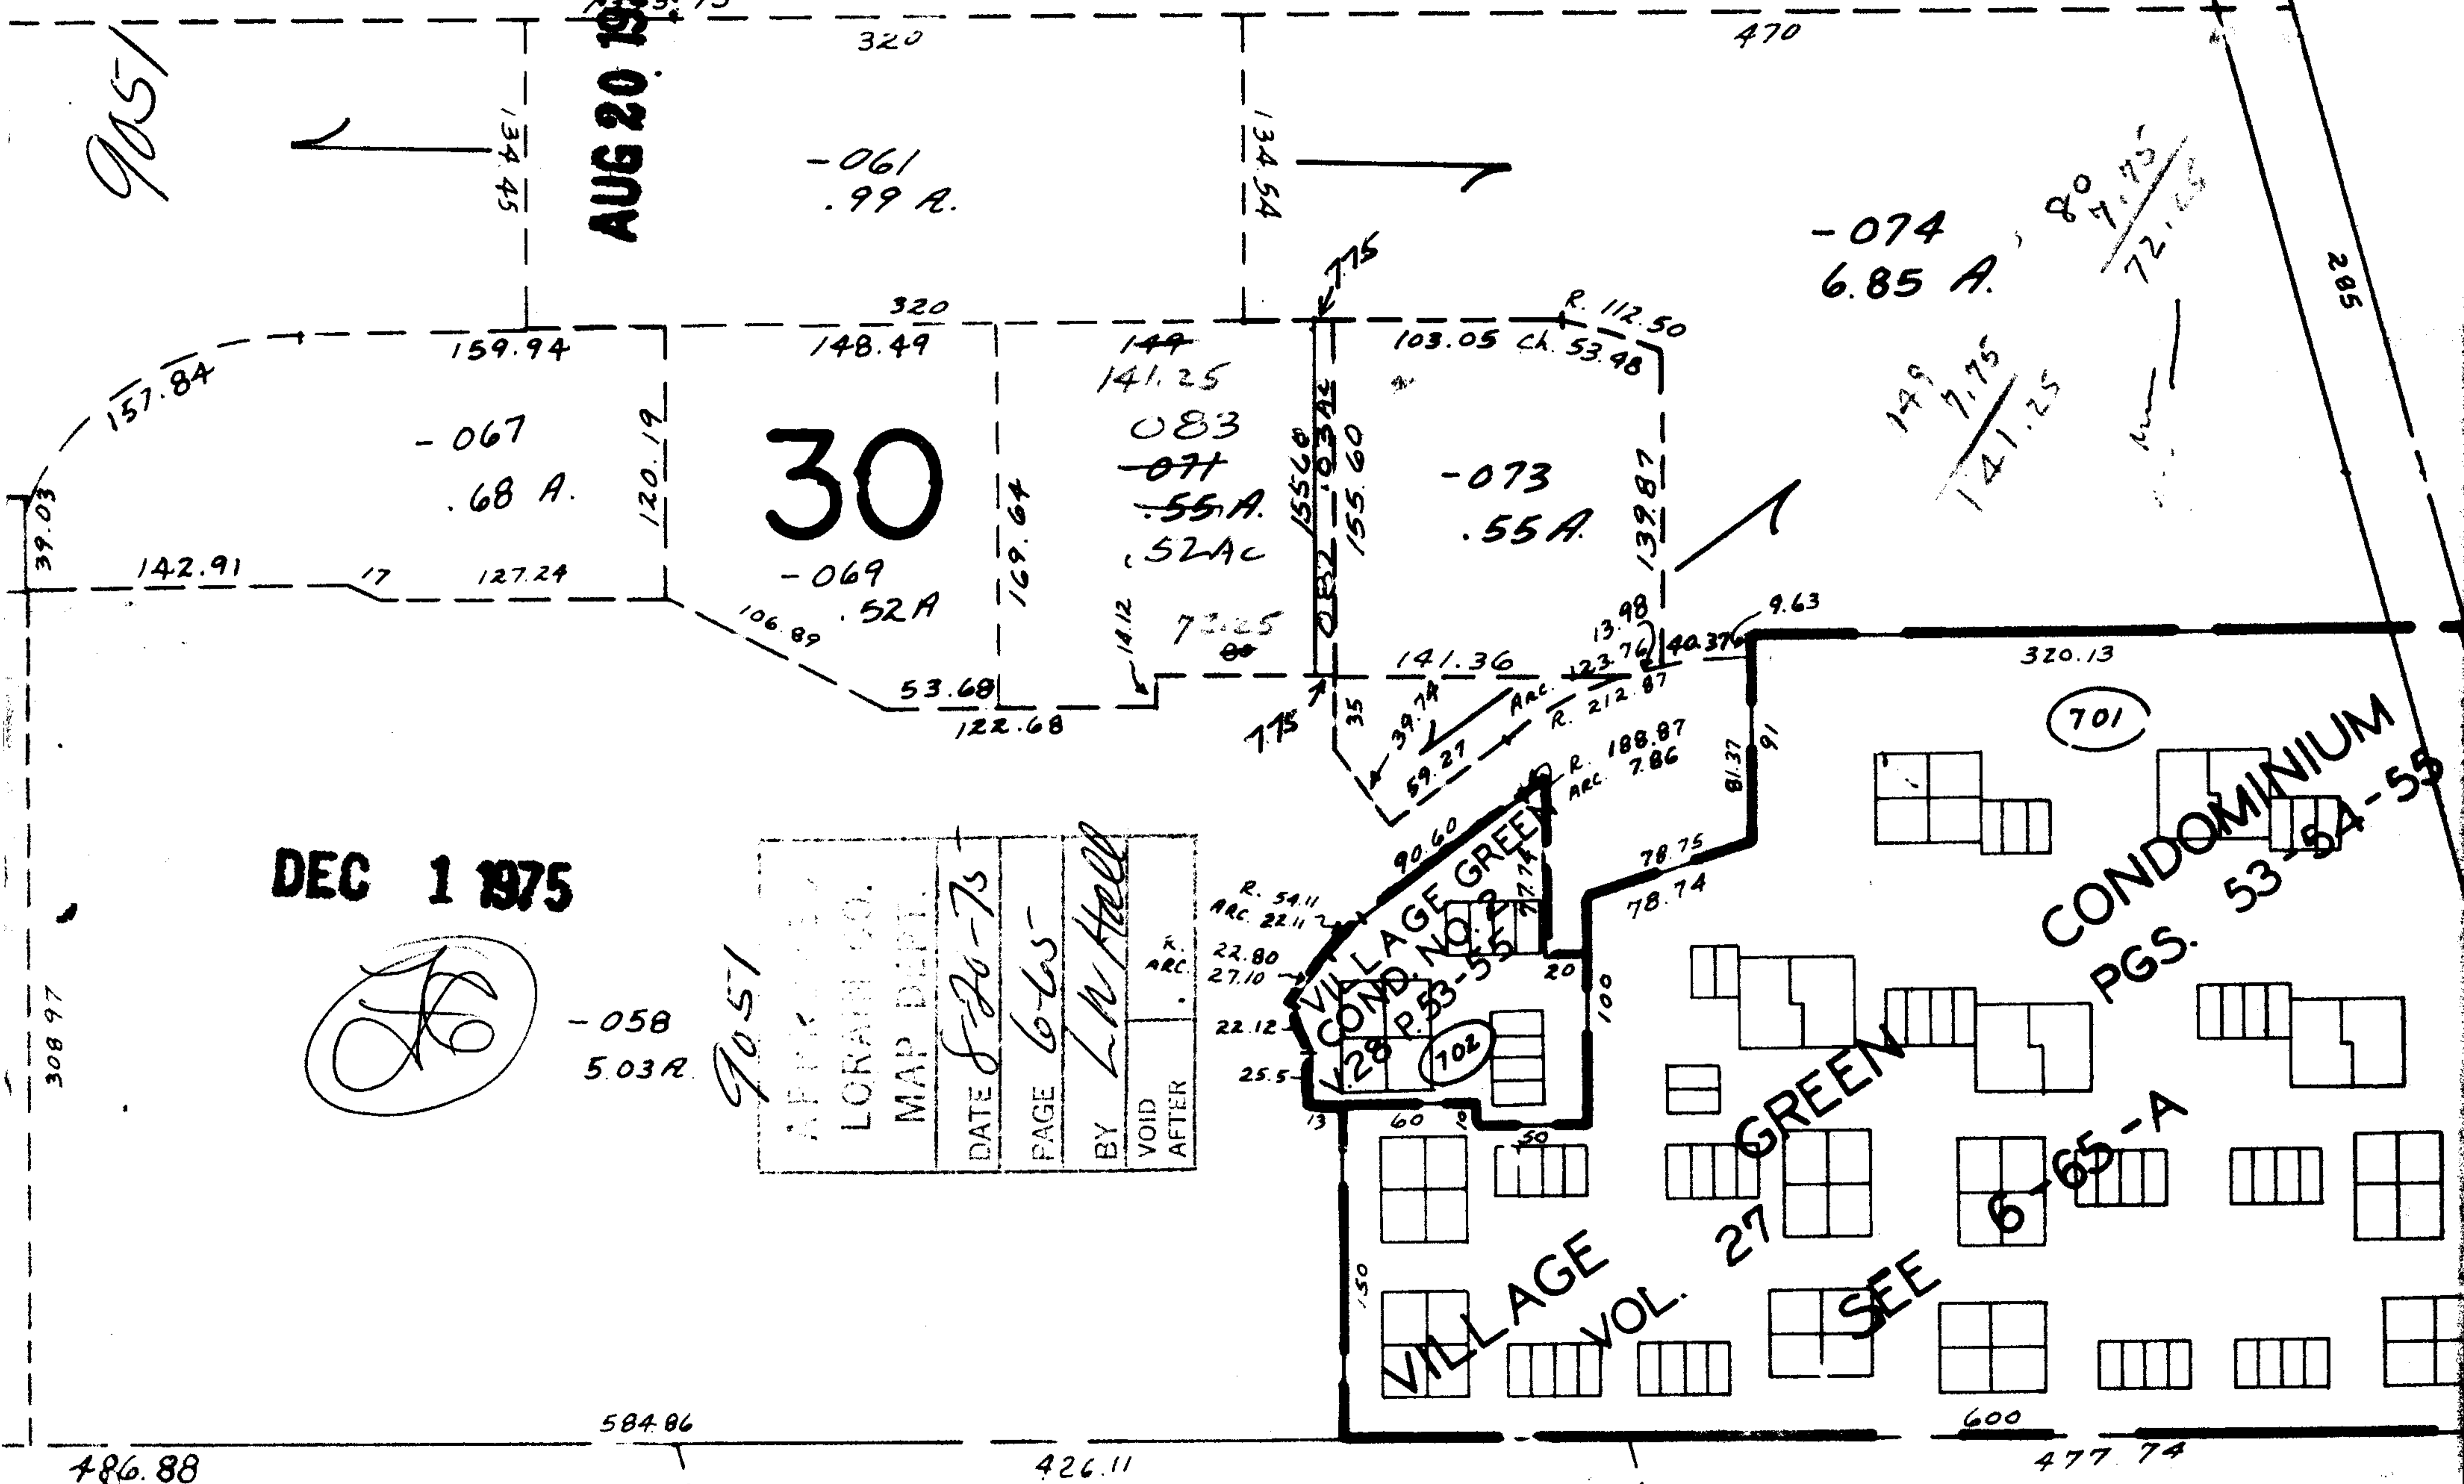

308.97

486.88

584.86

426.11

1390.73

477.74

600

141.36
13.98
123.76
R. 212.87
40.37
9.63
141.25
149
7.75
141.25

R. 54.11
ARC 22.11
22.80
27.10
22.12
25.5

R. 112.50
103.05 Ch. 53.48
139.87
141.25

R. 188.87
ARC 7.86
81.37
91




