


203.37
105.24
98713

263.47
174.65
88.82

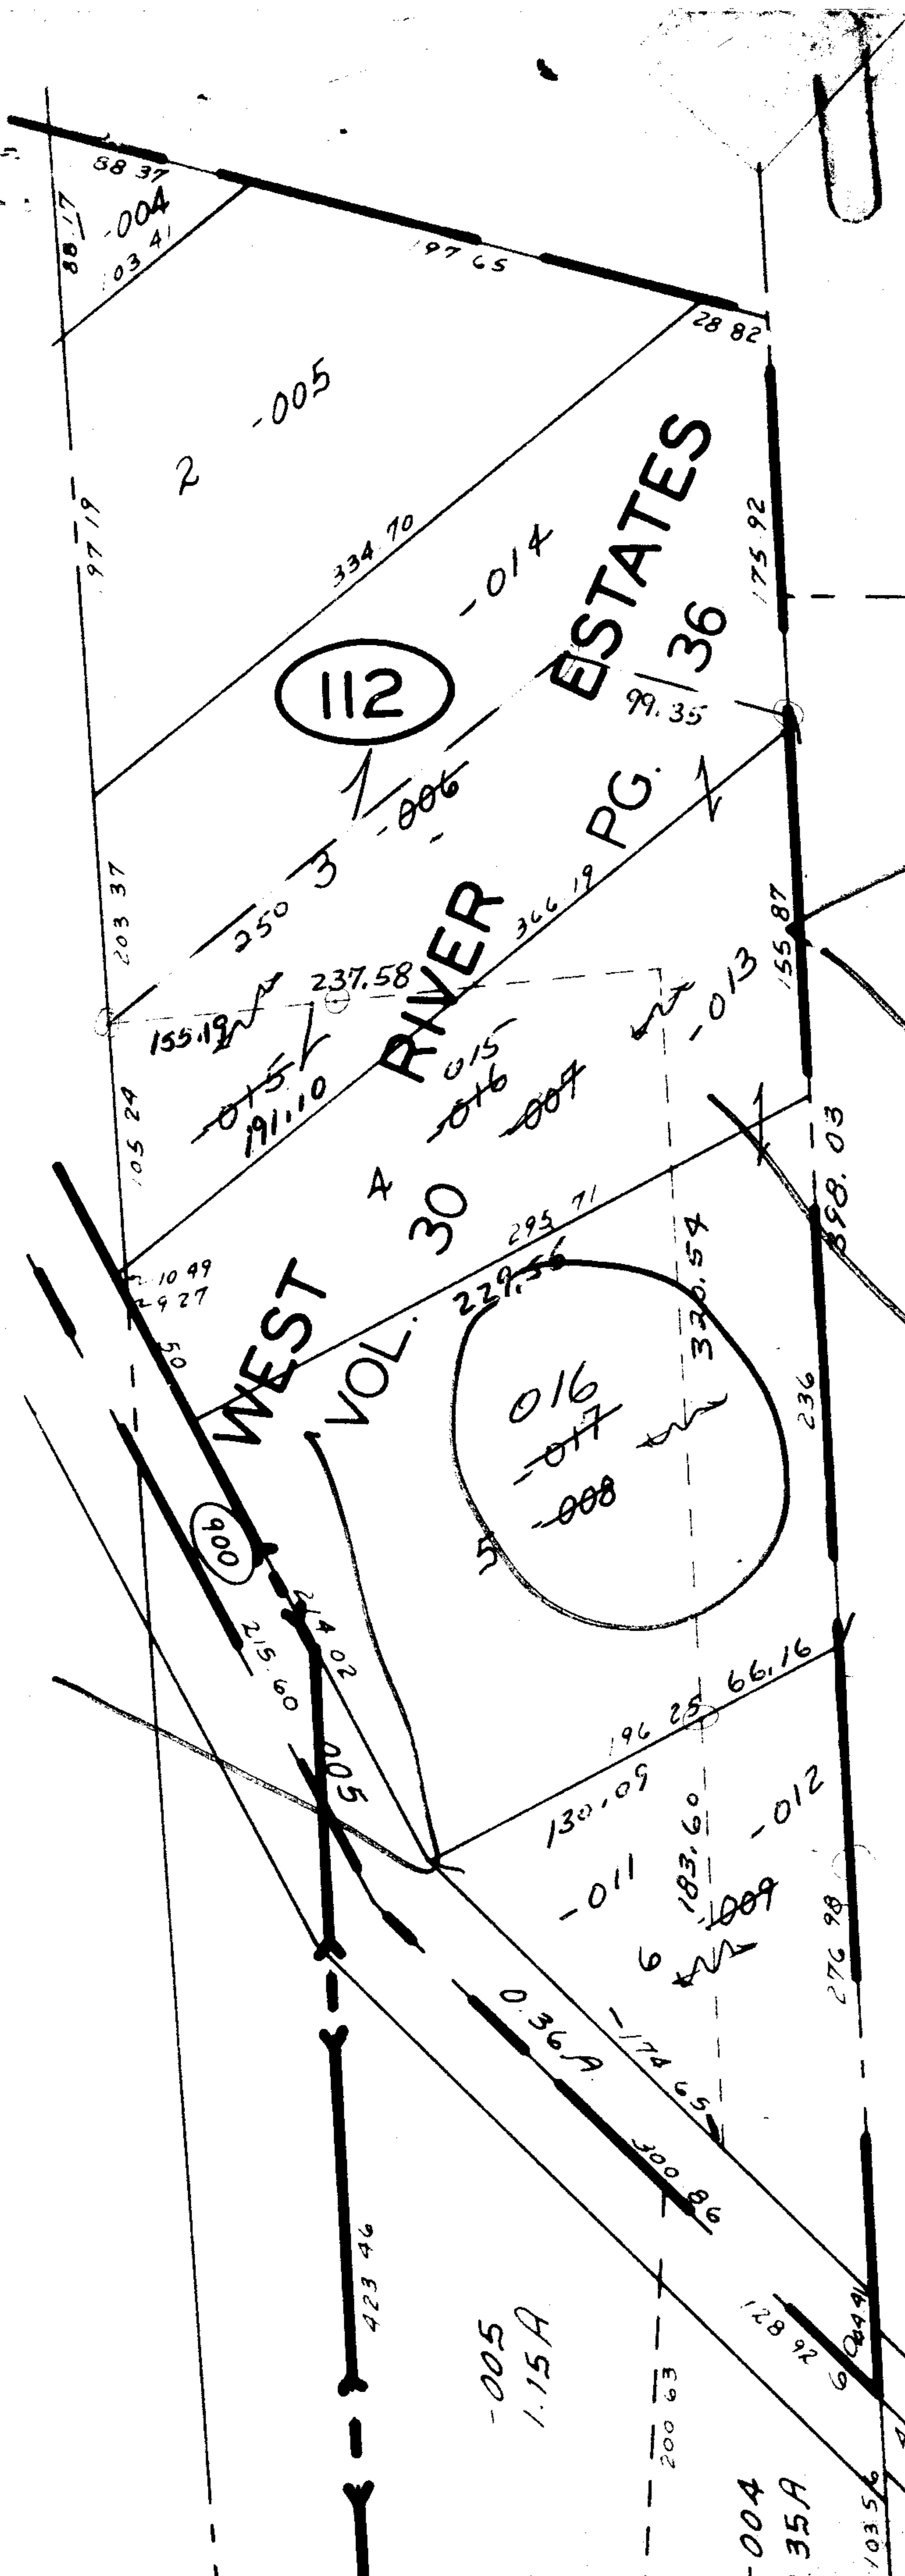

9052
9053

APPROVED
LORAIN CO.
MAP DEPT.

DATE 8-19-75

PAGE 1-00-017A

BY *[Signature]*

VOID
AFTER

Voided
12-16-75

WEST