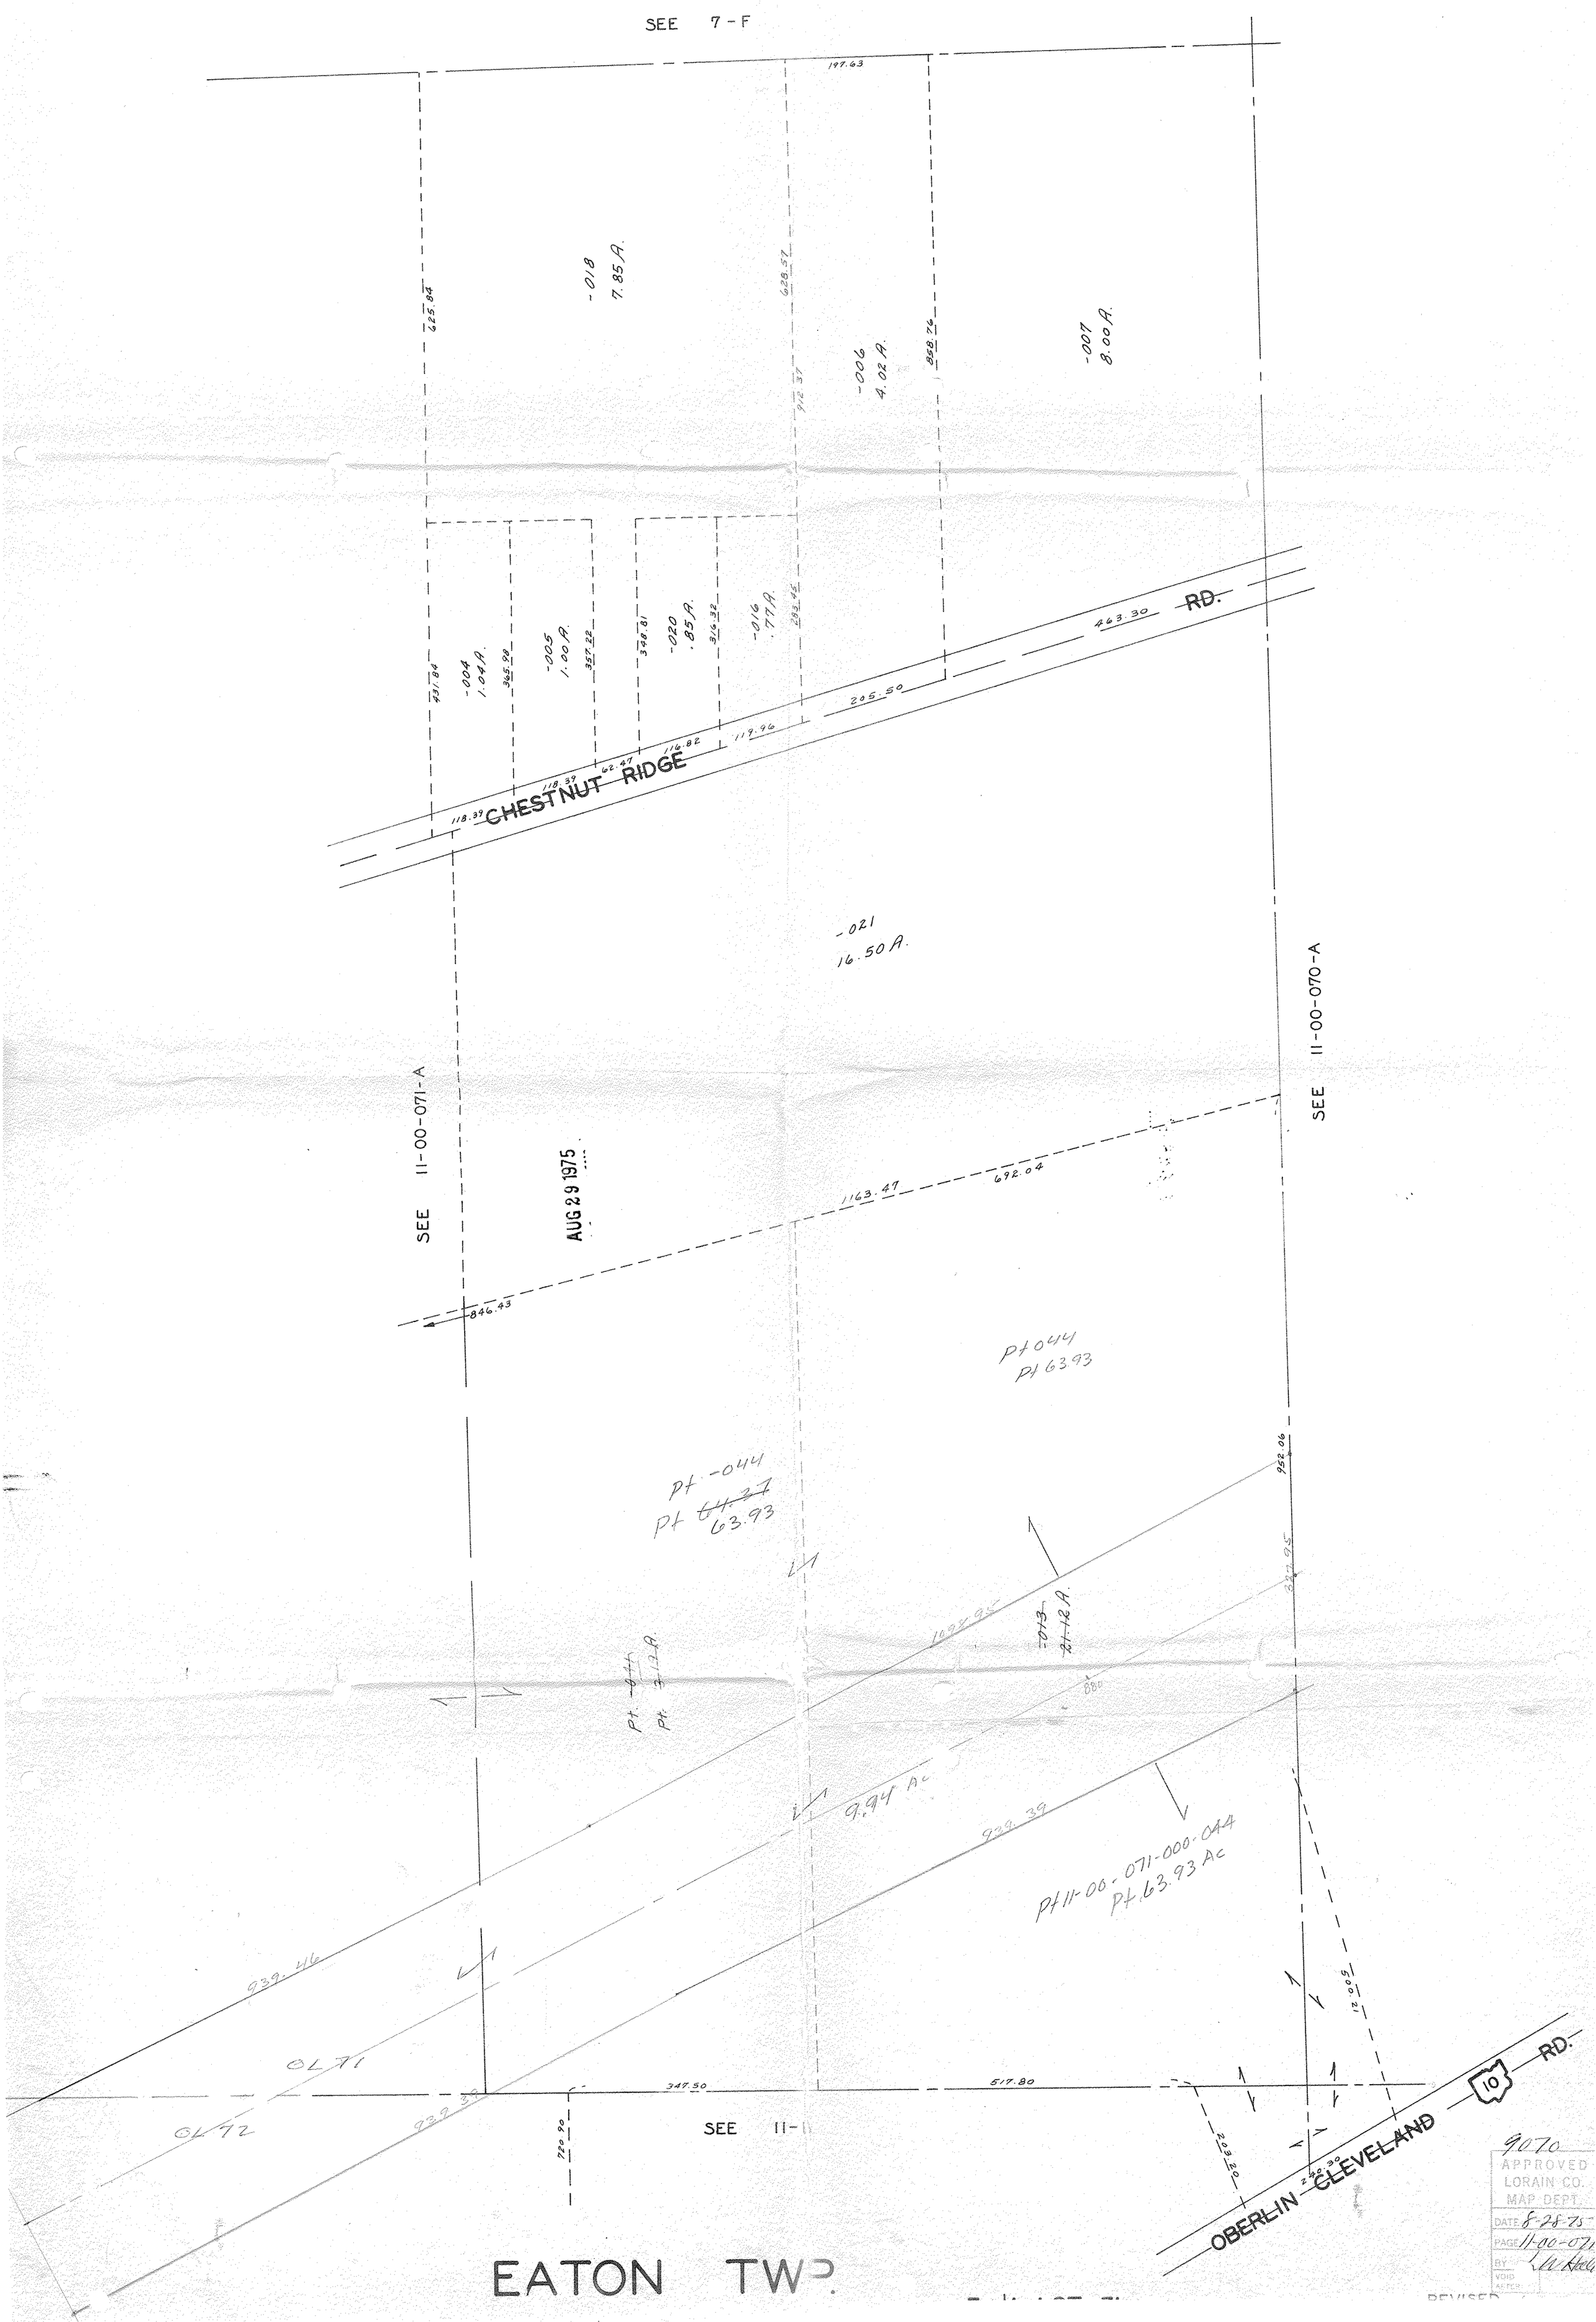
SEE 7-F
197.63
625.84
-018
7.85 A.
628.57
912.37
-006
4.02 A.
858.76
-007
8.00 A.
431.84
-004
1.04 A.
365.98
-005
1.00 A.
357.22
348.81
-020
.85 A.
316.32
-016
.77 A.
283.45
463.30
RD.
CHESTNUT RIDGE
118.39
118.39
62.47
116.82
119.96
205.50
-021
16.50 A.
SEE 11-00-071-A
SEE 11-00-070-A
AUG 29 1975
1163.47
692.04
846.43
Pt 044
Pt 63.93
Pt -044
Pt ~~64.37~~
63.93
952.06
827.95
1002.95
-013
~~21.12~~ A.
880
Pt. ~~-044~~
Pt. ~~3.13~~ A.
9.94 Ac
929.39
Pt 11-00-071-000-044
Pt. 63.93 Ac
939.46
500.21
OL 71
347.50
517.80
OL 72
939.39
720.90
SEE 11-
203.20
240.30
OBERLIN
CLEVELAND
10
RD.
EATON TWP.
9070
APPROVED
LORAIN CO.
MAP DEPT.
DATE 8-28-75
PAGE 11-00-07
BY
VOID
AFTER