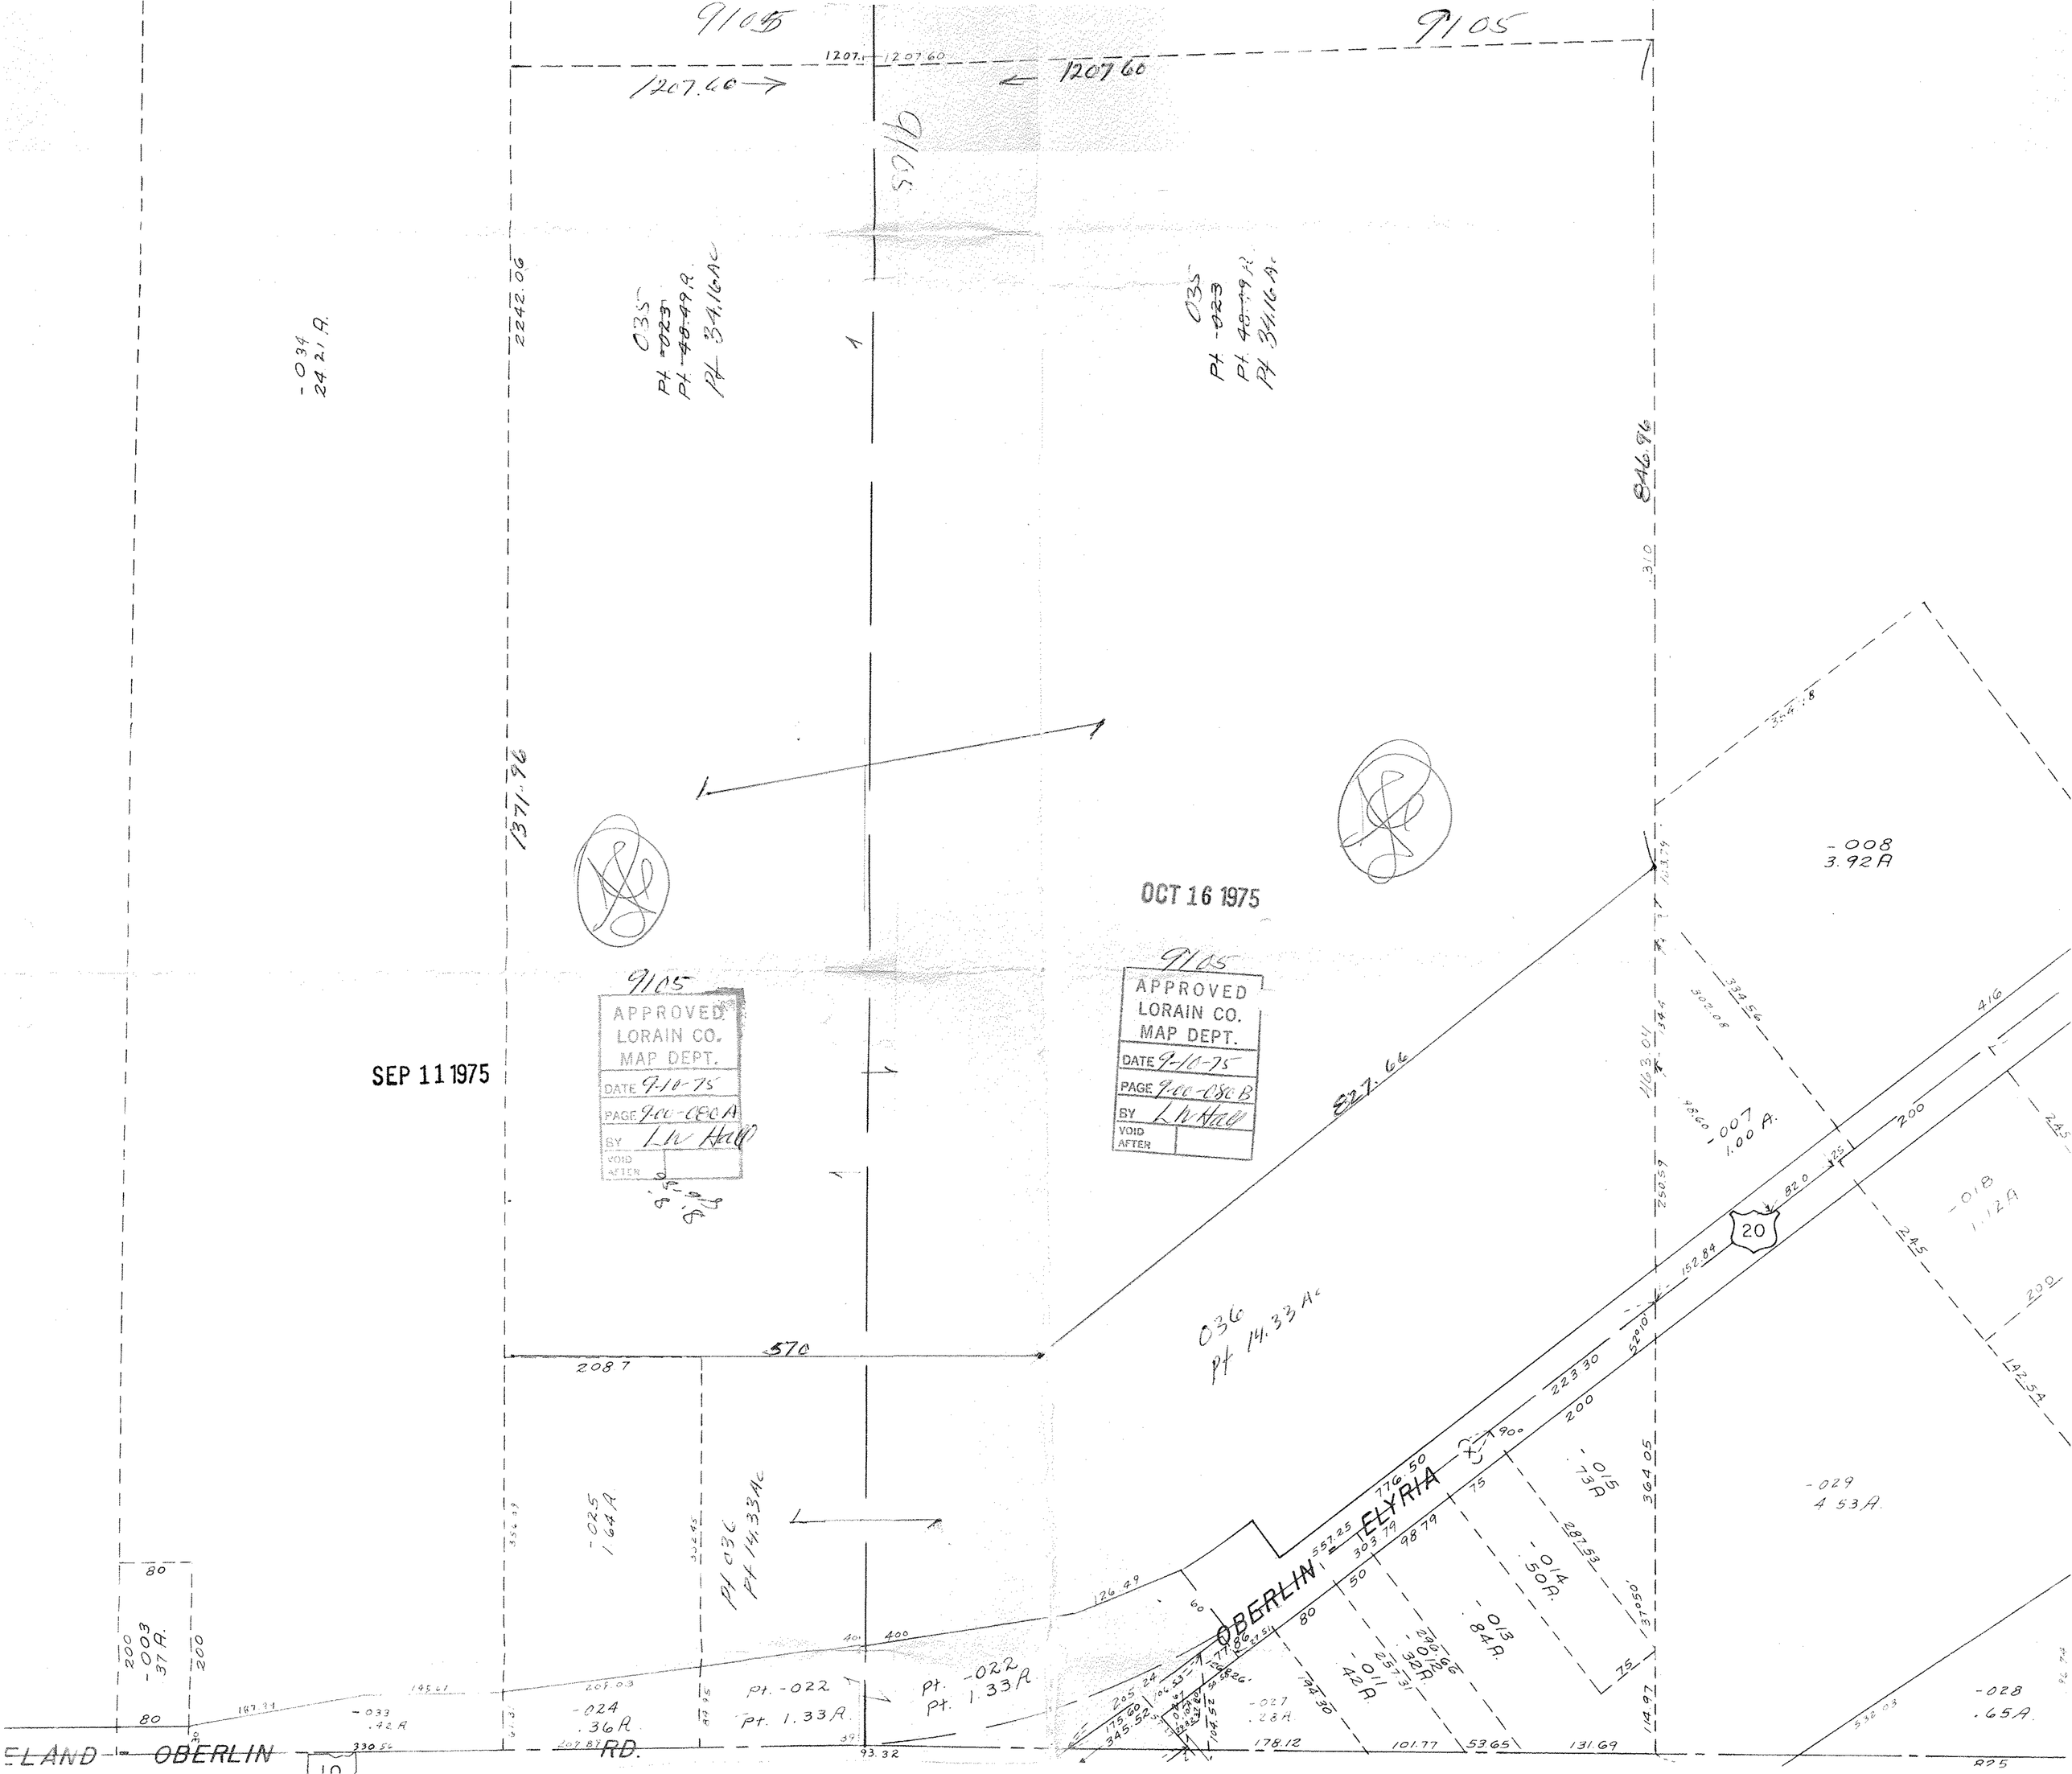

9105
9105
1207.60
1207.60
1207.60
9105
2242.06
035
Pt -023
Pt 48.49 A
Pt 34.16 Ac
035
Pt -023
Pt 48.49 A
Pt 34.16 Ac
-034
24.21 A
846.96
1371.96
-008
3.92 A
OCT 16 1975
9105
APPROVED
LORAIN CO.
MAP DEPT.
DATE 9-10-75
PAGE 9-00-080 A
BY LW Hall
VOID AFTER
9105
APPROVED
LORAIN CO.
MAP DEPT.
DATE 9-10-75
PAGE 9-00-080 B
BY LW Hall
VOID AFTER
SEP 11 1975
827.66
-007
1.00 A
20
-018
1.12 A
036
Pt 14.33 Ac
570
208.7
-025
1.64 A
Pt 036
Pt 14.33 Ac
OBERLIN - ELYRIA
-015
.73 A
-029
4.53 A
-014
.50 A
-013
.84 A
-011
.42 A
-012
.32 A
-024
.36 A
Pt. -022
Pt. 1.33 A
Pt. -022
Pt. 1.33 A
-028
.65 A
-003
.37 A
ELAND - OBERLIN RD.
10