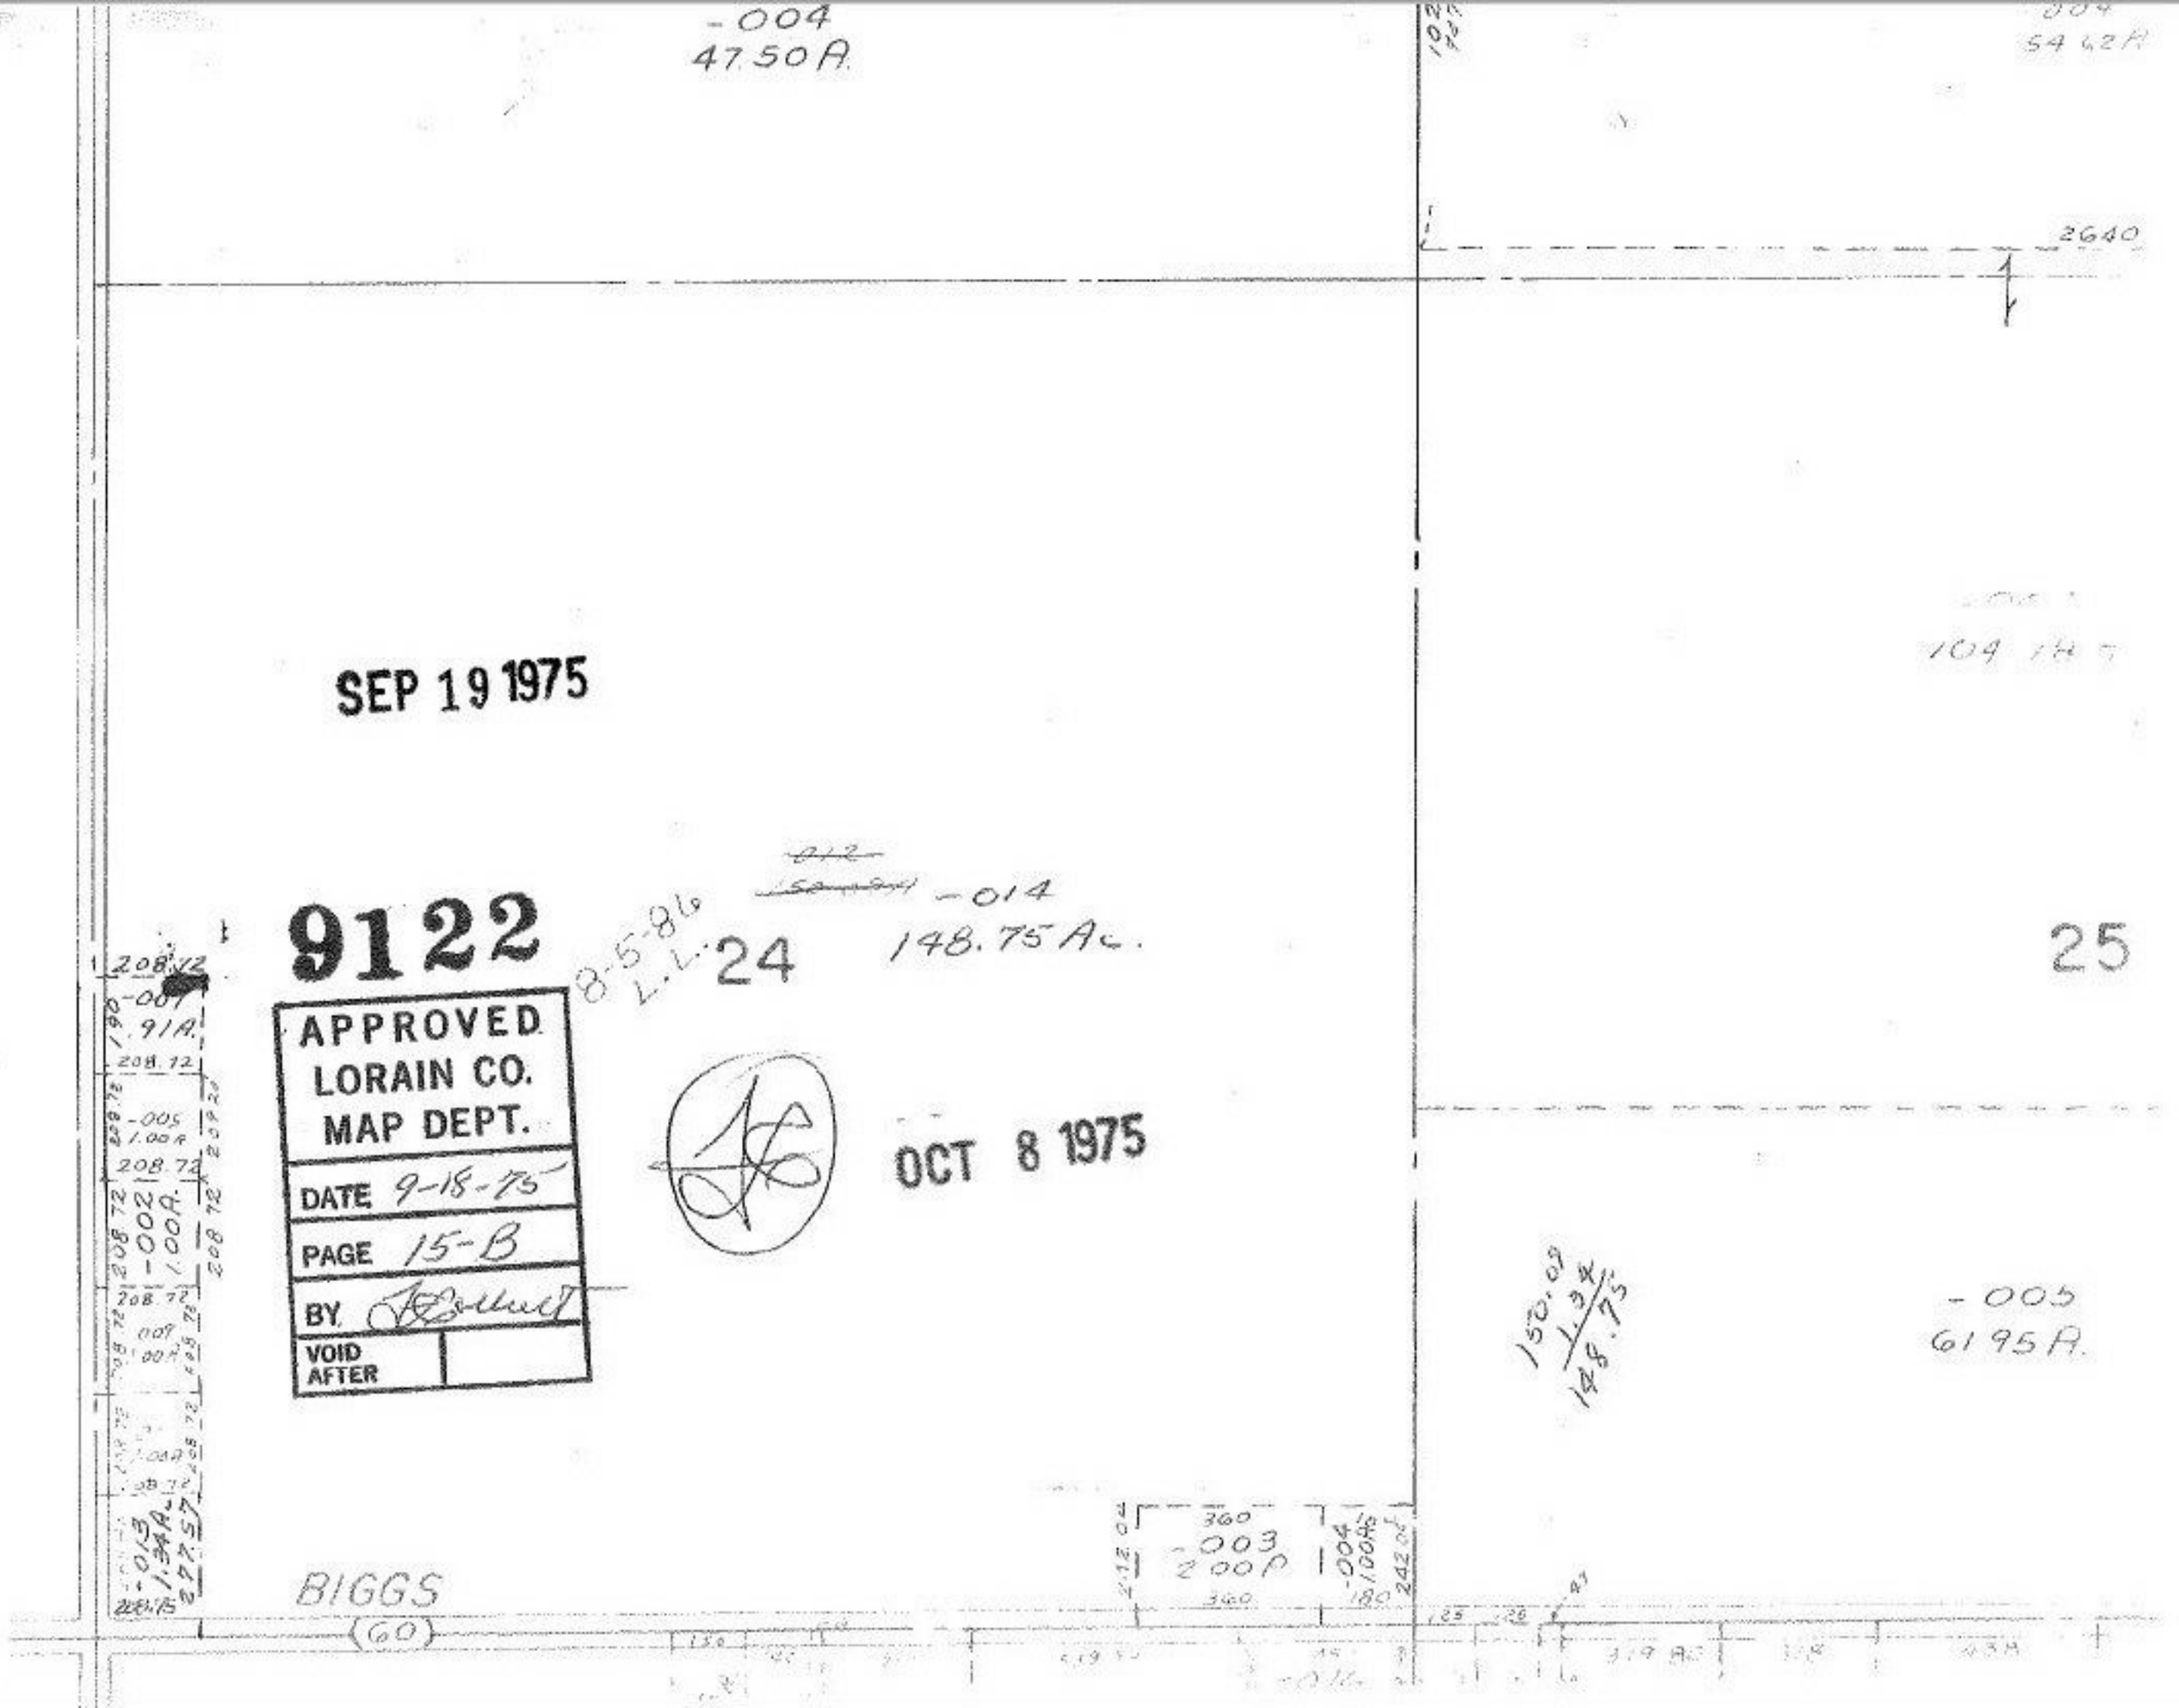
-004
47.50A.
2640
SEP 19 1975
9122
APPROVED
LORAIN CO.
MAP DEPT.
DATE 9-18-75
PAGE 15-B
BY
VOID AFTER
8-5-86
L.L.
24
-014
148.75 Ac.
25
OCT 8 1975
-005
6195A.
150.09
1.34
148.75
-003
2.00A
BIGGS
(60)