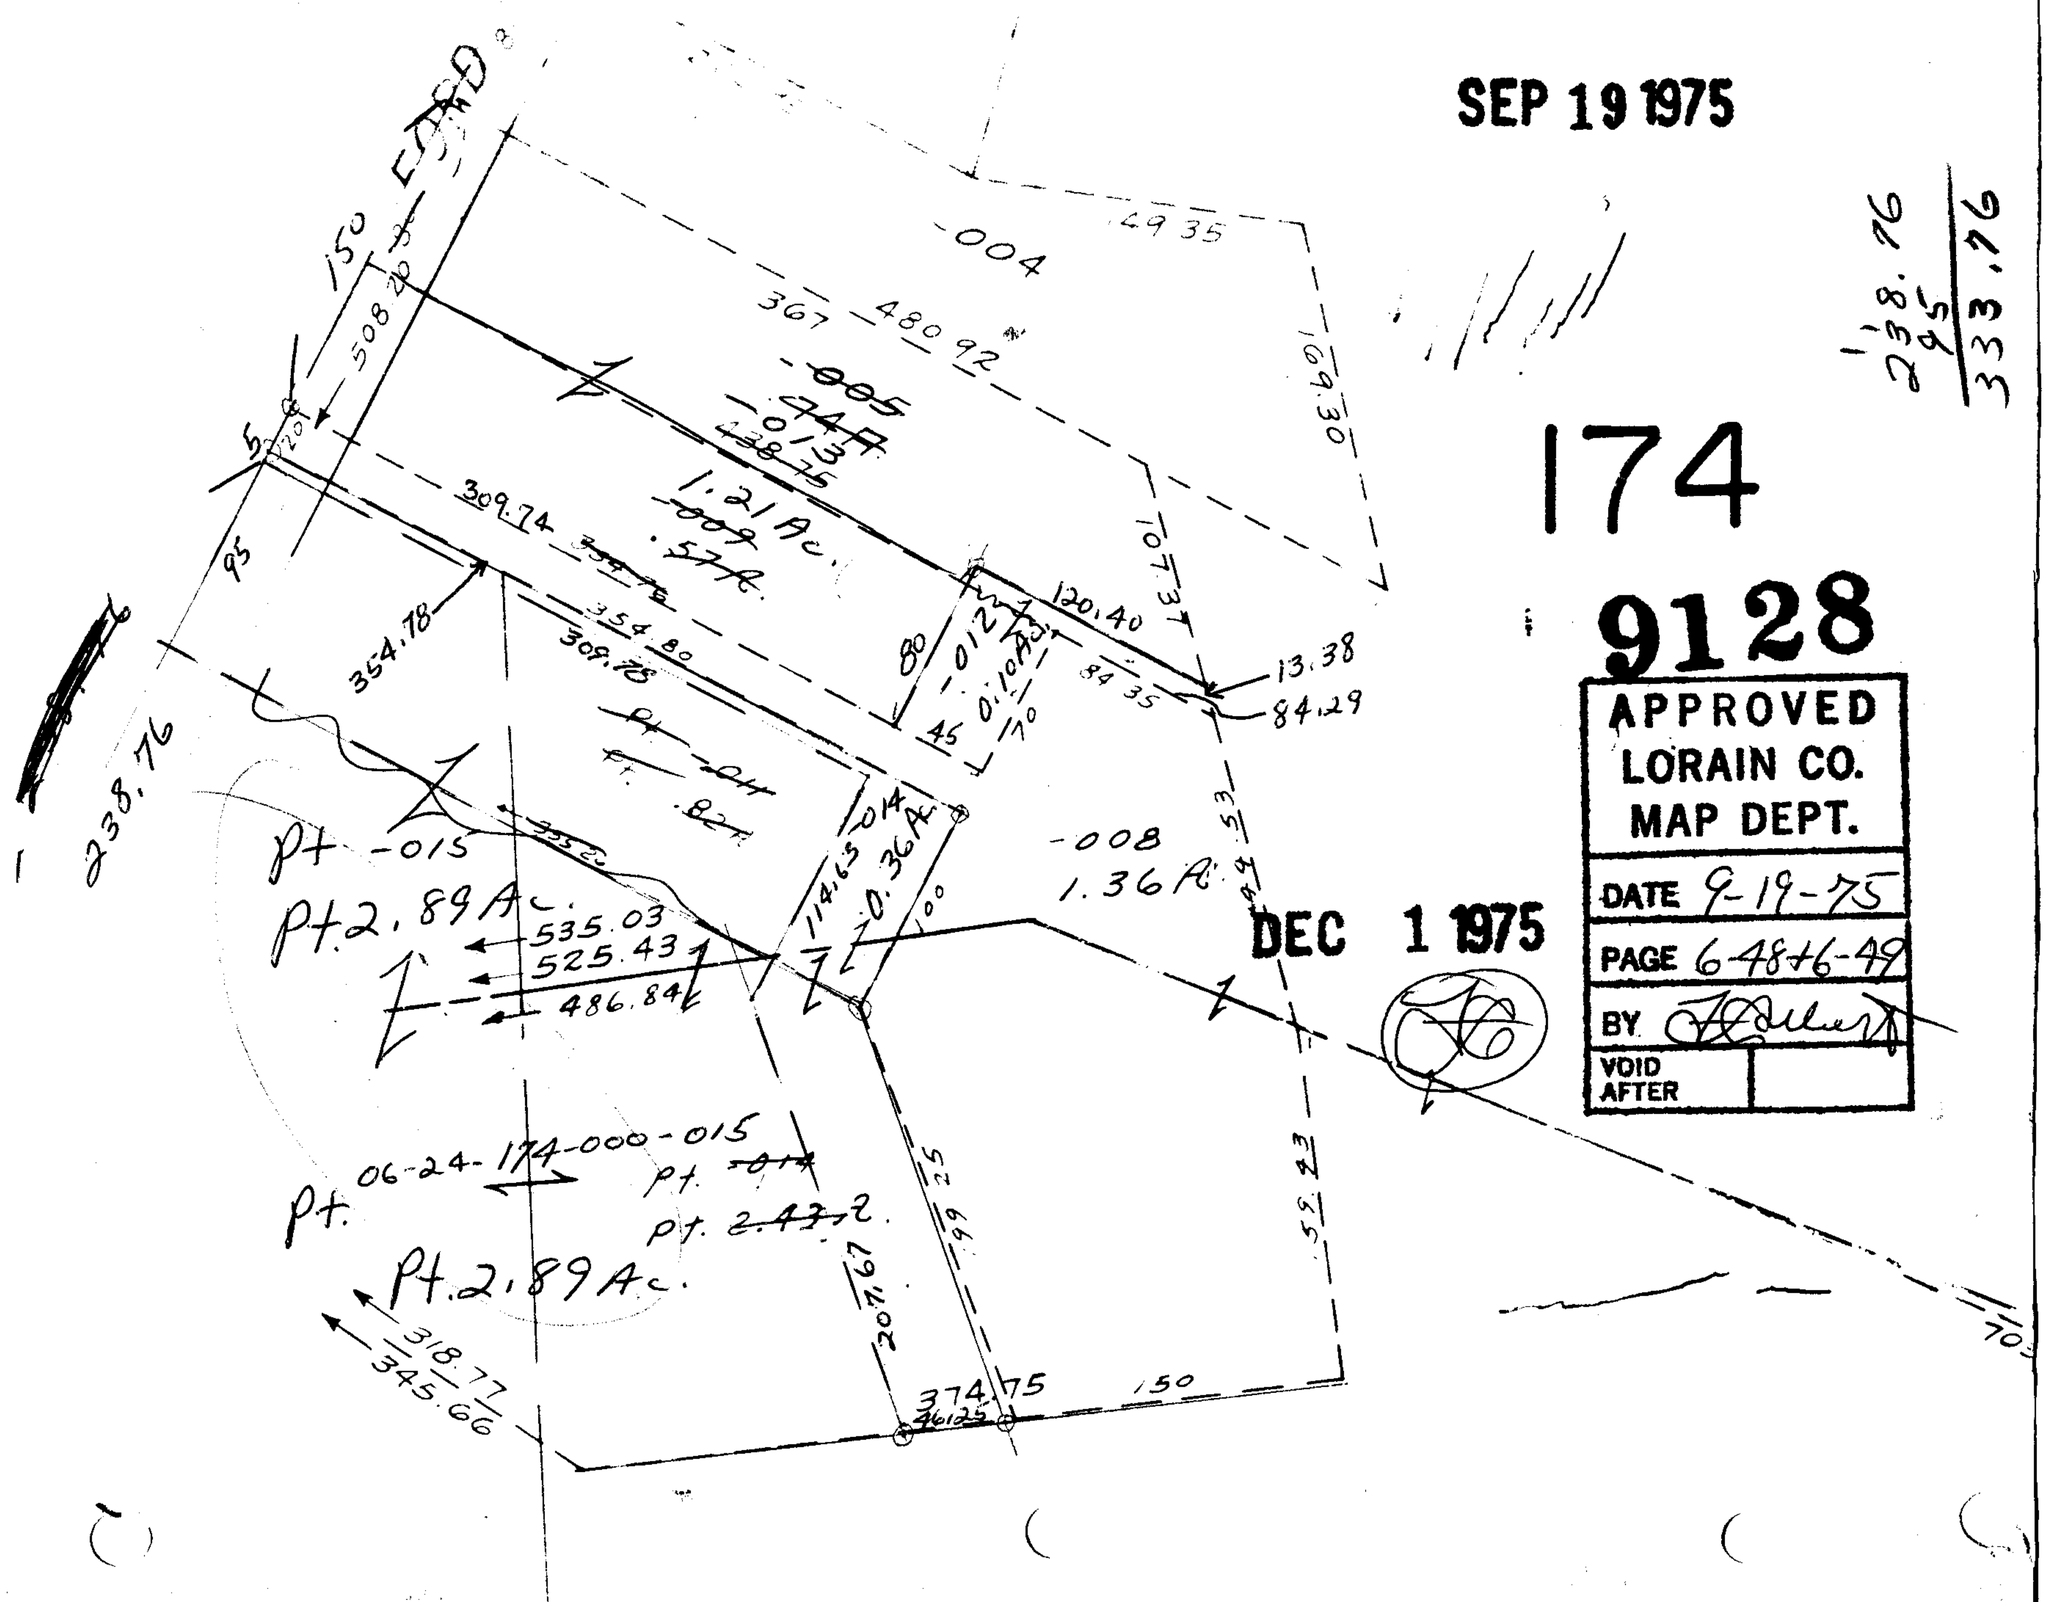

SEP 19 1975
174
9128
APPROVED
LORAIN CO.
MAP DEPT.
DATE 9-19-75
PAGE 6-48+6-49
BY
VOID AFTER
DEC 1 1975
238.76
95
333.76
-004
367
480.92
149.35
169.30
-005
-013
1.21 Ac.
-009
.57 A.
309.74
354.78
354.80
309.78
120.40
107.37
13.38
84.29
84.35
80
45
70
-012
0.10 Ac.
-008
1.36 Ac.
114.65
-014
0.36 Ac.
100
Pt -015
Pt. 2.89 Ac.
535.03
525.43
486.84
238.76
95
150
508.20
06-24-174-000-015
Pt. 2.89 Ac.
318.77
345.66
207.67
99.25
59.43
374.75
46.25
150