SEP 29 1975

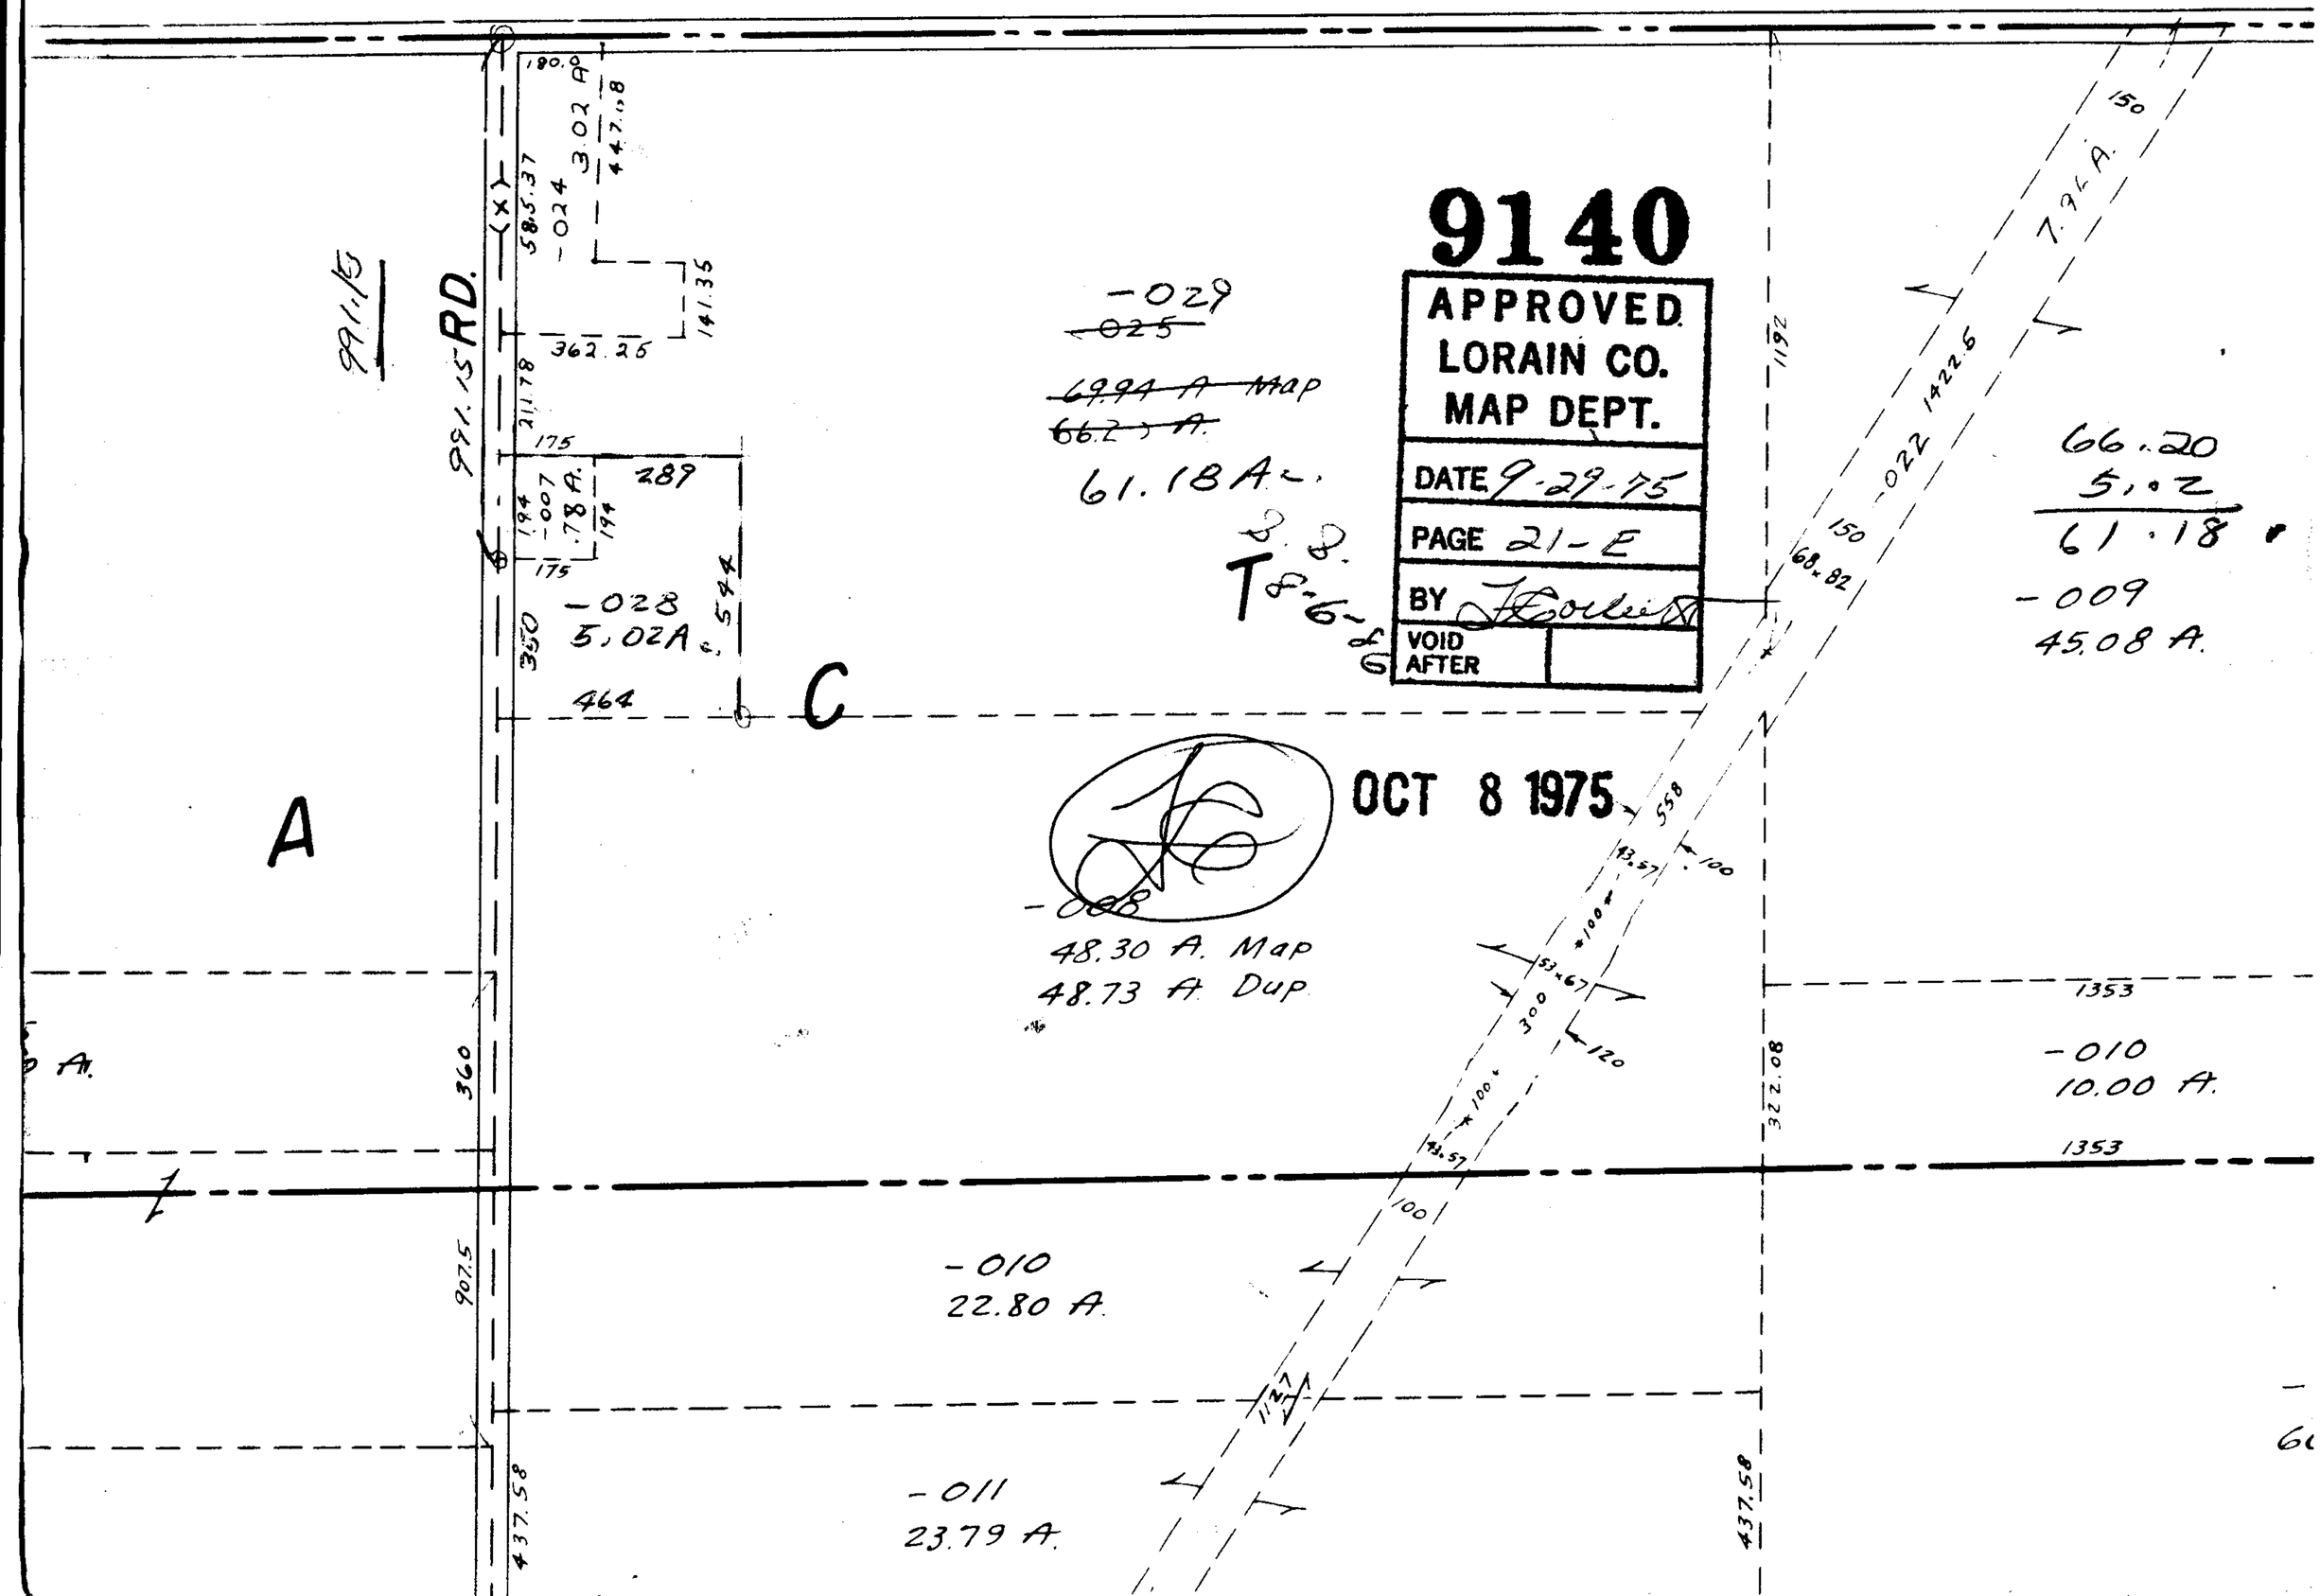

9140
APPROVED
LORAIN CO.
MAP DEPT.
DATE 9-29-75
PAGE 21-E
BY
VOID AFTER
OCT 8 1975
991.15 RD.
991.15
-029
~~-025~~
~~69.94 A Map~~
~~66.2 A.~~
61.18 A.
-028
5.02 A.
-008
48.30 A. Map
48.73 A. Dup
-010
22.80 A.
-011
23.79 A.
-010
10.00 A.
-009
45.08 A.
66.20
5.02
61.18
A
C
T