


OCT 2 1975

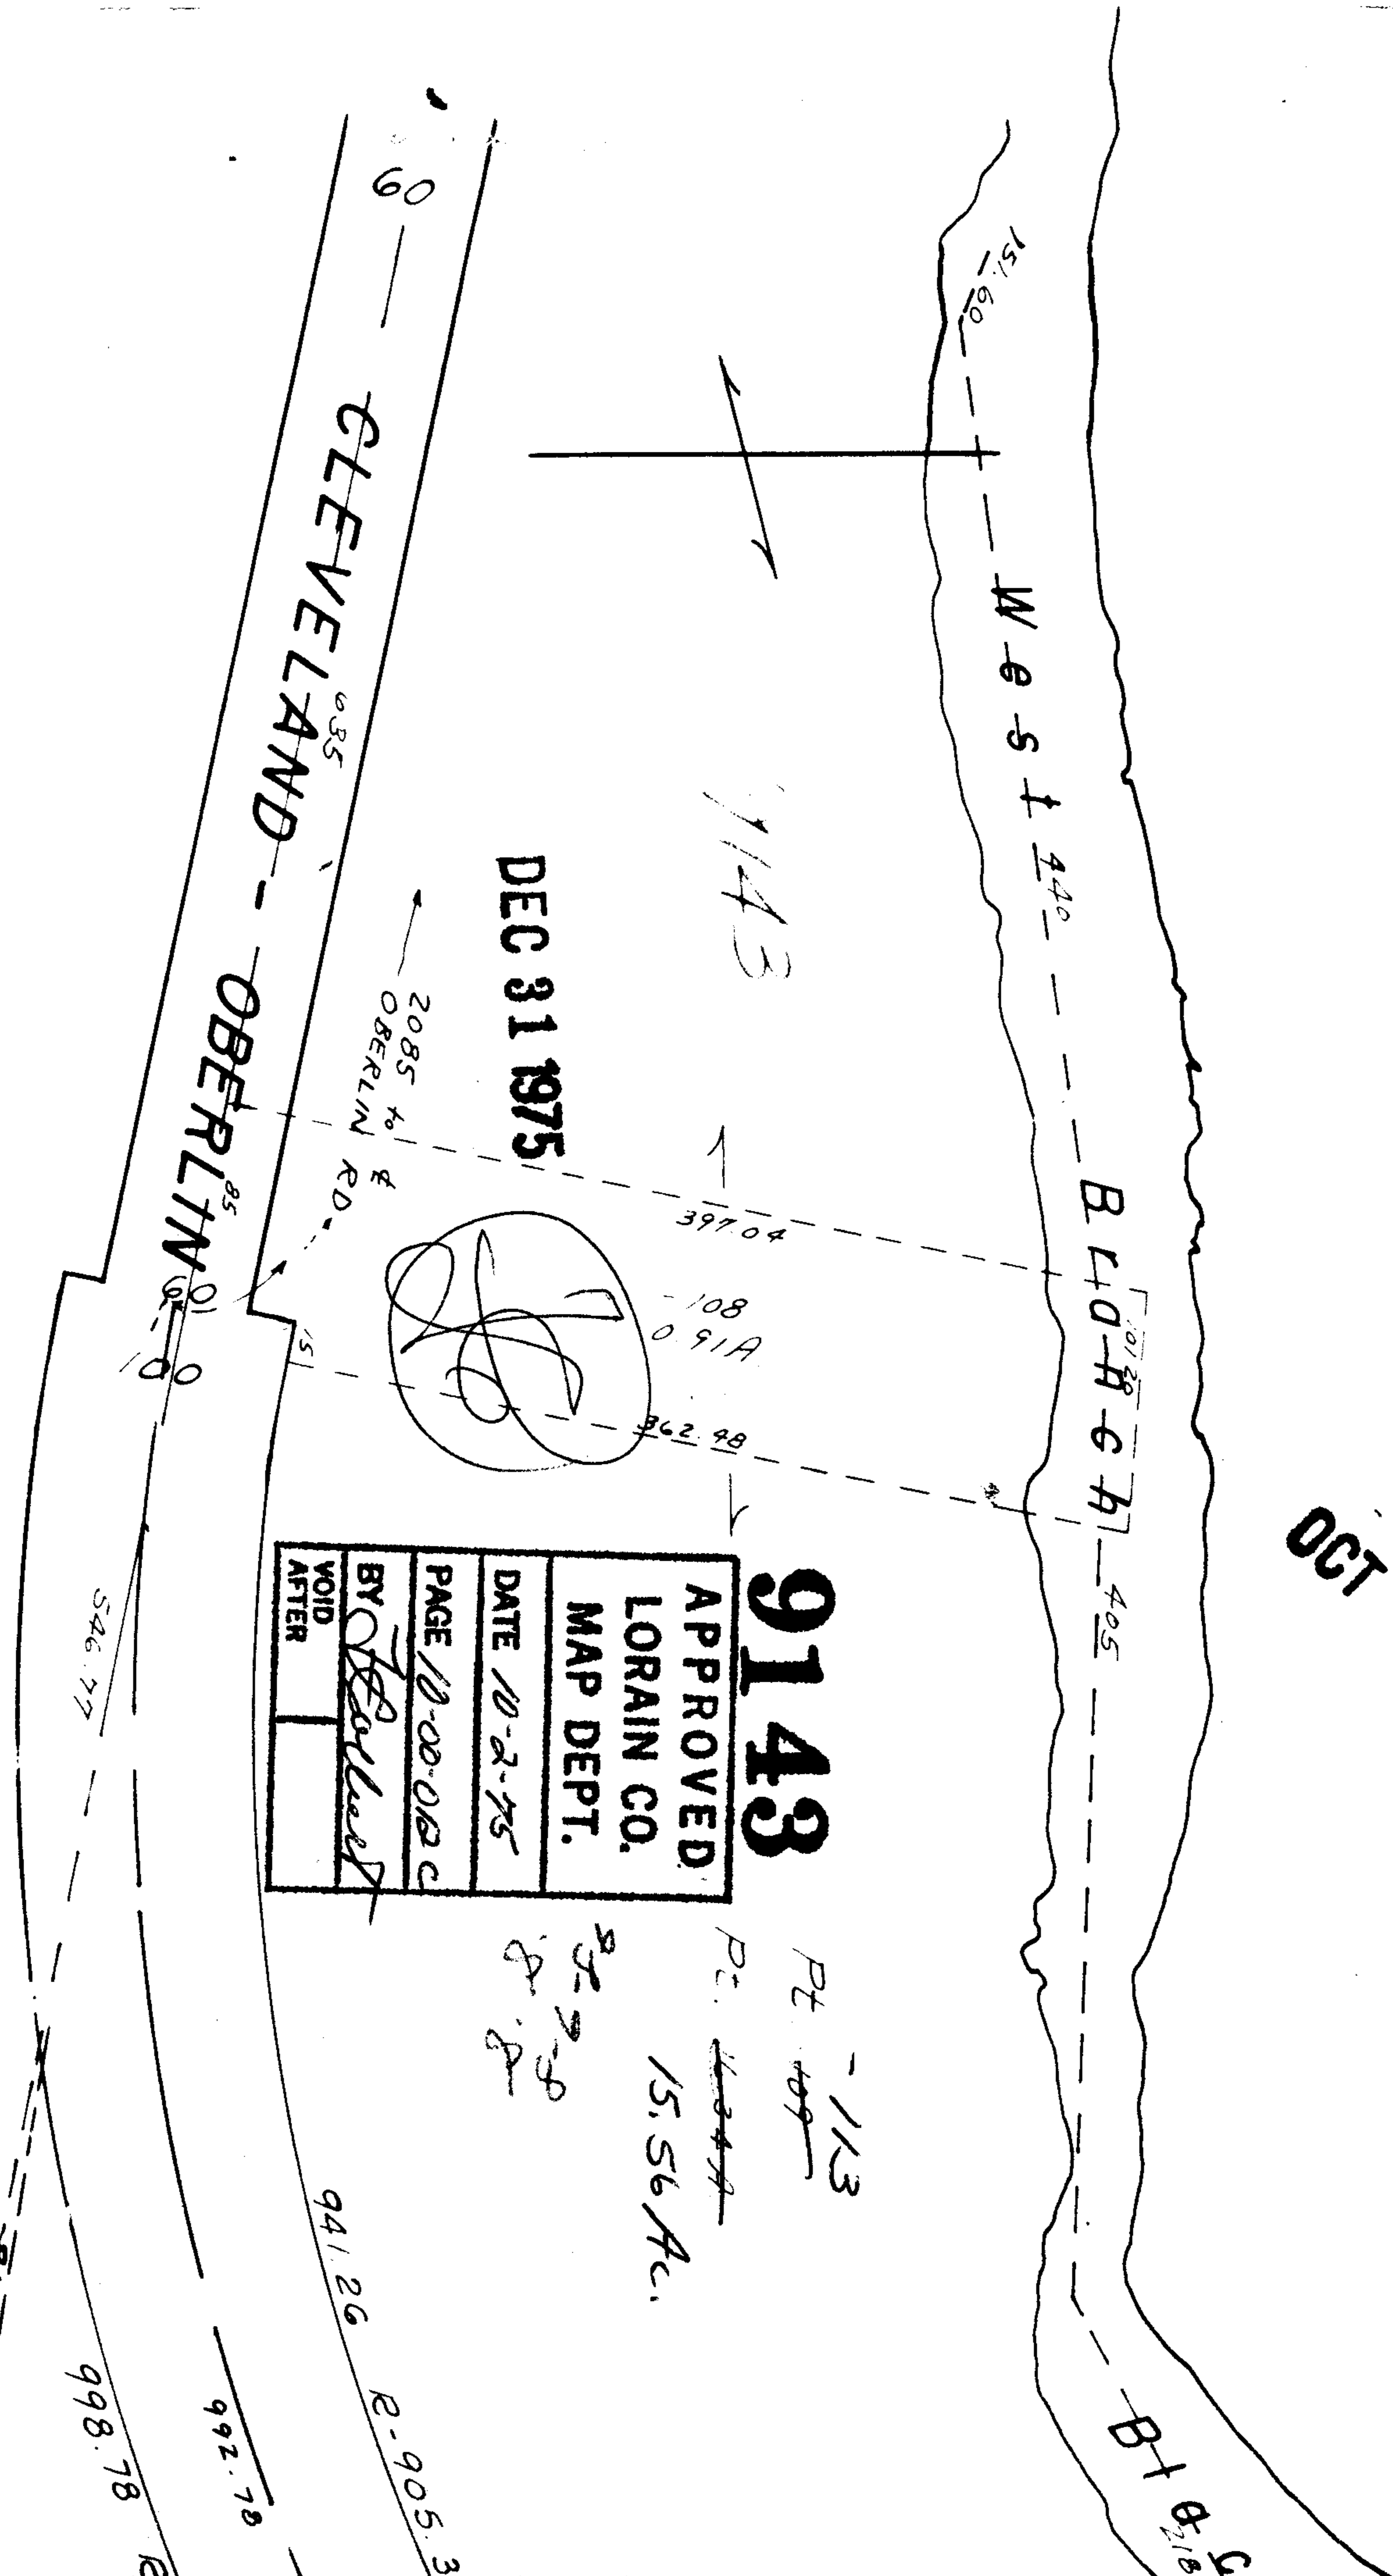

DEC 31 1975

1143

9143	
APPROVED	
LORAIN CO.	
MAP DEPT.	
DATE	10-2-75
PAGE	10-00-012 C
BY	<i>[Signature]</i>
VOID	
AFTER	

9143

APPROVED
LORAIN CO.
MAP DEPT.

DATE 10-2-75

PAGE 10-00-012 C

BY *[Signature]*

VOID

AFTER

Pt. ~~109~~ 113

15.56 Ac.

[Handwritten notes]

SEE 10-00-012-
[Handwritten numbers]