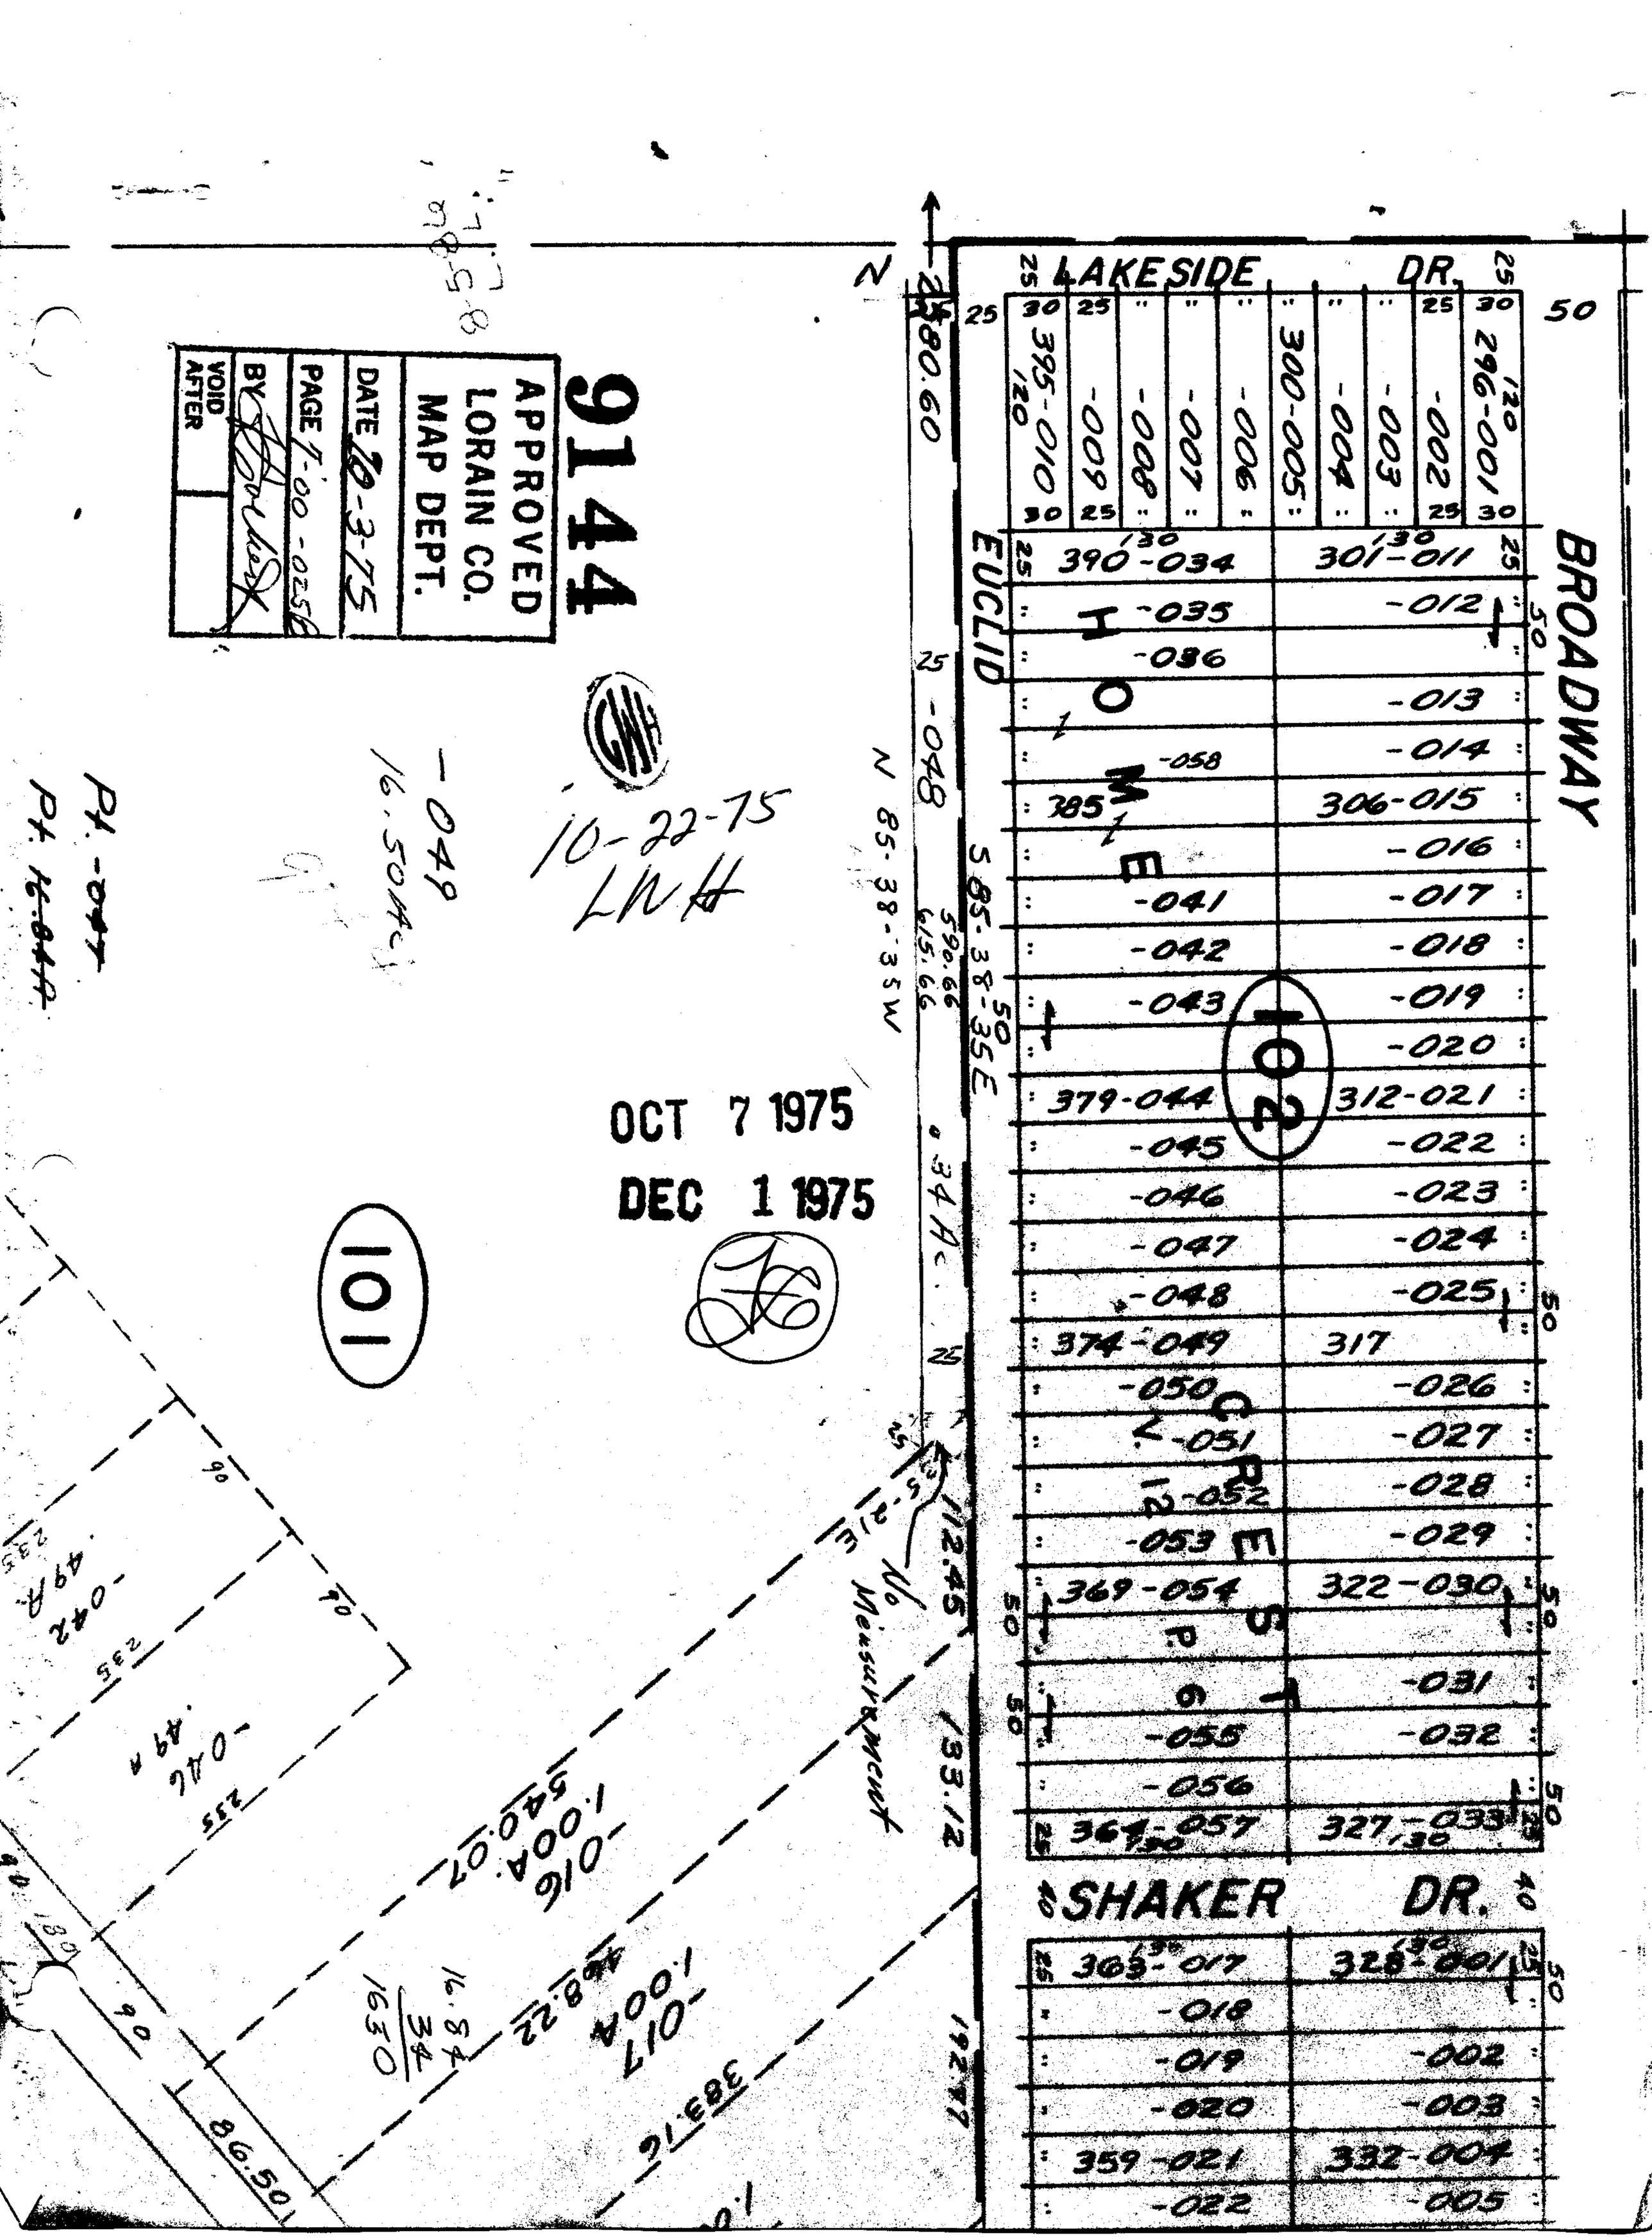

APPROVED
LORAIN CO.
MAP DEPT.
9144
DATE 10-3-75
PAGE 7-00-025
BY
VOID AFTER

10-22-75
LWH

OCT 7 1975
DEC 1 1975

-049
16.50 Ac

Pt. -047
Pt. 16.84A