9155

OCT 7 1975

9155

07-00-024-101-049
.09 Ac

DEC 1 1975

9155

APPROVED
LORAIN CO.
MAP DEPT.
DATE 10-3-75
PAC 07-00-024
BY LH Hall
VOID
AFTER
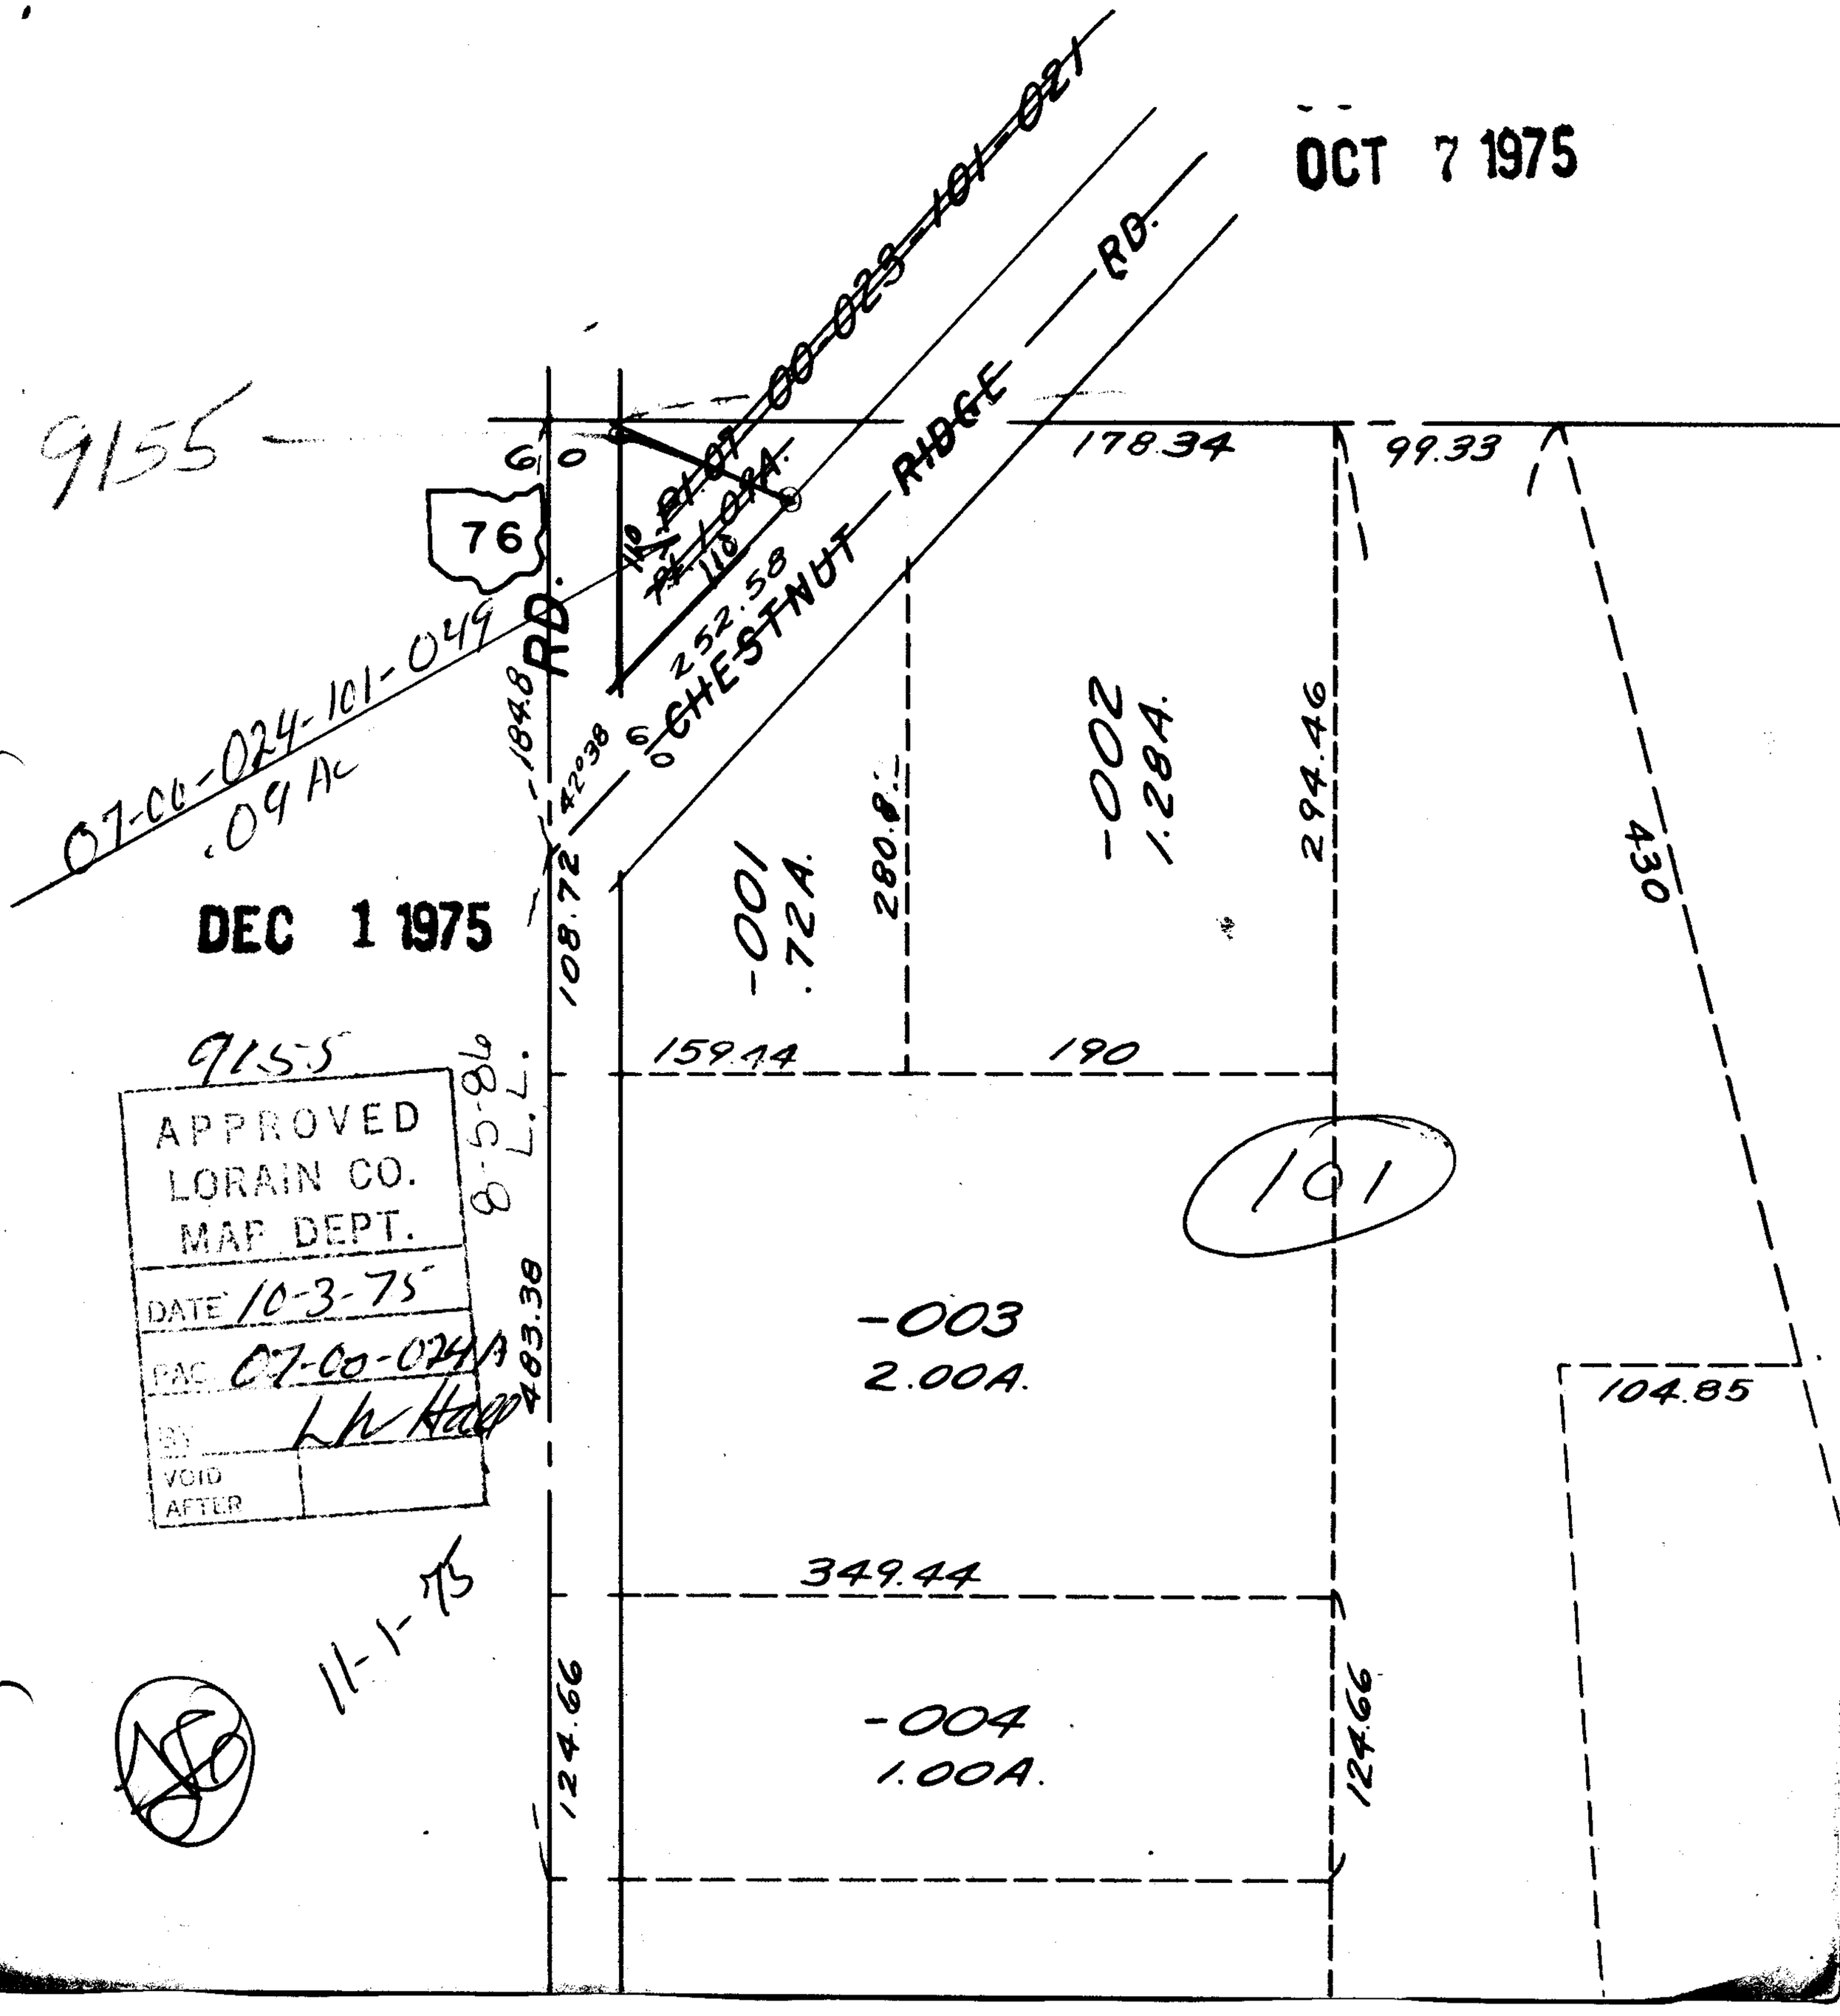
11-1-75