9167

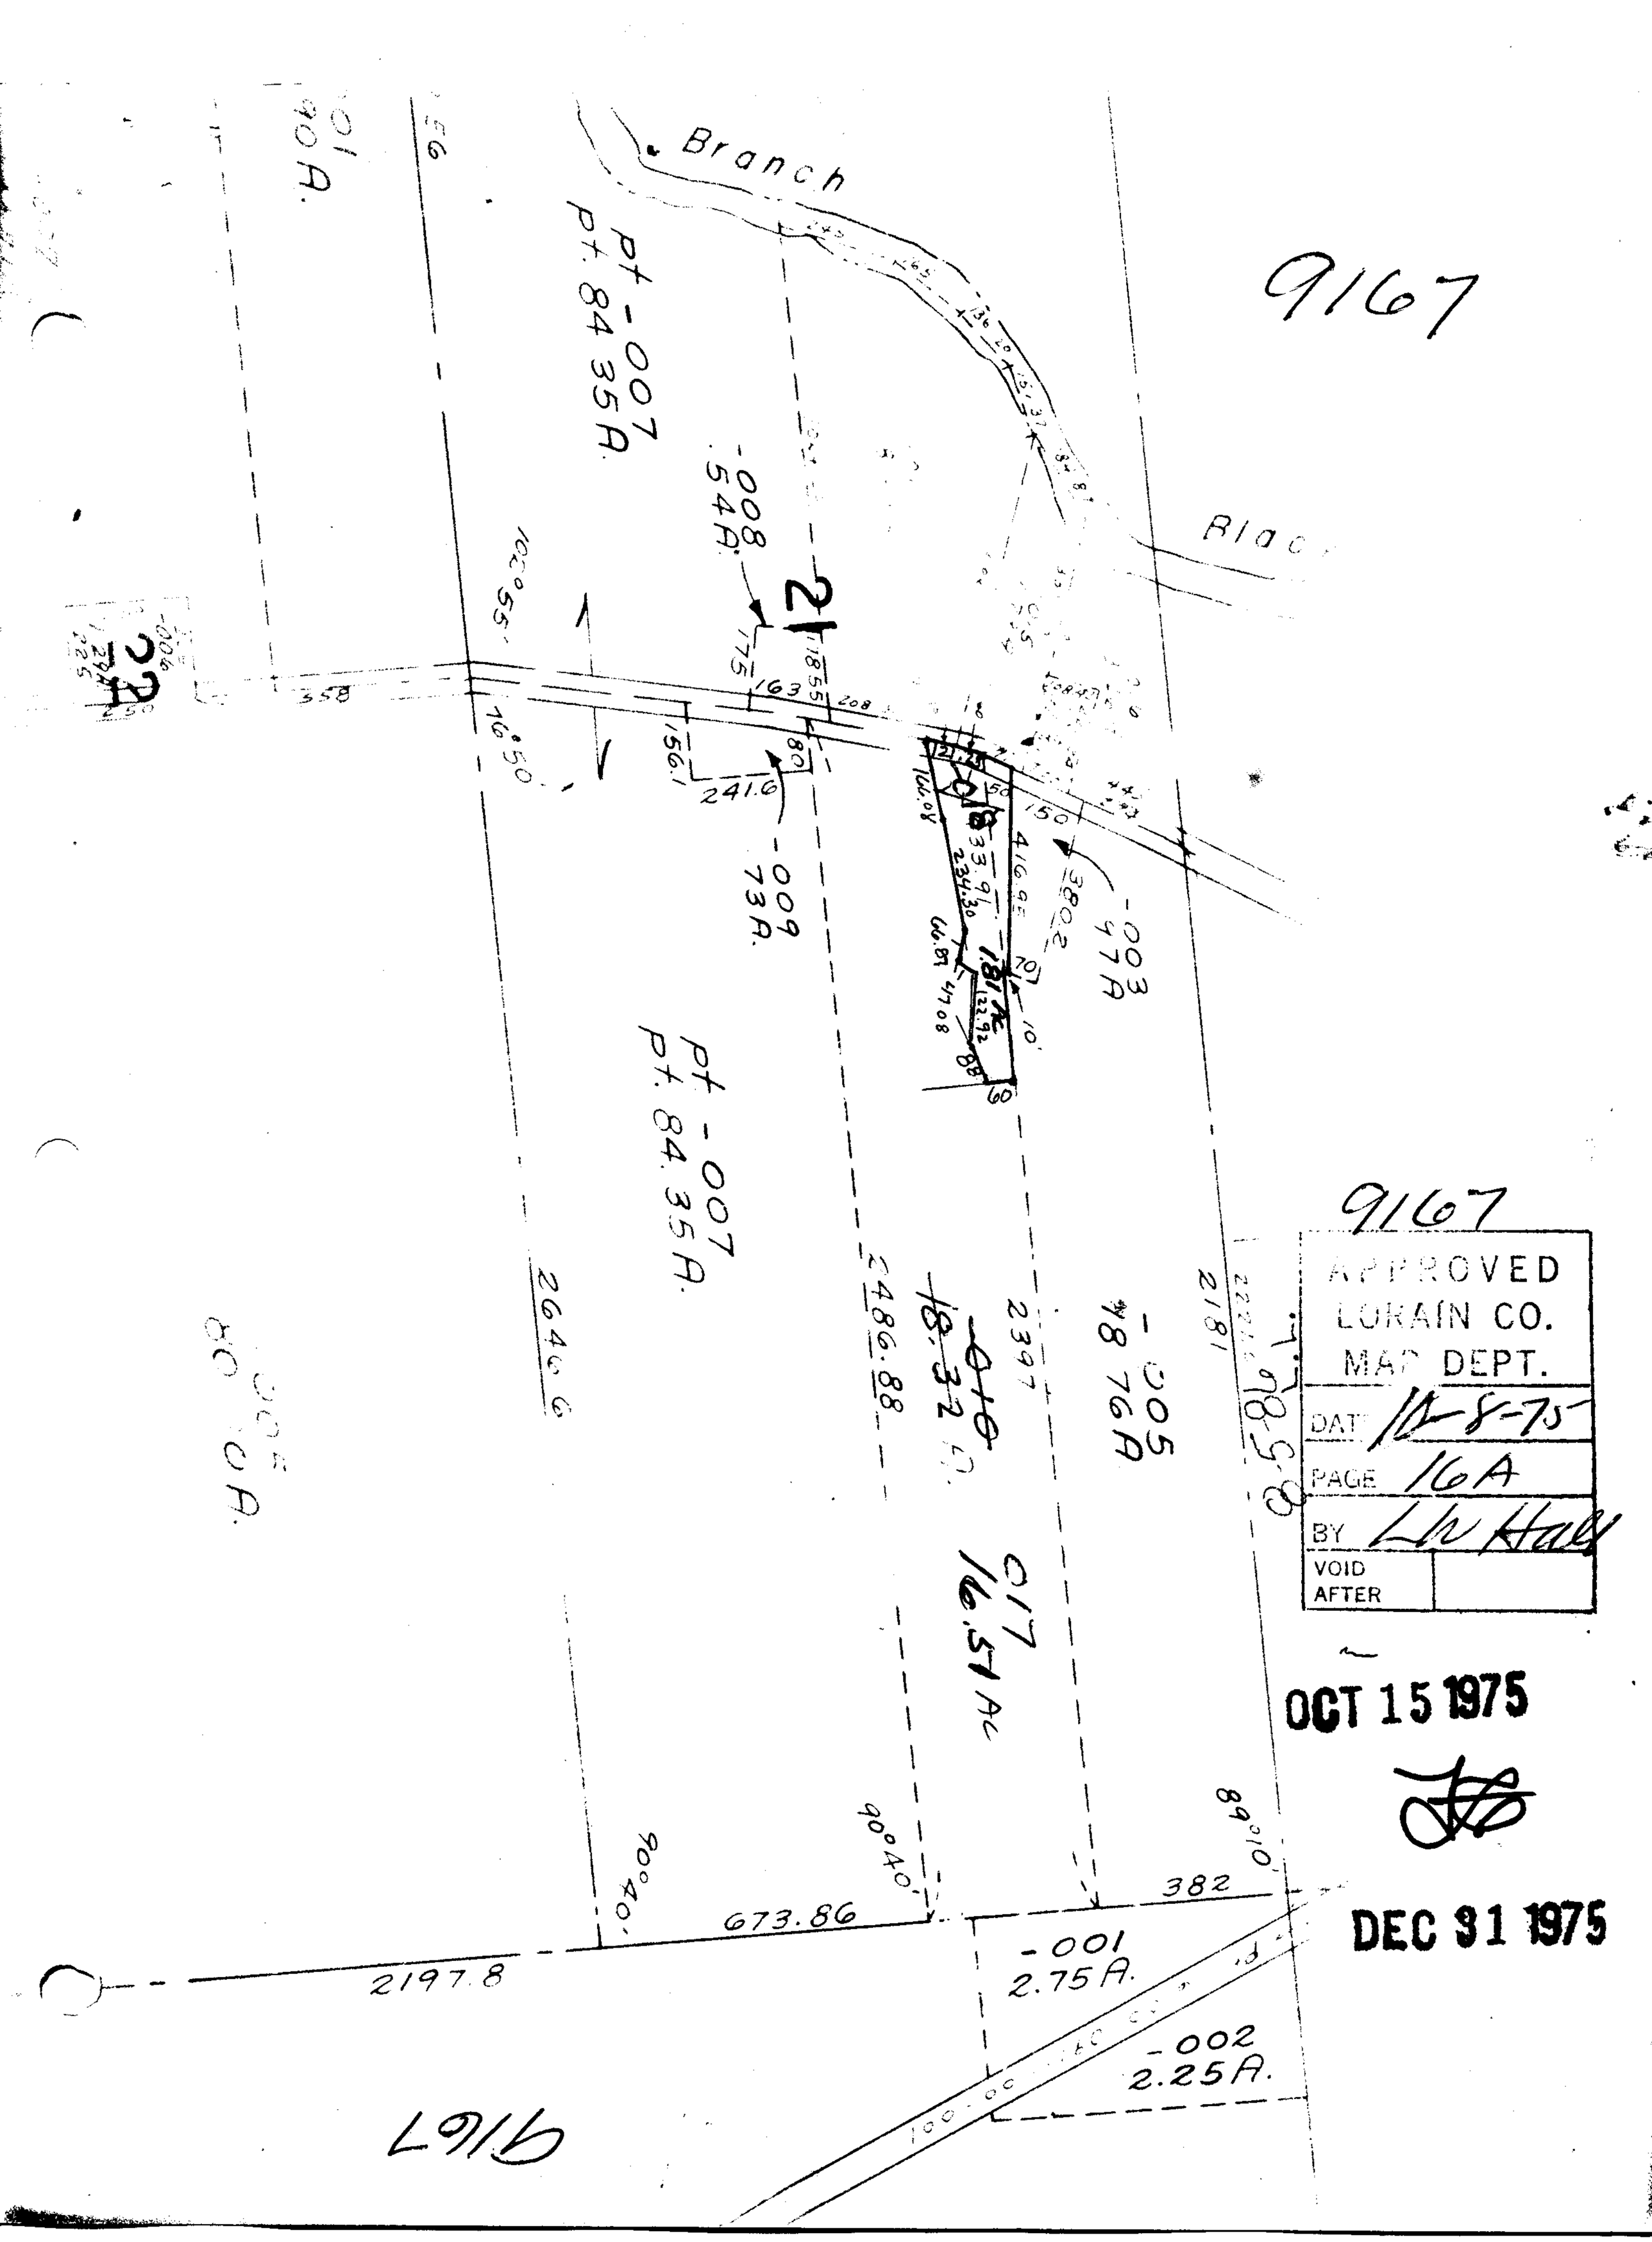

9167

APPROVED
LORAIN CO.
MAP DEPT.
DATE 11-8-75
PAGE 16A
BY LW Hall
VOID AFTER

OCT 15 1975

DEC 31 1975

9167