


10.00H.

473.50
194.03
279.47

SEE 12-A

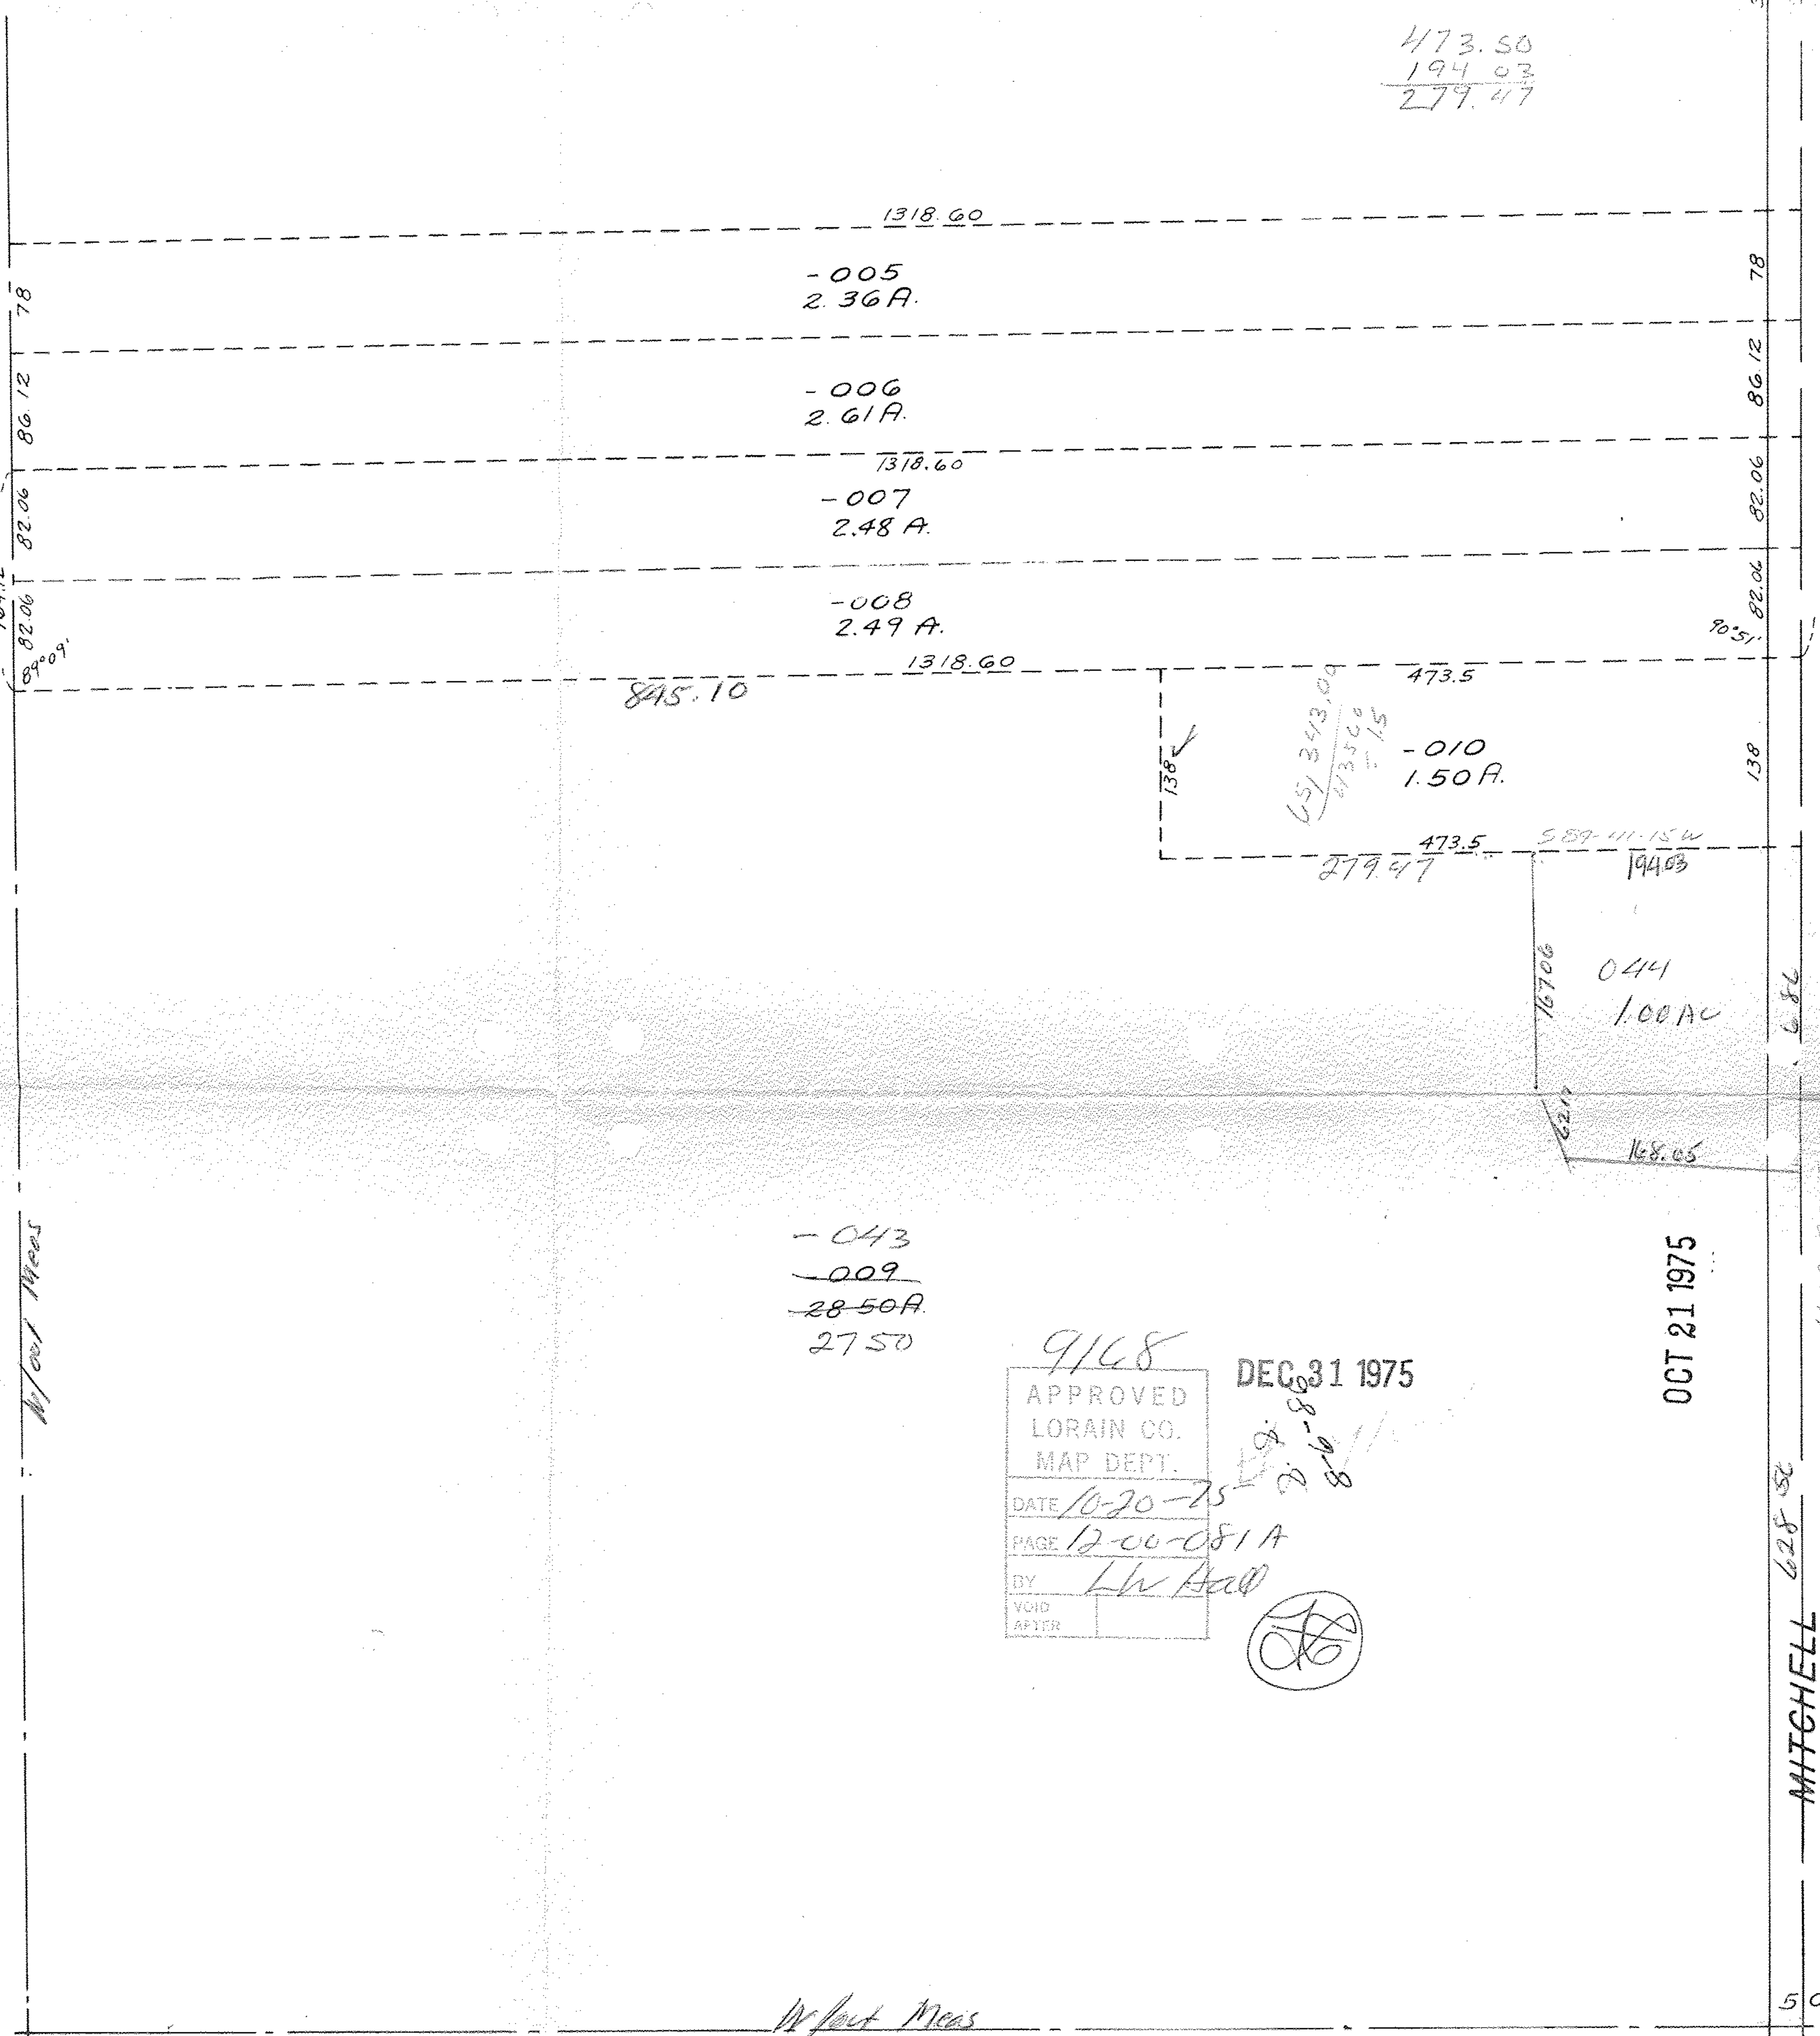

SEE 12-00-081-B

651 343.09
473.50
= 15

~~-043~~
~~-009~~
~~28.50 A.~~
27.50

9/168
 APPROVED
 LORAIN CO.
 MAP DEPT.
 DATE 10-20-75
 PAGE 12-00-081A
 BY L.W. Hall
 VOID AFTER
 DEC 31 1975
 7-8-80
 8-6-80

OCT 21 1975

MITCHELL 628 50

W/out Meas
SEE 12-00-082-A

50