


9189

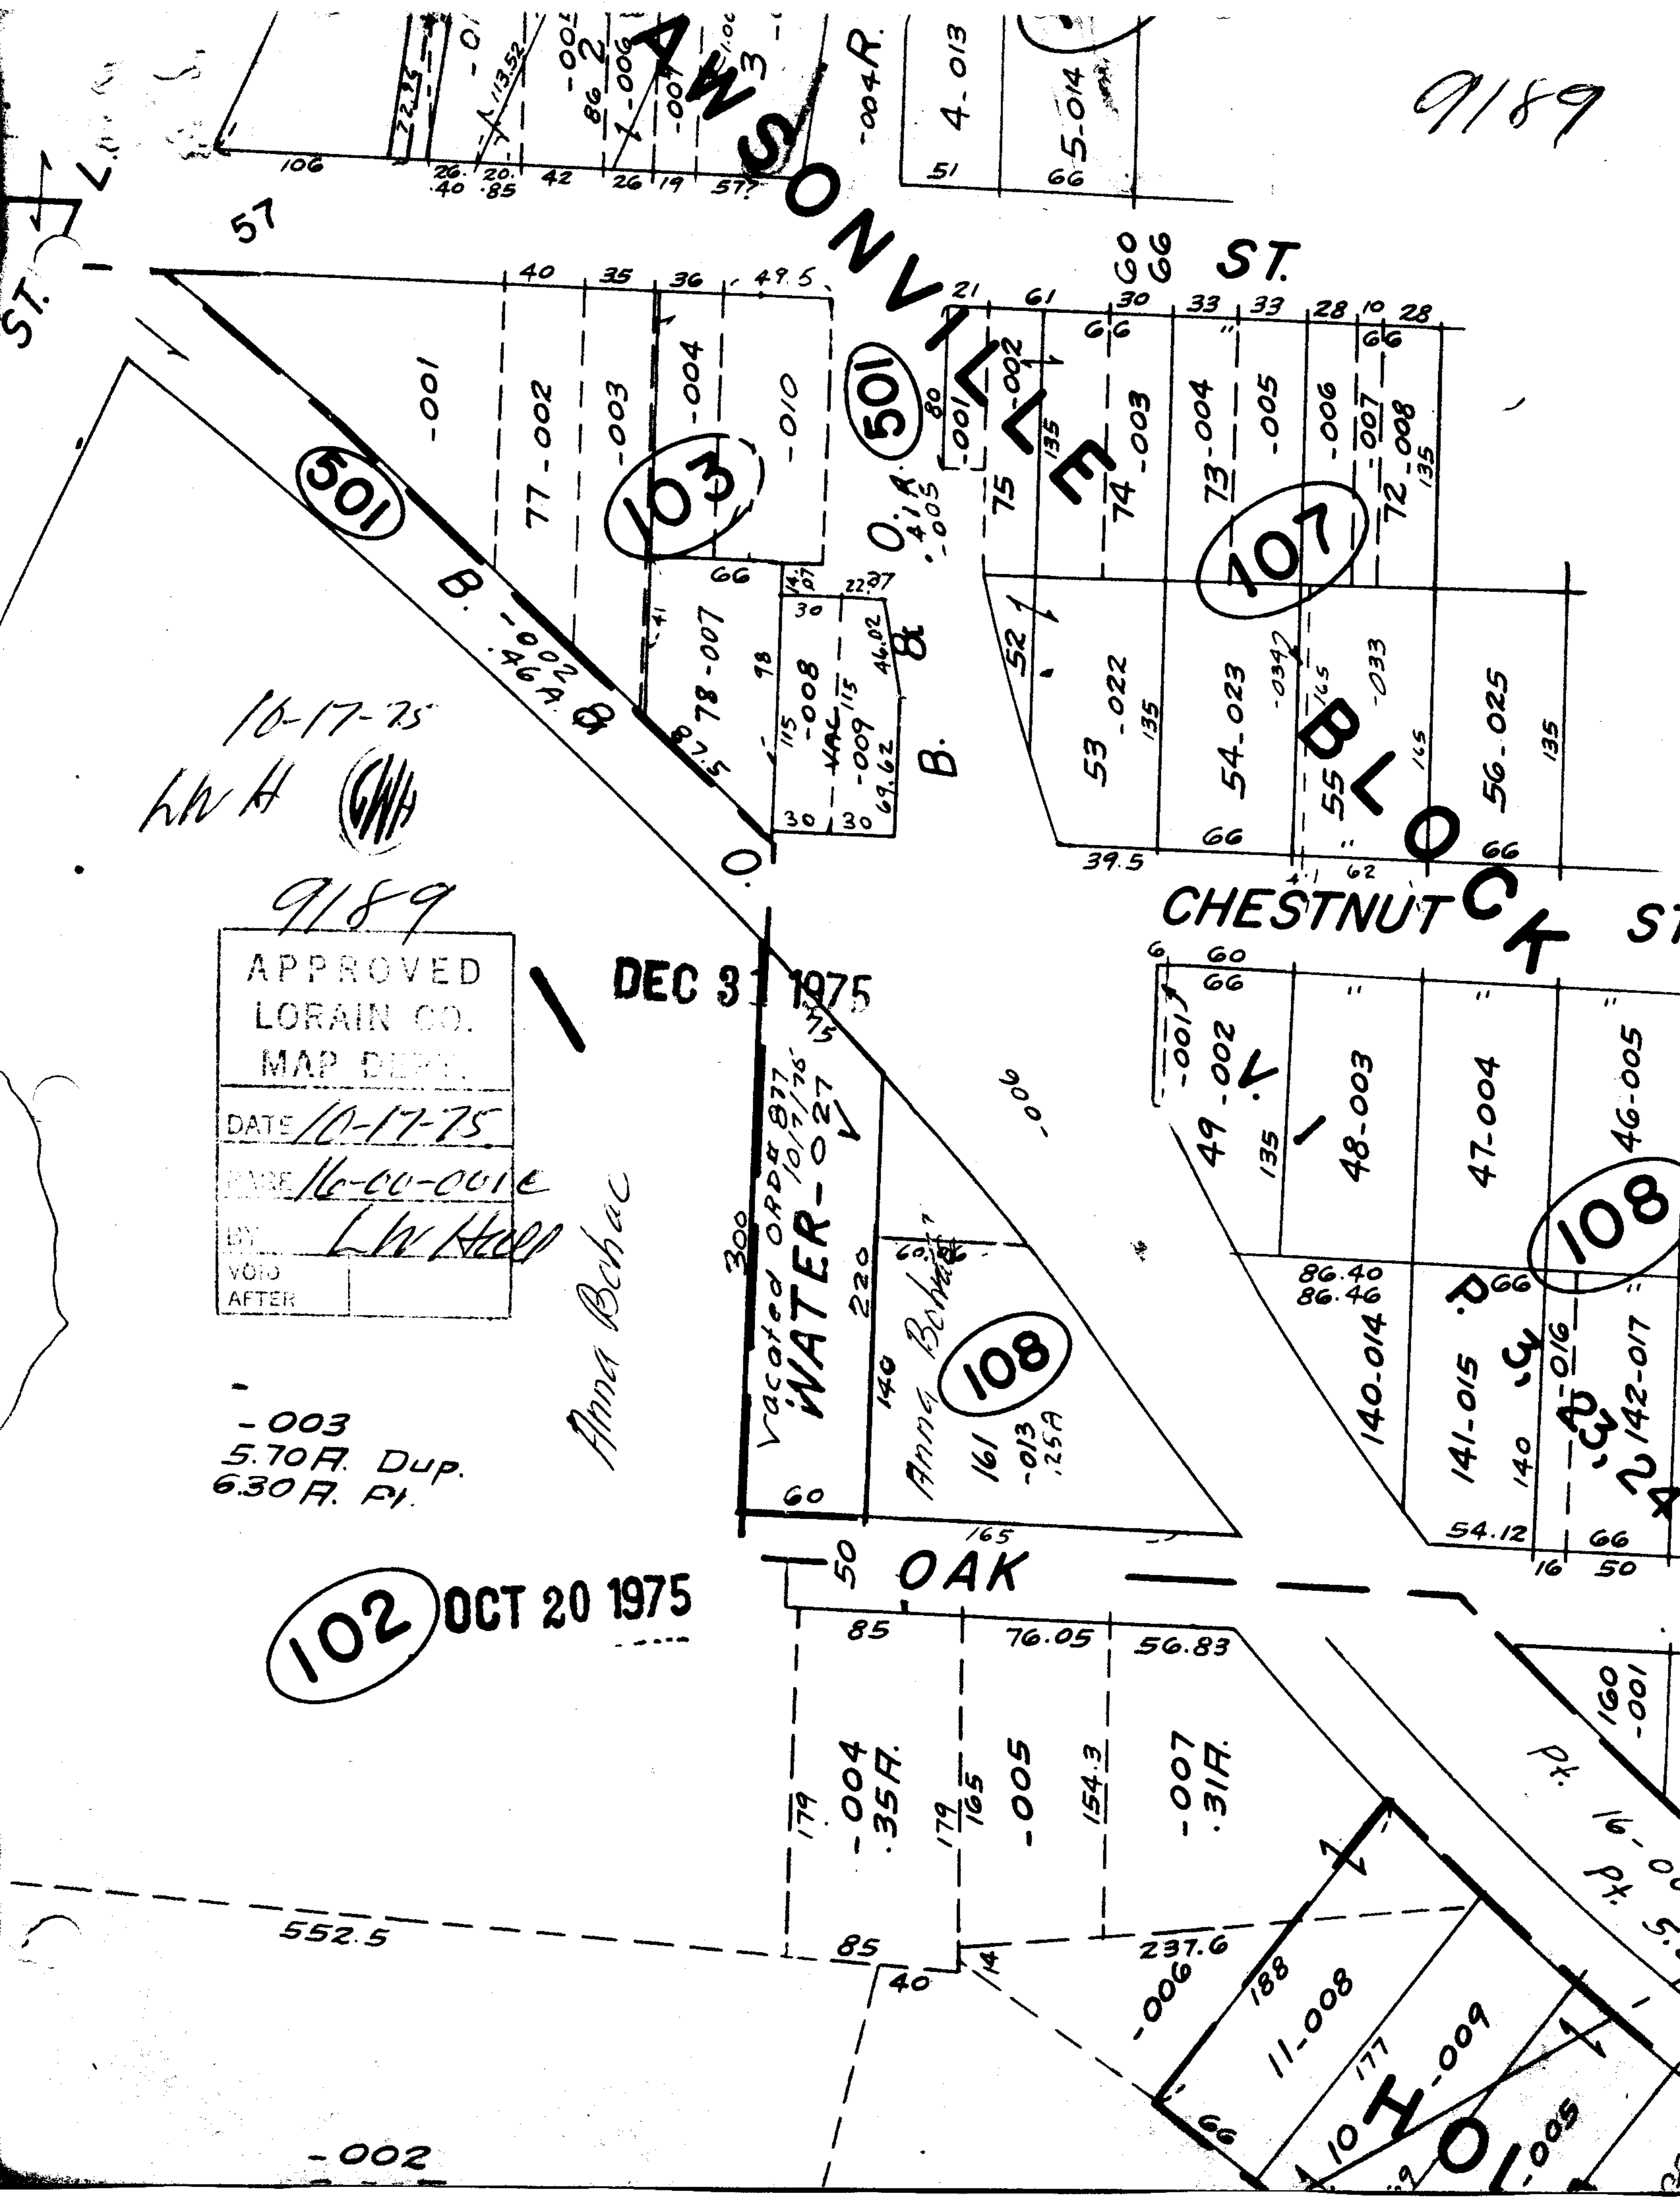

10-17-75
 LWH

9189

APPROVED
LORAIN CO.
MAP DEPT.
DATE 10-17-75
FILE 16-00-0016
BY LWH
VOID AFTER

DEC 31 1975

Anna Bohac

- 003
 5.70 R. Dup.
 6.30 R. Pl.

102 OCT 20 1975

Vacated ORDER 877 10/17/75
 WATER - 027

Anna Bohac

OAK

CHESTNUT ST

ST.

ST.

- 002