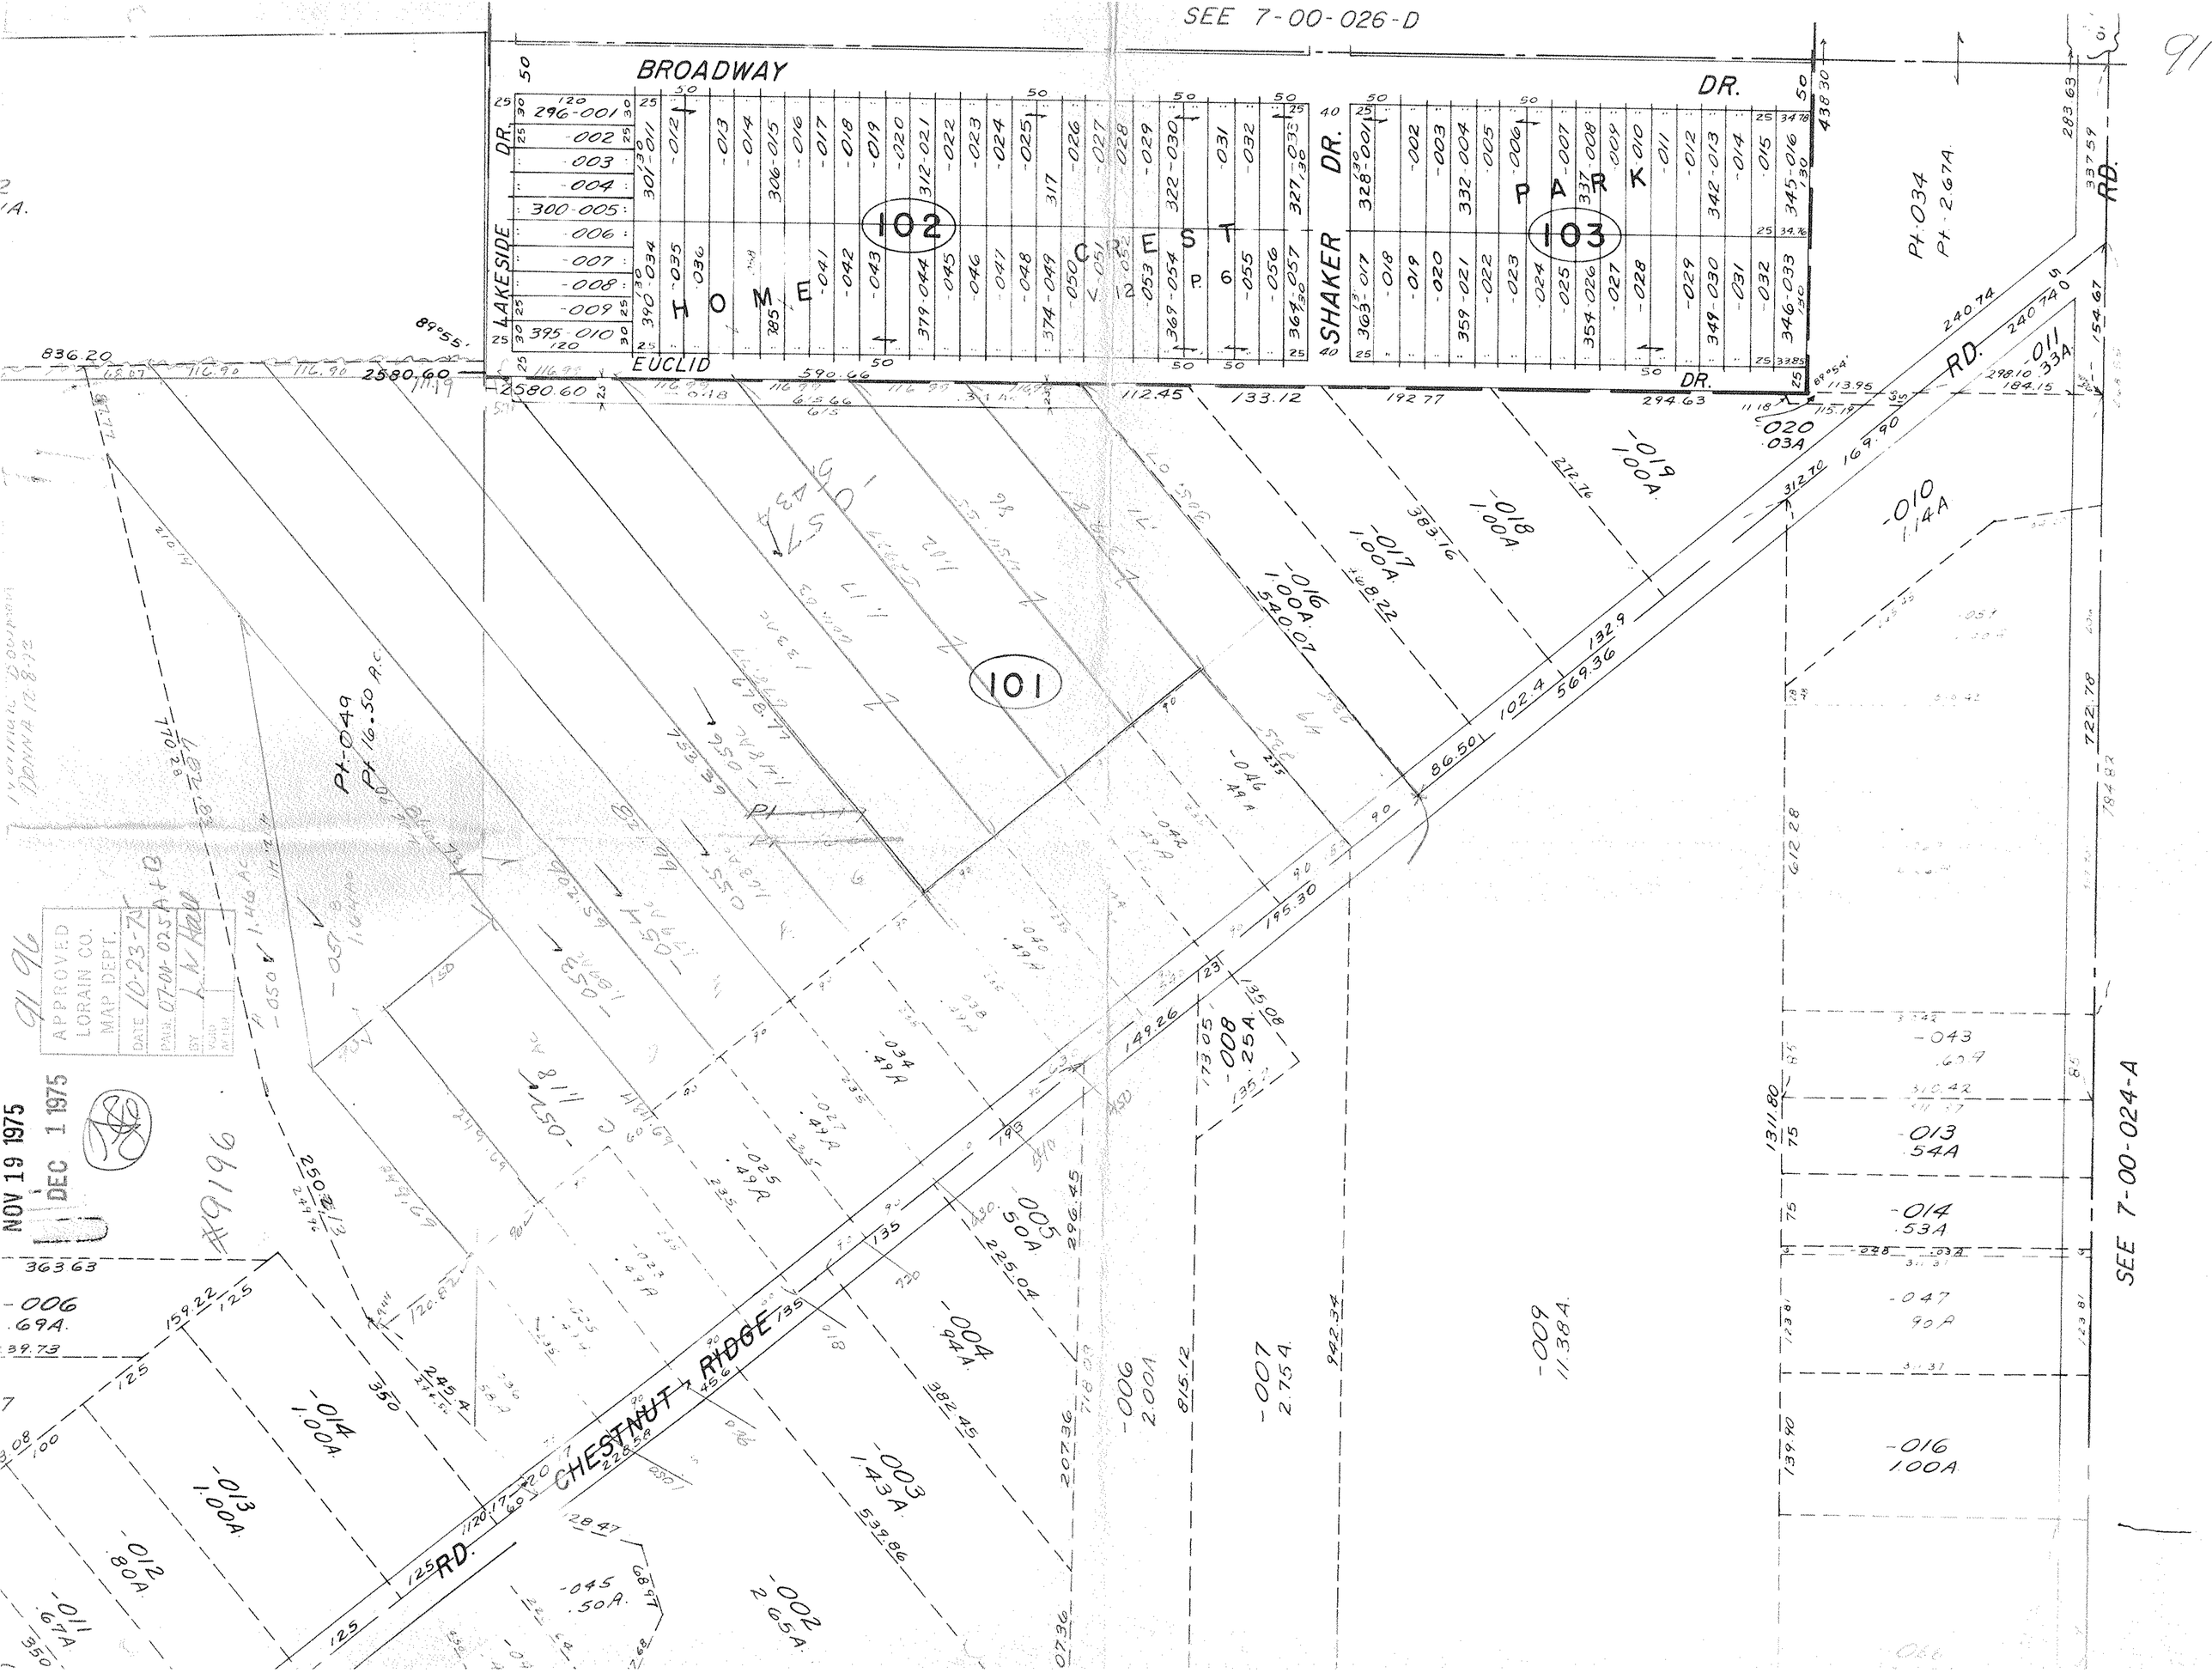

SEE 7-00-026-D
BROADWAY
DR.
LAKESIDE DR.
EUCLID DR.
SHAKER DR.
HOME CREST
PARK
102
103
101
CHESTNUT RIDGE RD.
RD.
SEE 7-00-024-A
Pt-034
Pt-2.67A
Pt-049
Pt 16.50 A.C.
APPROVED
LORAIN CO.
MAP DEPT.
DATE 10-23-75
PAGE 07-00-025A+B
BY
VOID AFTER
NOV 19 1975
DEC 1 1975
#9196