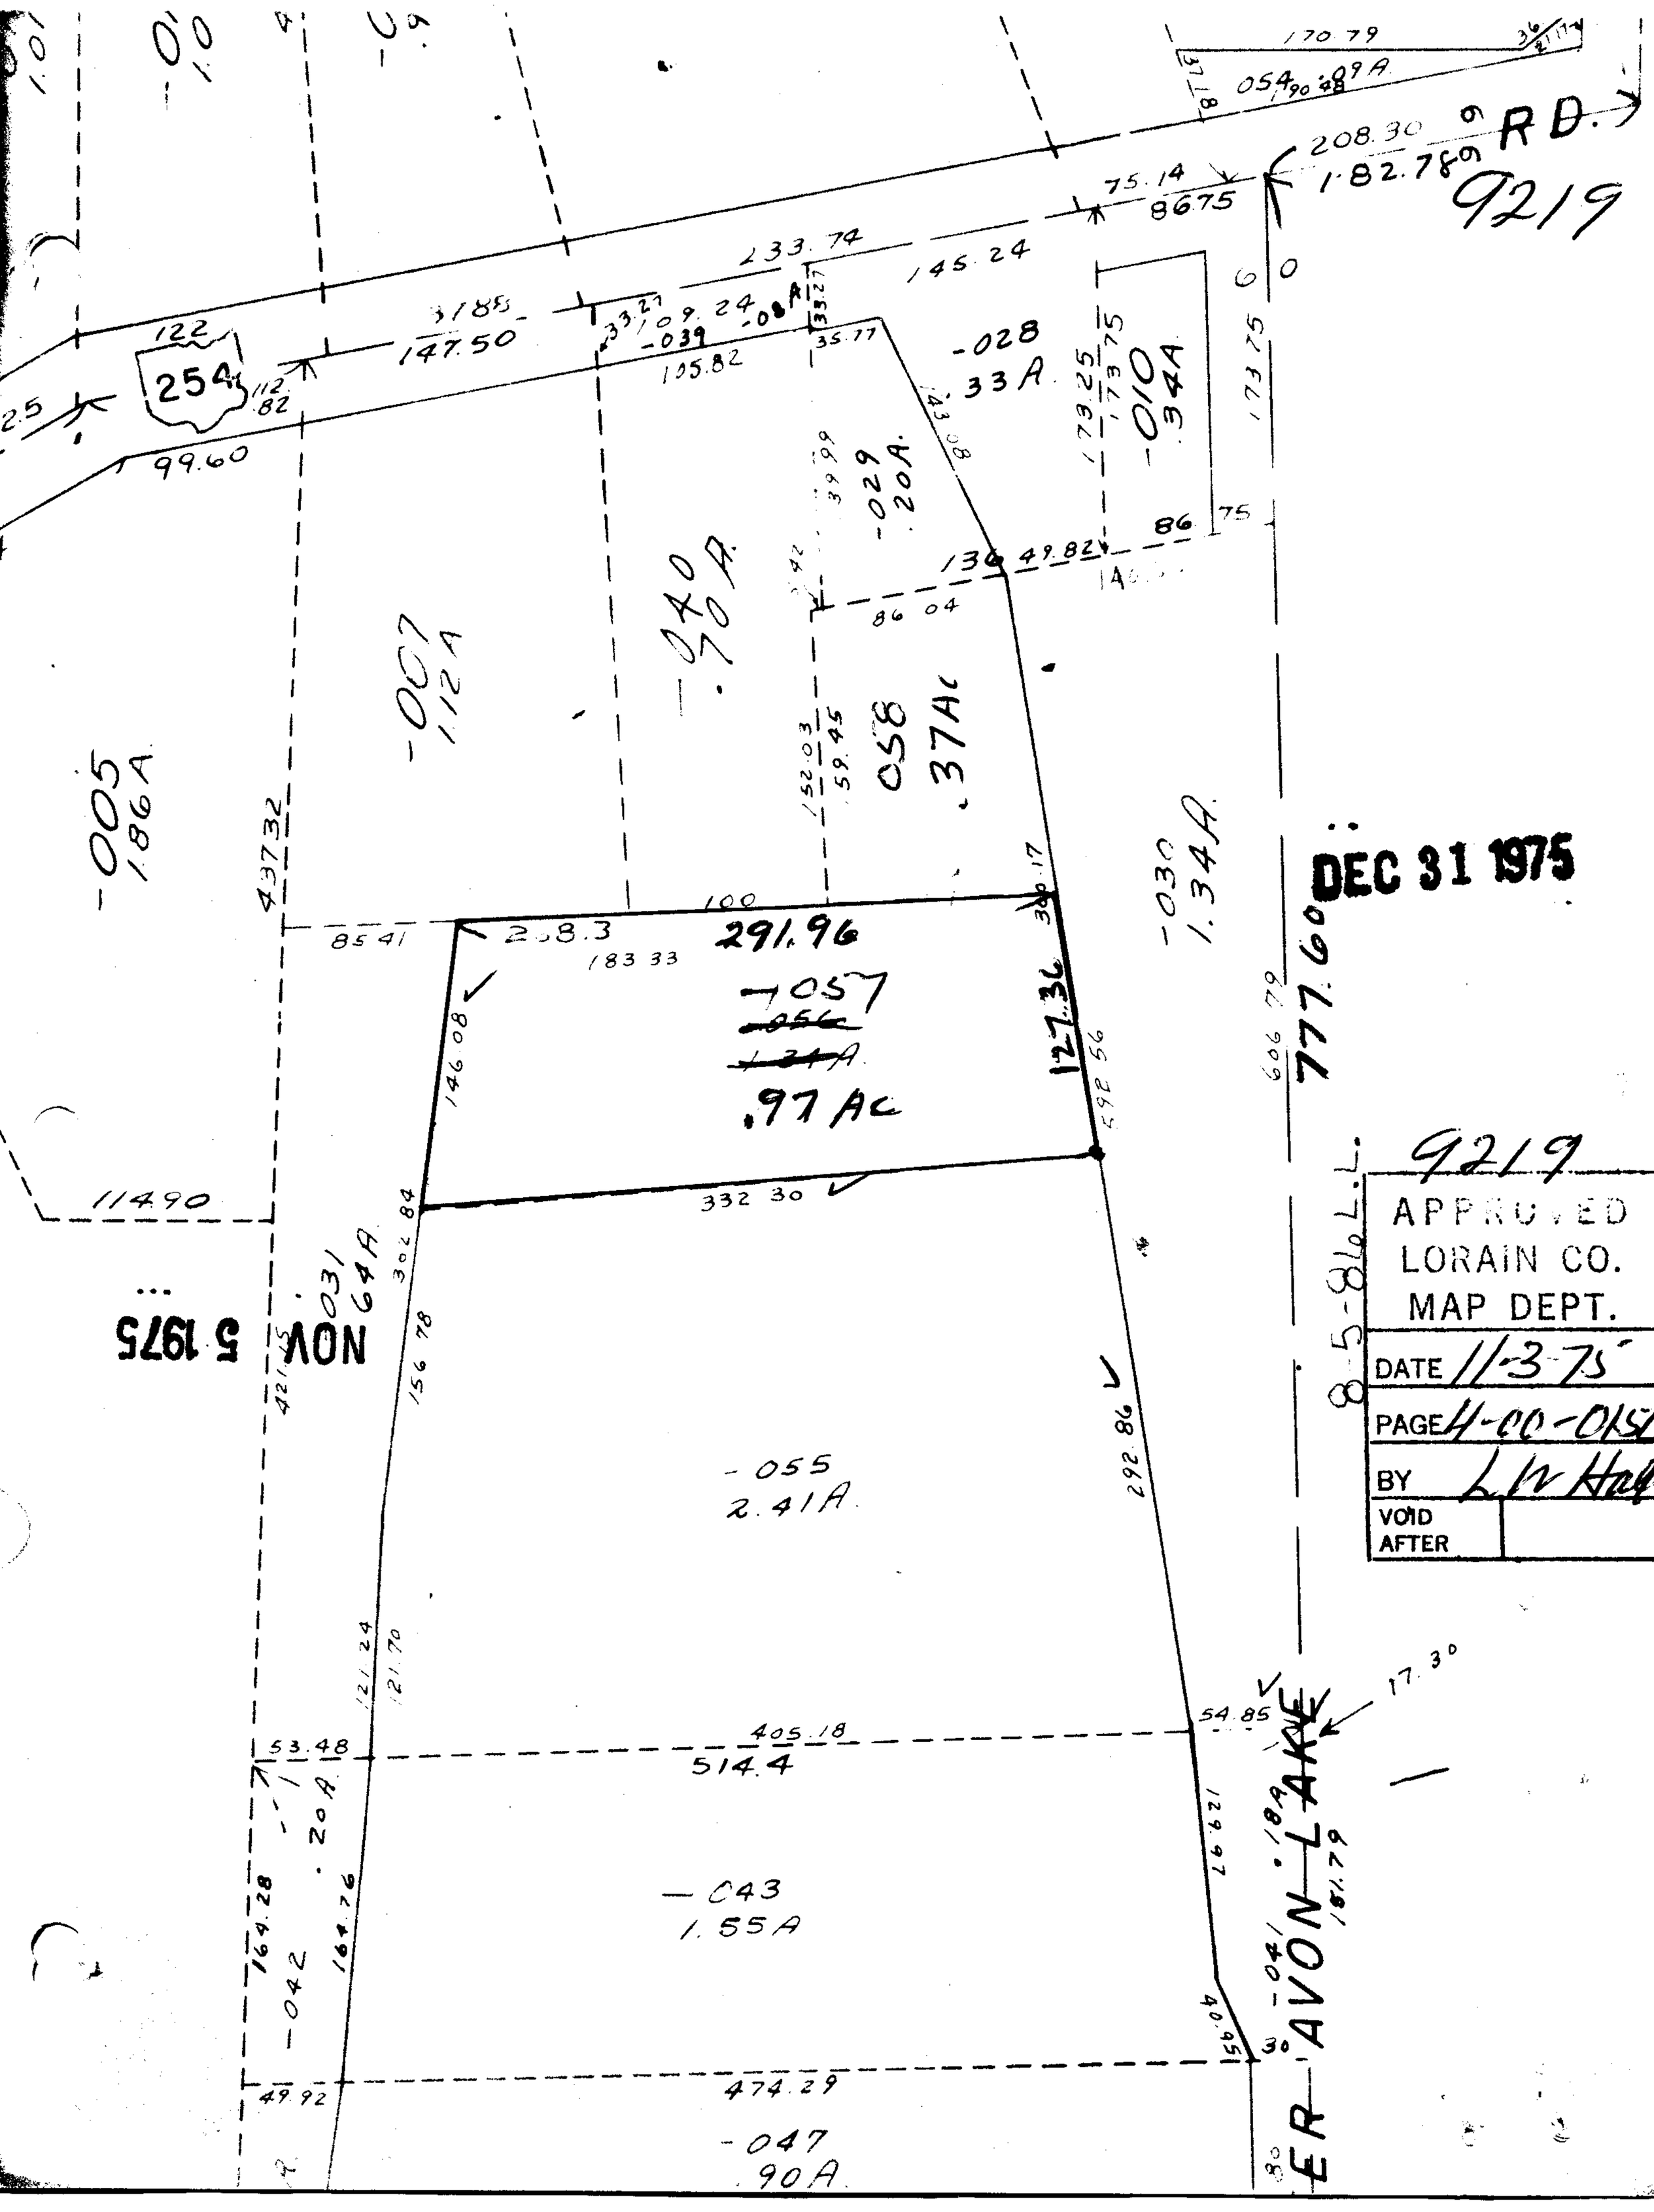
RD.
9219
208.30
1.82.78
75.14
86.75
145.24
233.74
170.79
054
.89A
147.50
105.82
122
254
112.82
99.60
-028
.33A
-010
.34A
-029
.20A.
-040
.70A
-007
.12A
-005
.186A
-039
-027
-030
1.34A
-057
.97Ac
-058
.37Ac
291.96
332.30
-055
2.41A
-031
.64A
-043
1.55A
-042
.20A
-047
.90A
514.4
474.29
405.18
DEC 31 1975
NOV 5 1975
APPROVED
LORAIN CO.
MAP DEPT.
DATE 11-3-75
PAGE 4-00-058
BY L.W. Hall
VOID AFTER
8-5-86 L.L.
9219
LAKE
AVON
ER