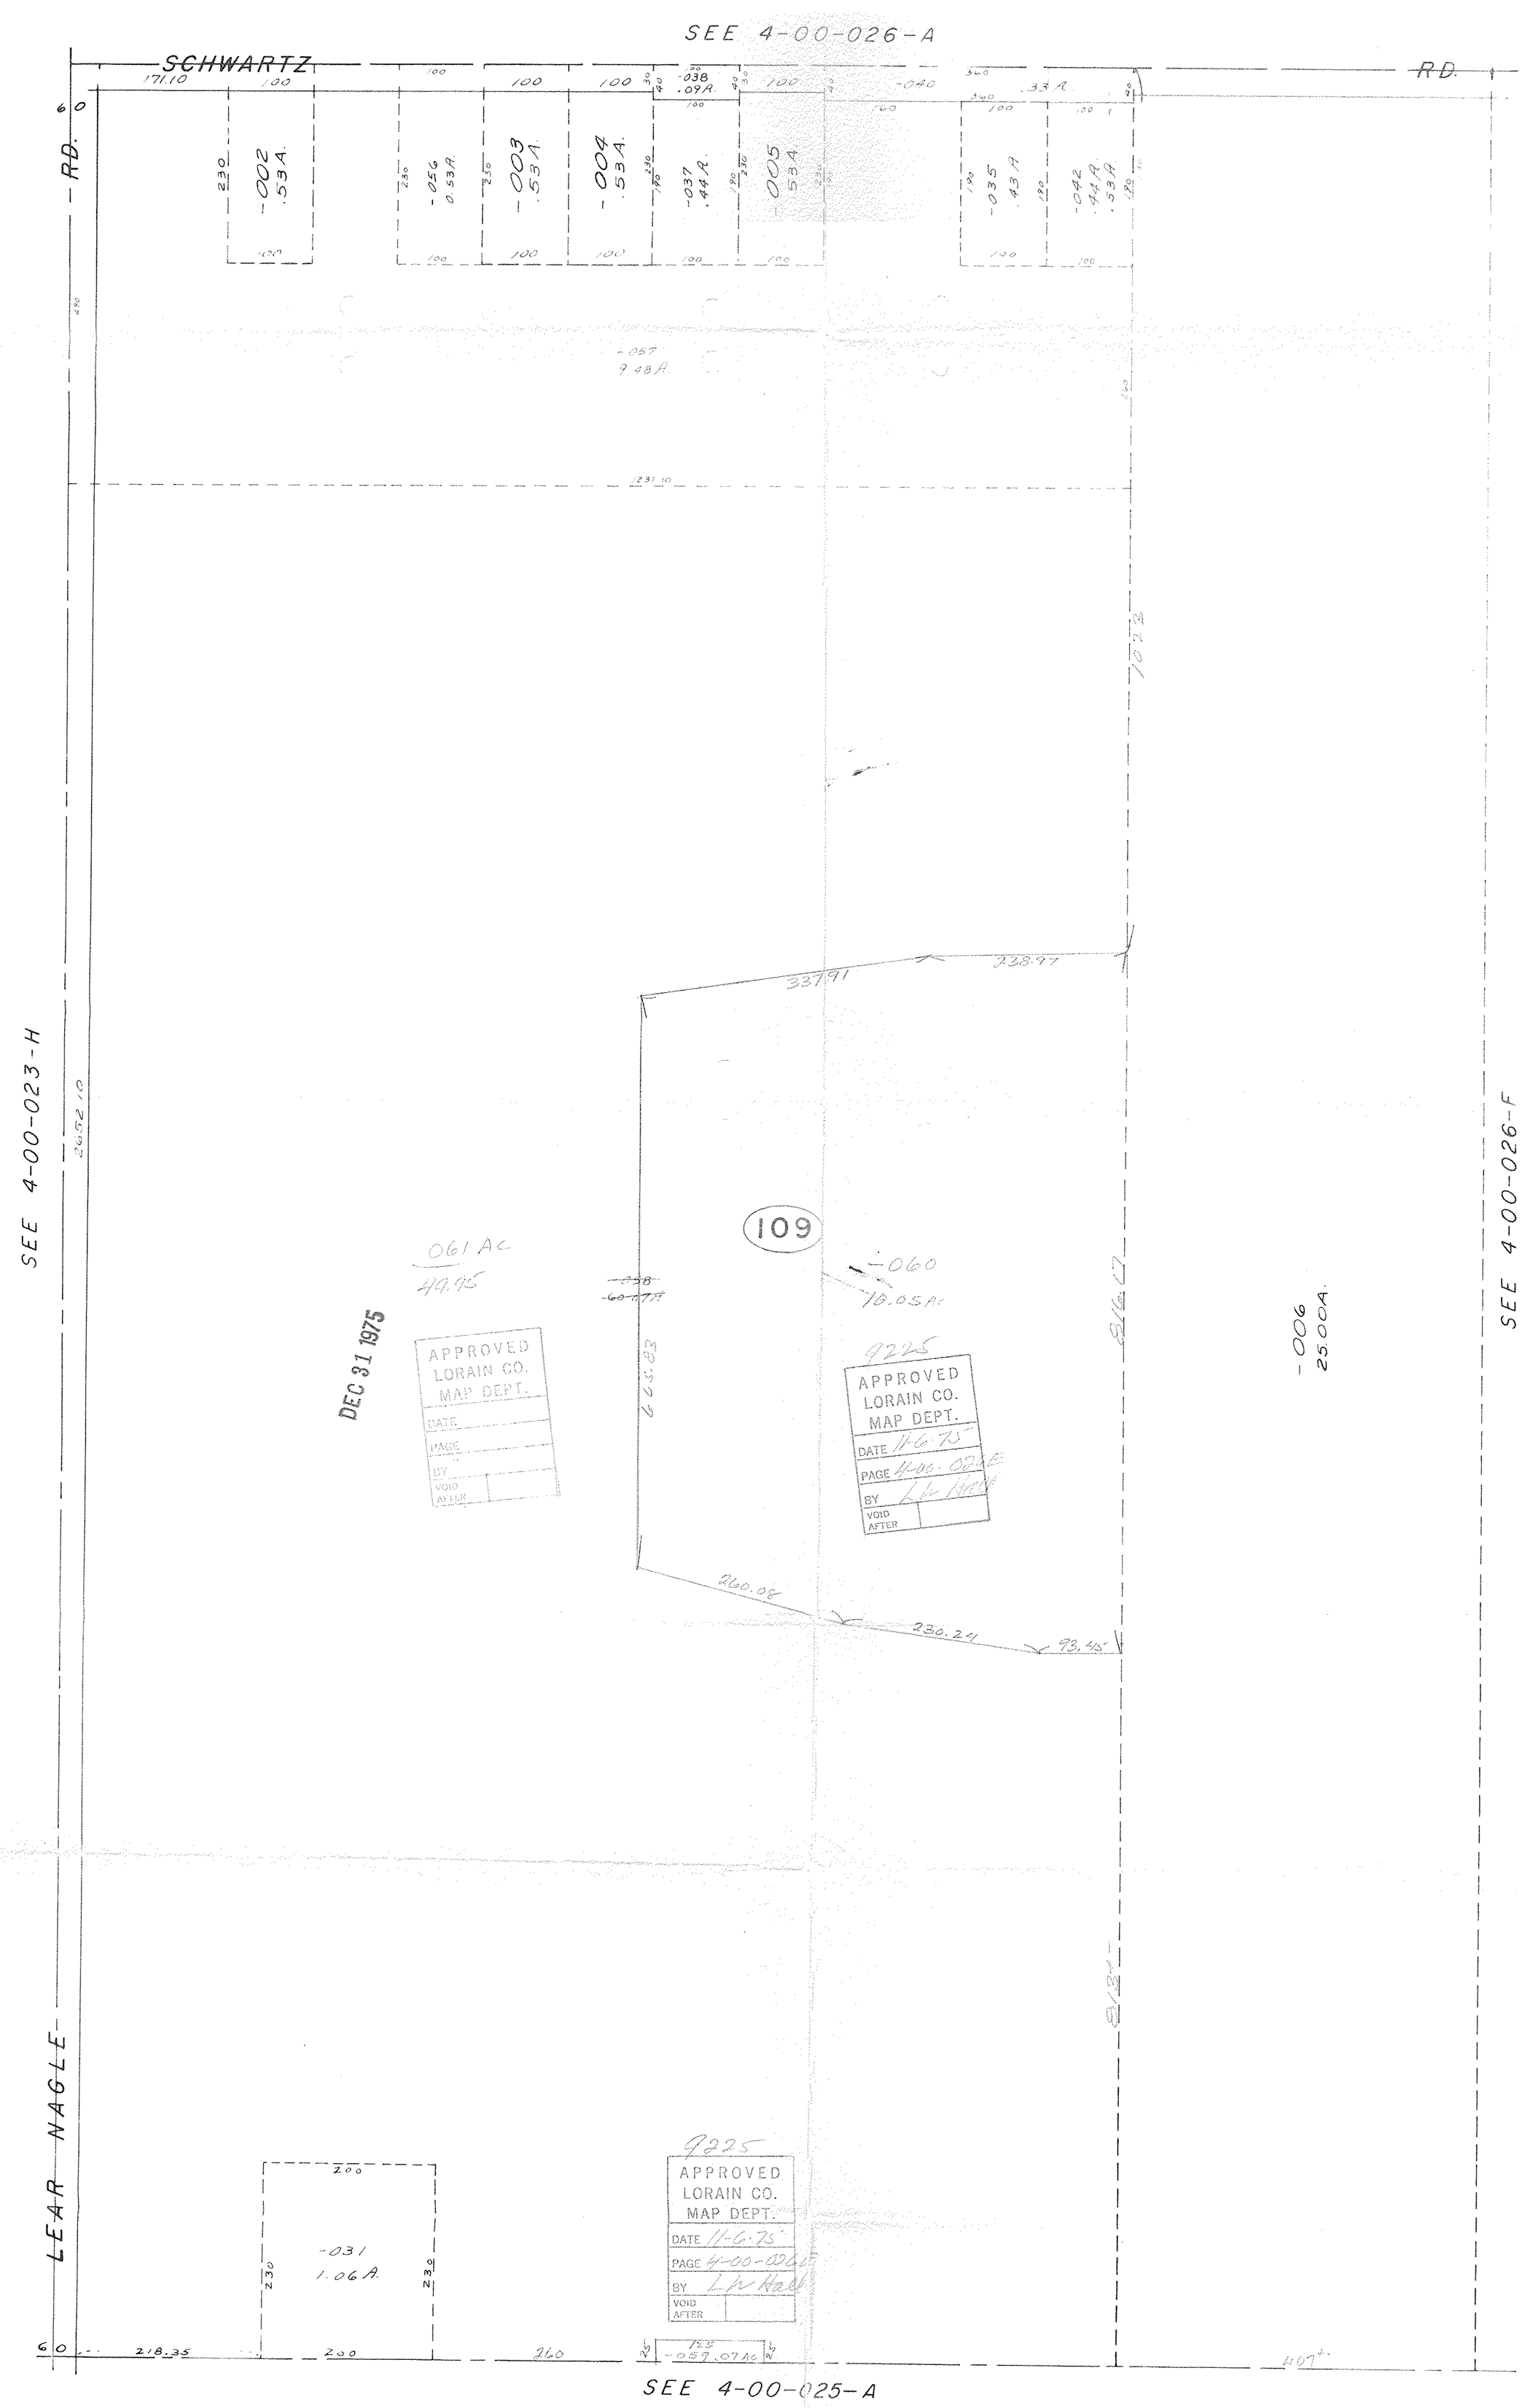
SEE 4-00-026-A
SCHWARTZ
RD.
RD.
-002
.53A.
-056
0.53A.
-003
.53A.
-004
.53A.
-037
.44A.
-005
.53A
-038
.09A.
-040
.33A.
-035
.43A
-042
.44A
.53A
-057
9.48A.
231.10
SEE 4-00-023-H
SEE 4-00-026-F
-006
25.00A.
109
-060
10.05AC
9225
APPROVED
LORAIN CO.
MAP DEPT.
DATE 11-6-75
PAGE 4-00-026-E
BY L.H. Hall
VOID AFTER
061 AC
49.95
DEC 31 1975
APPROVED
LORAIN CO.
MAP DEPT.
DATE
PAGE
BY
VOID AFTER
LEAR NAGLE
-031
1.06A.
200
230
218.35
260
-059 .07AC
SEE 4-00-025-A
