


9267

DEC 1 1975  
NOV 20 1975

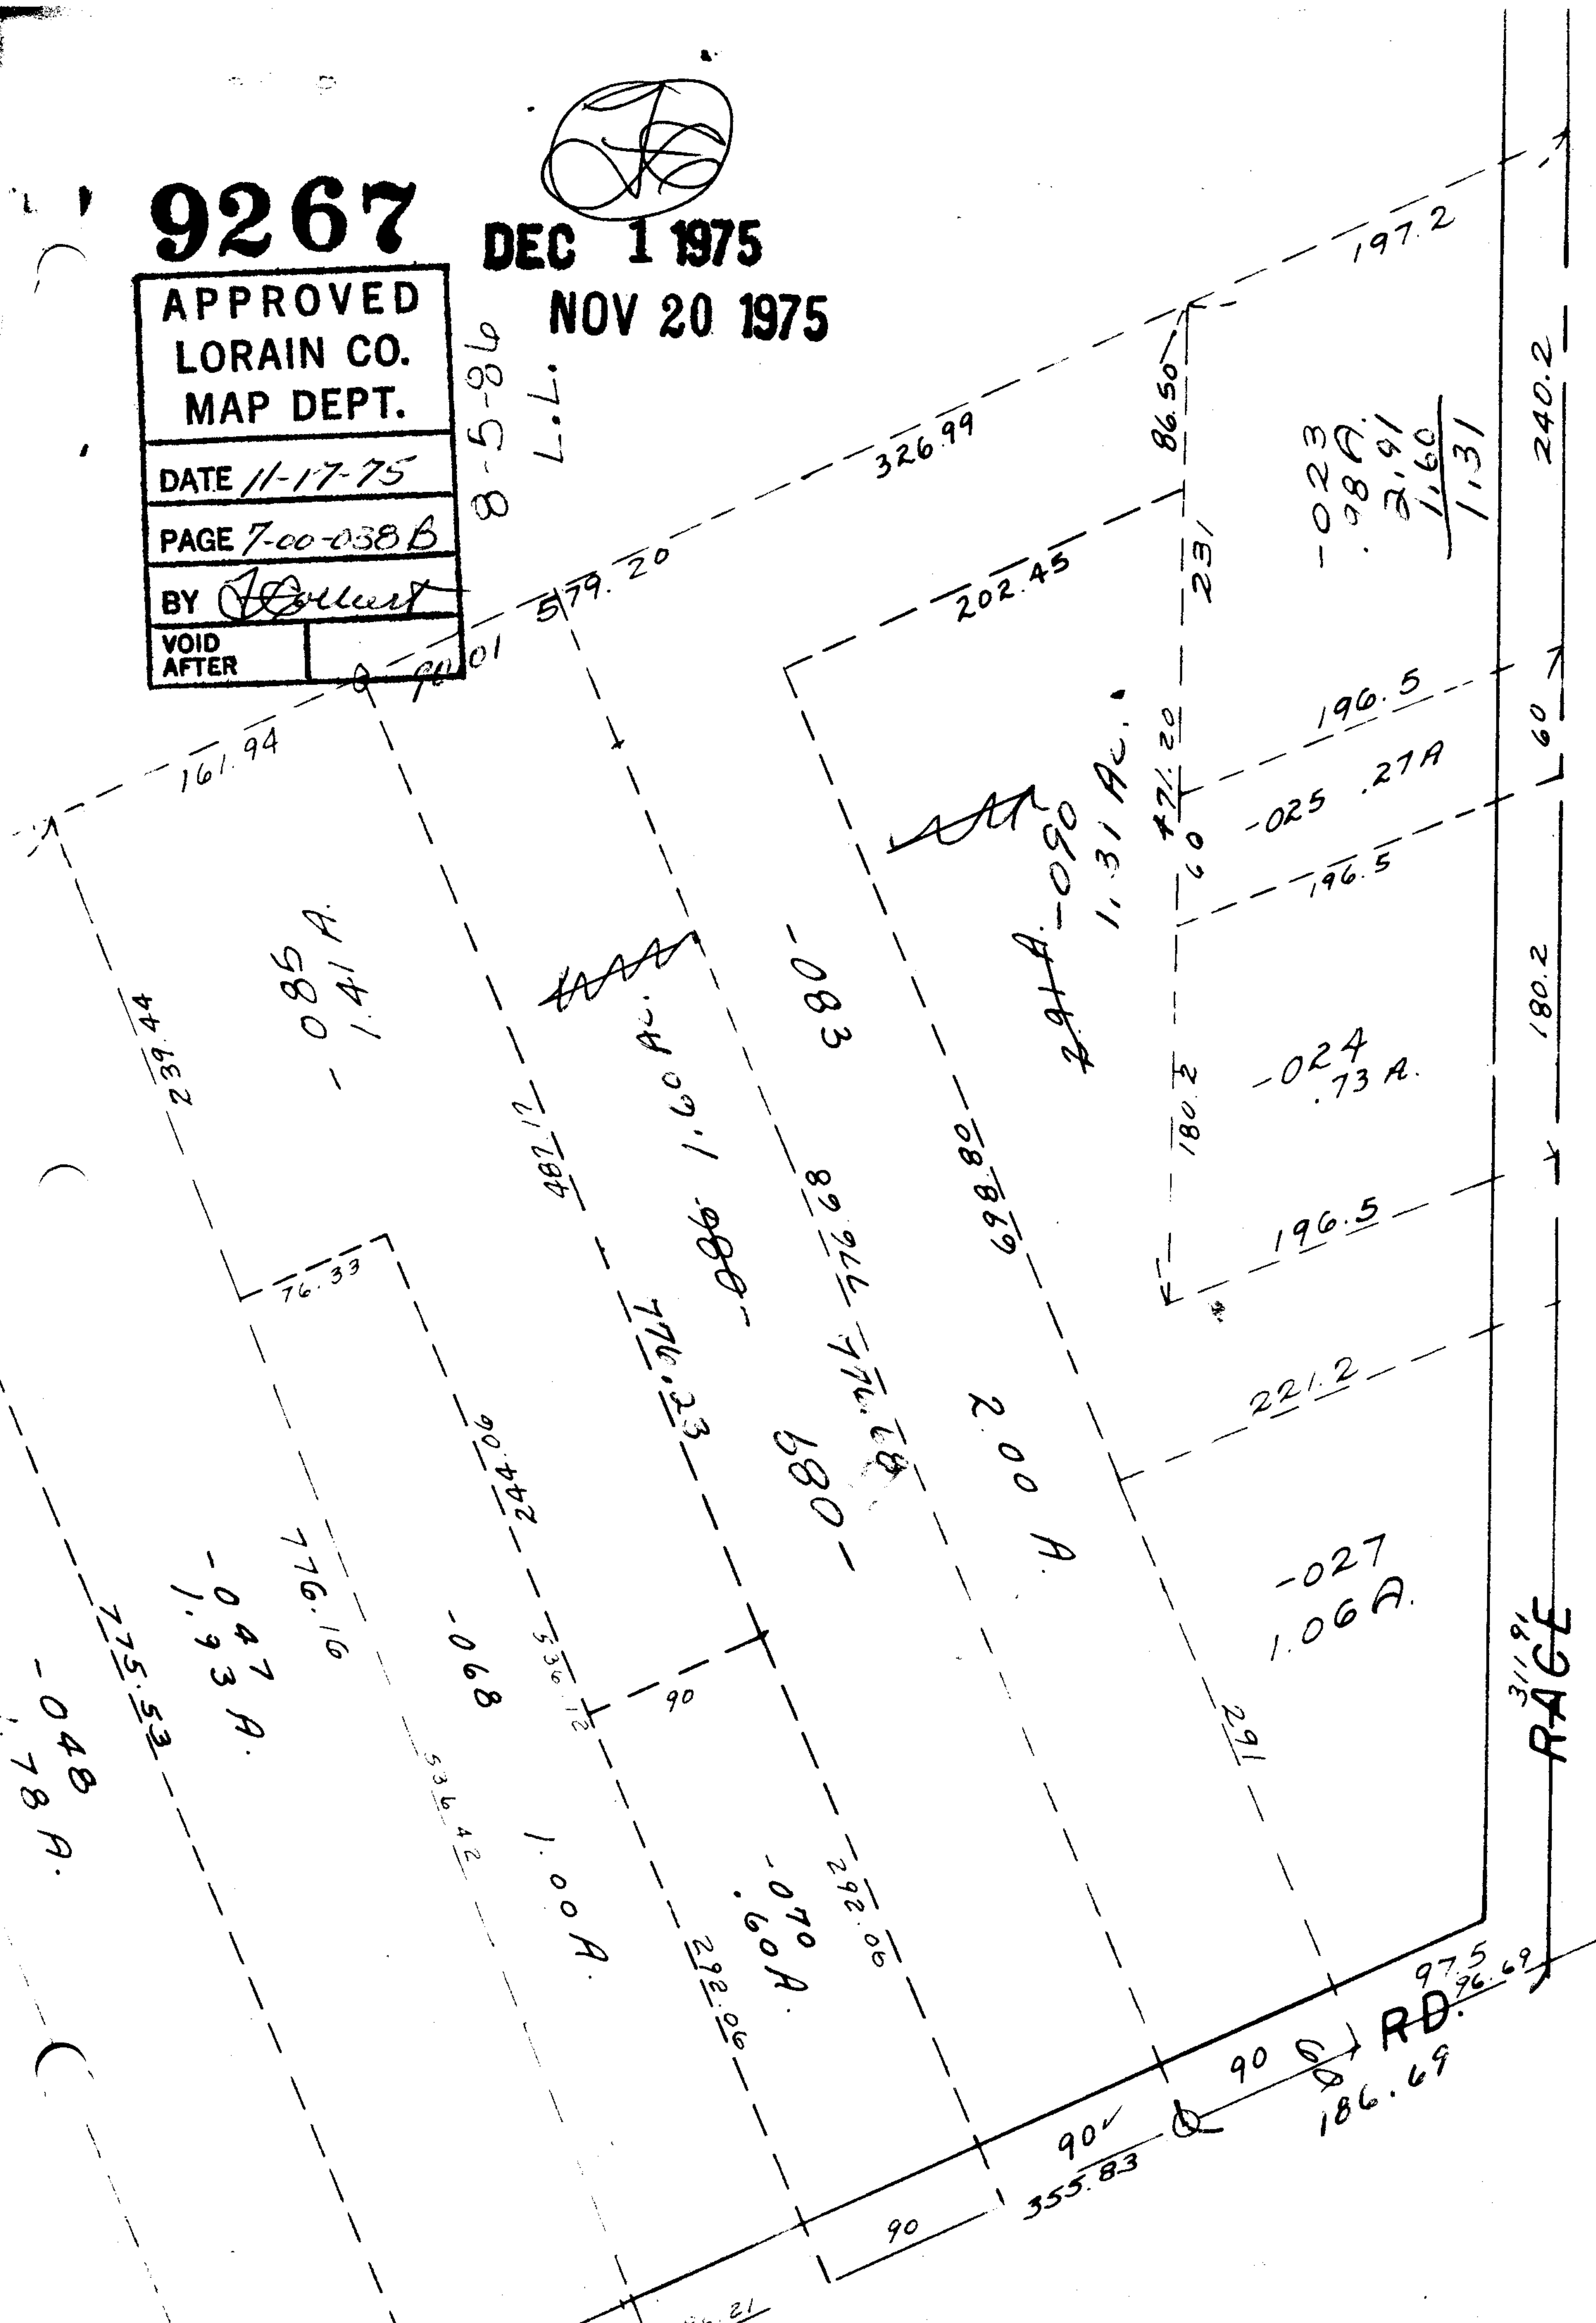

APPROVED LORAIN CO. MAP DEPT.	
DATE 11-17-75	
PAGE 7-00-038 B	
BY <i>J. Elliott</i>	
VOID AFTER	



SEE 7-00-035