NOV 24 1975
DEC 1 1975

9280

APPROVED
LORAIN CO.
MAP DEPT.
DATE 11-21-75
PAGE 7-00-021-A
BY J W Hull
VOID
AFTER

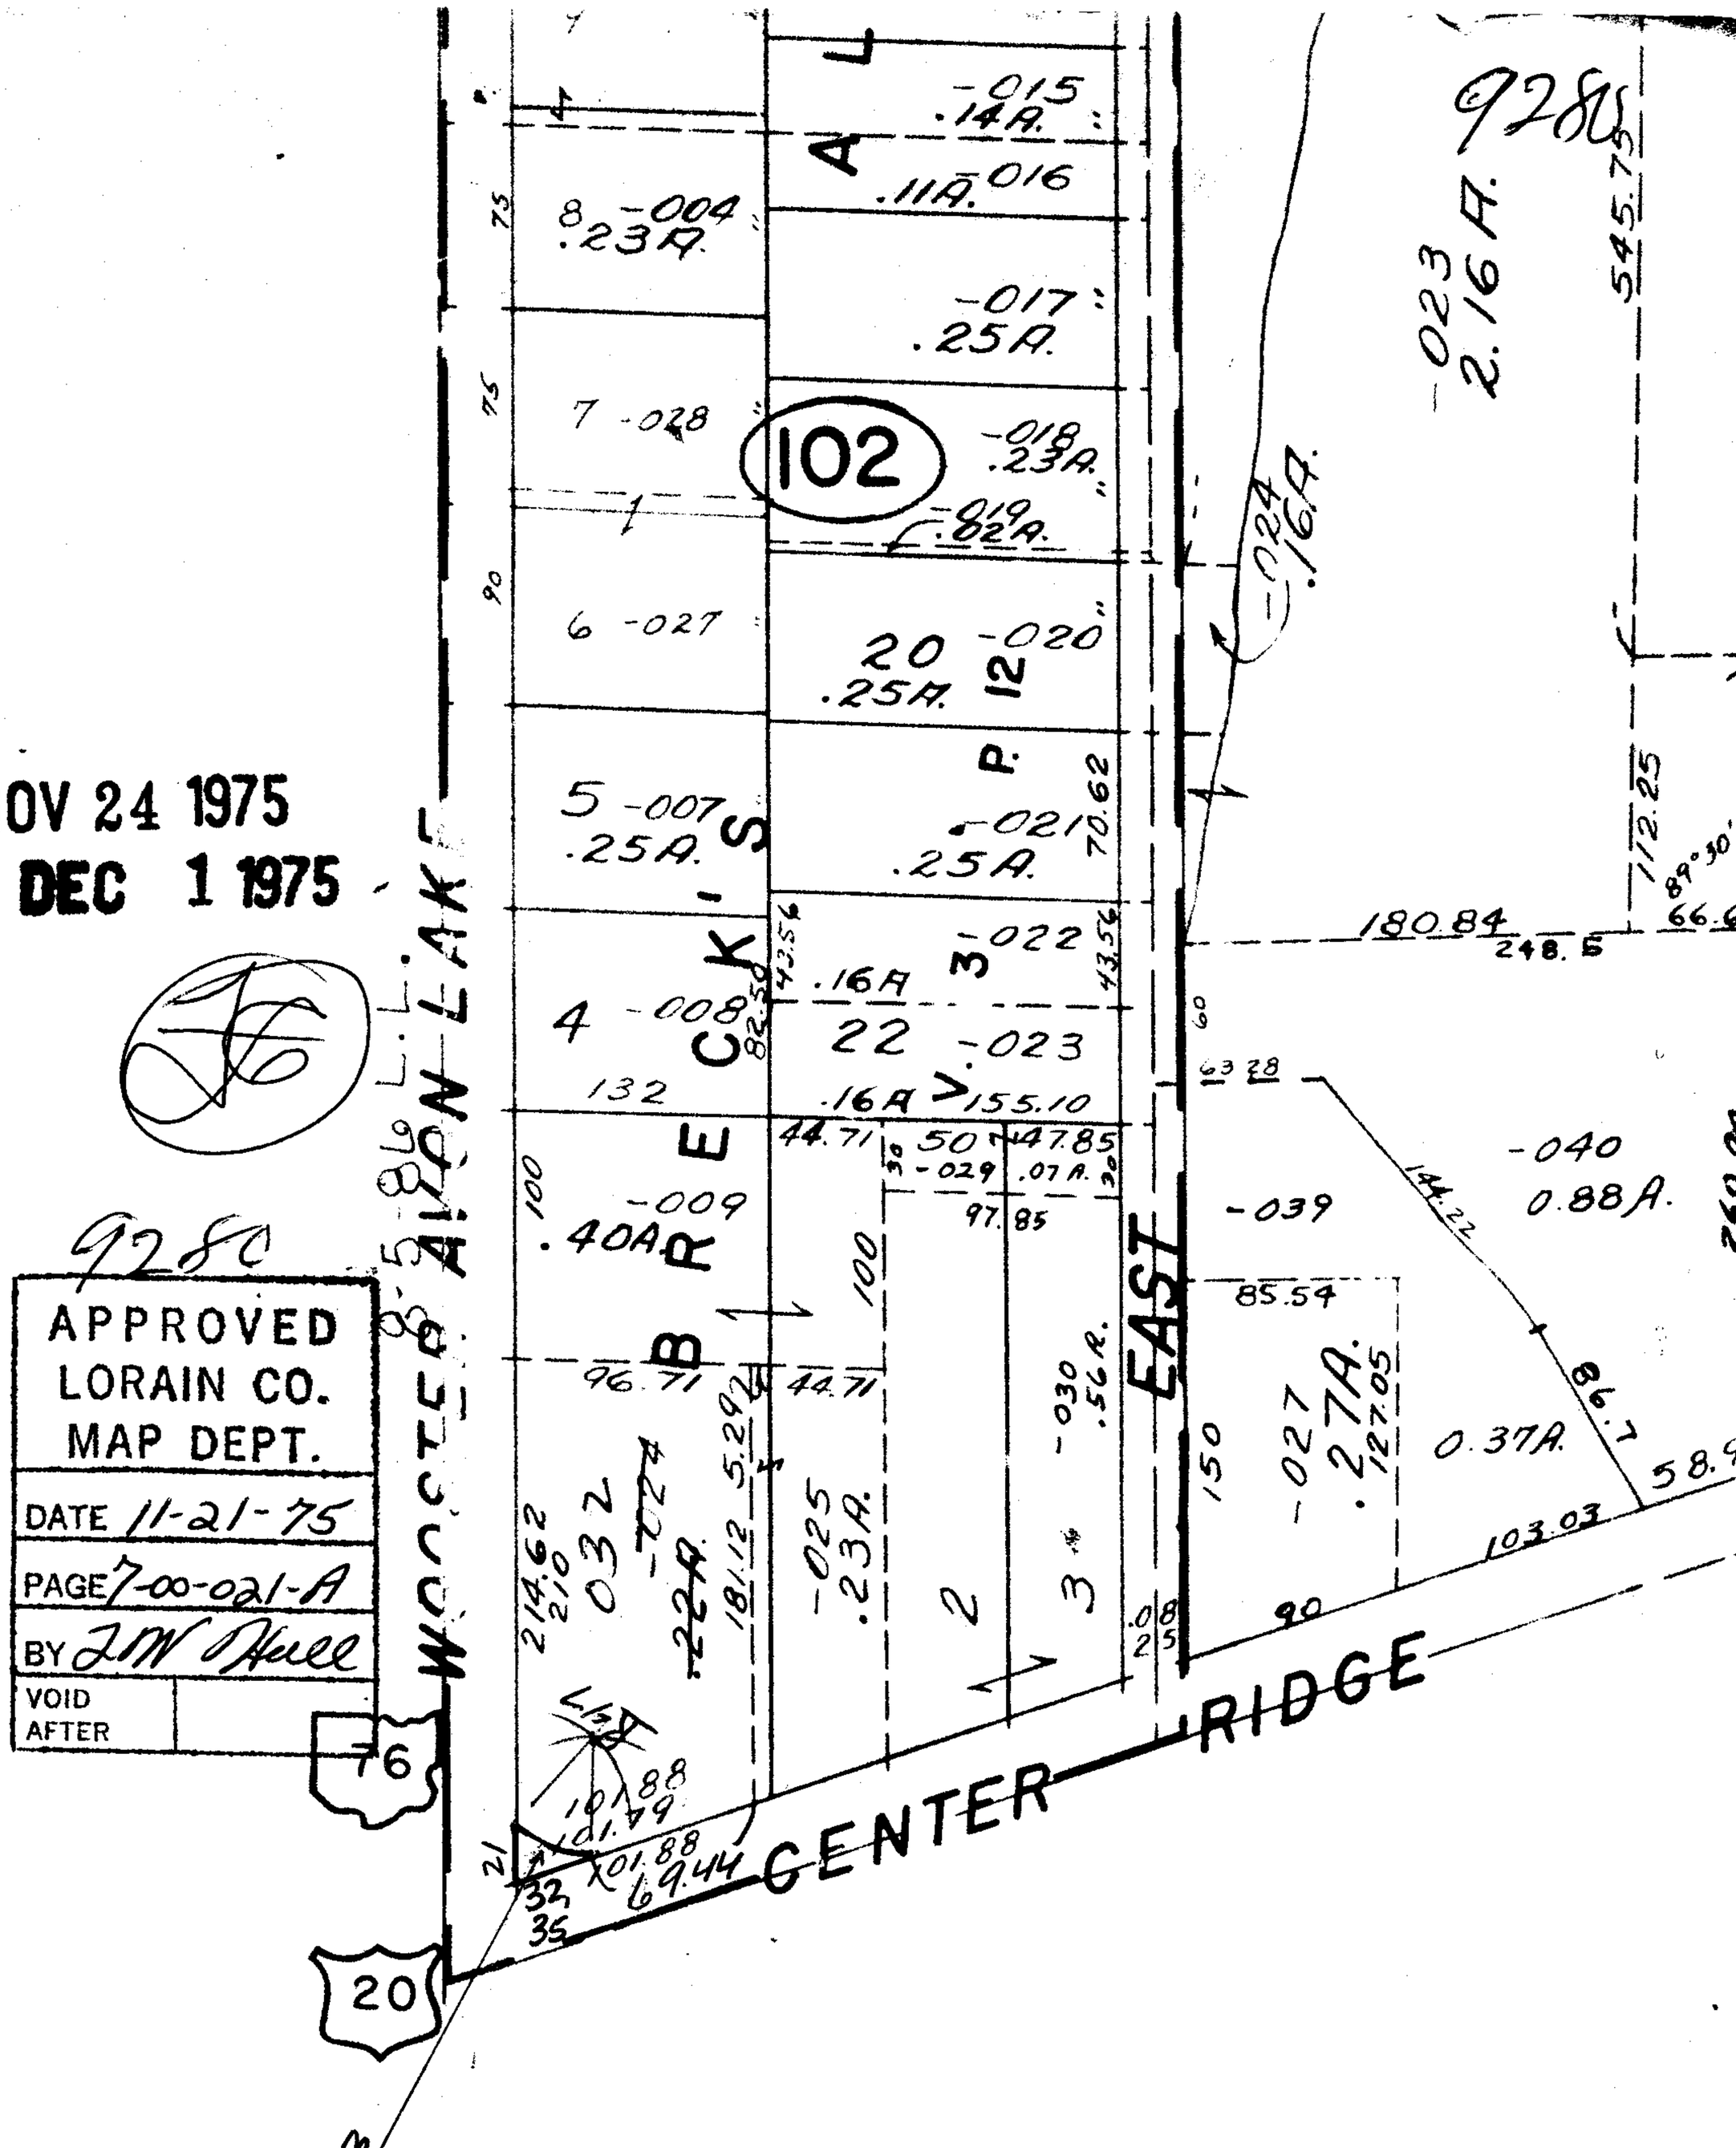

33.83
-031

Copyright 1964
Revised 10-1-95

7-00-021-A

RIDGEVILL

SCALE: 1" = 100'