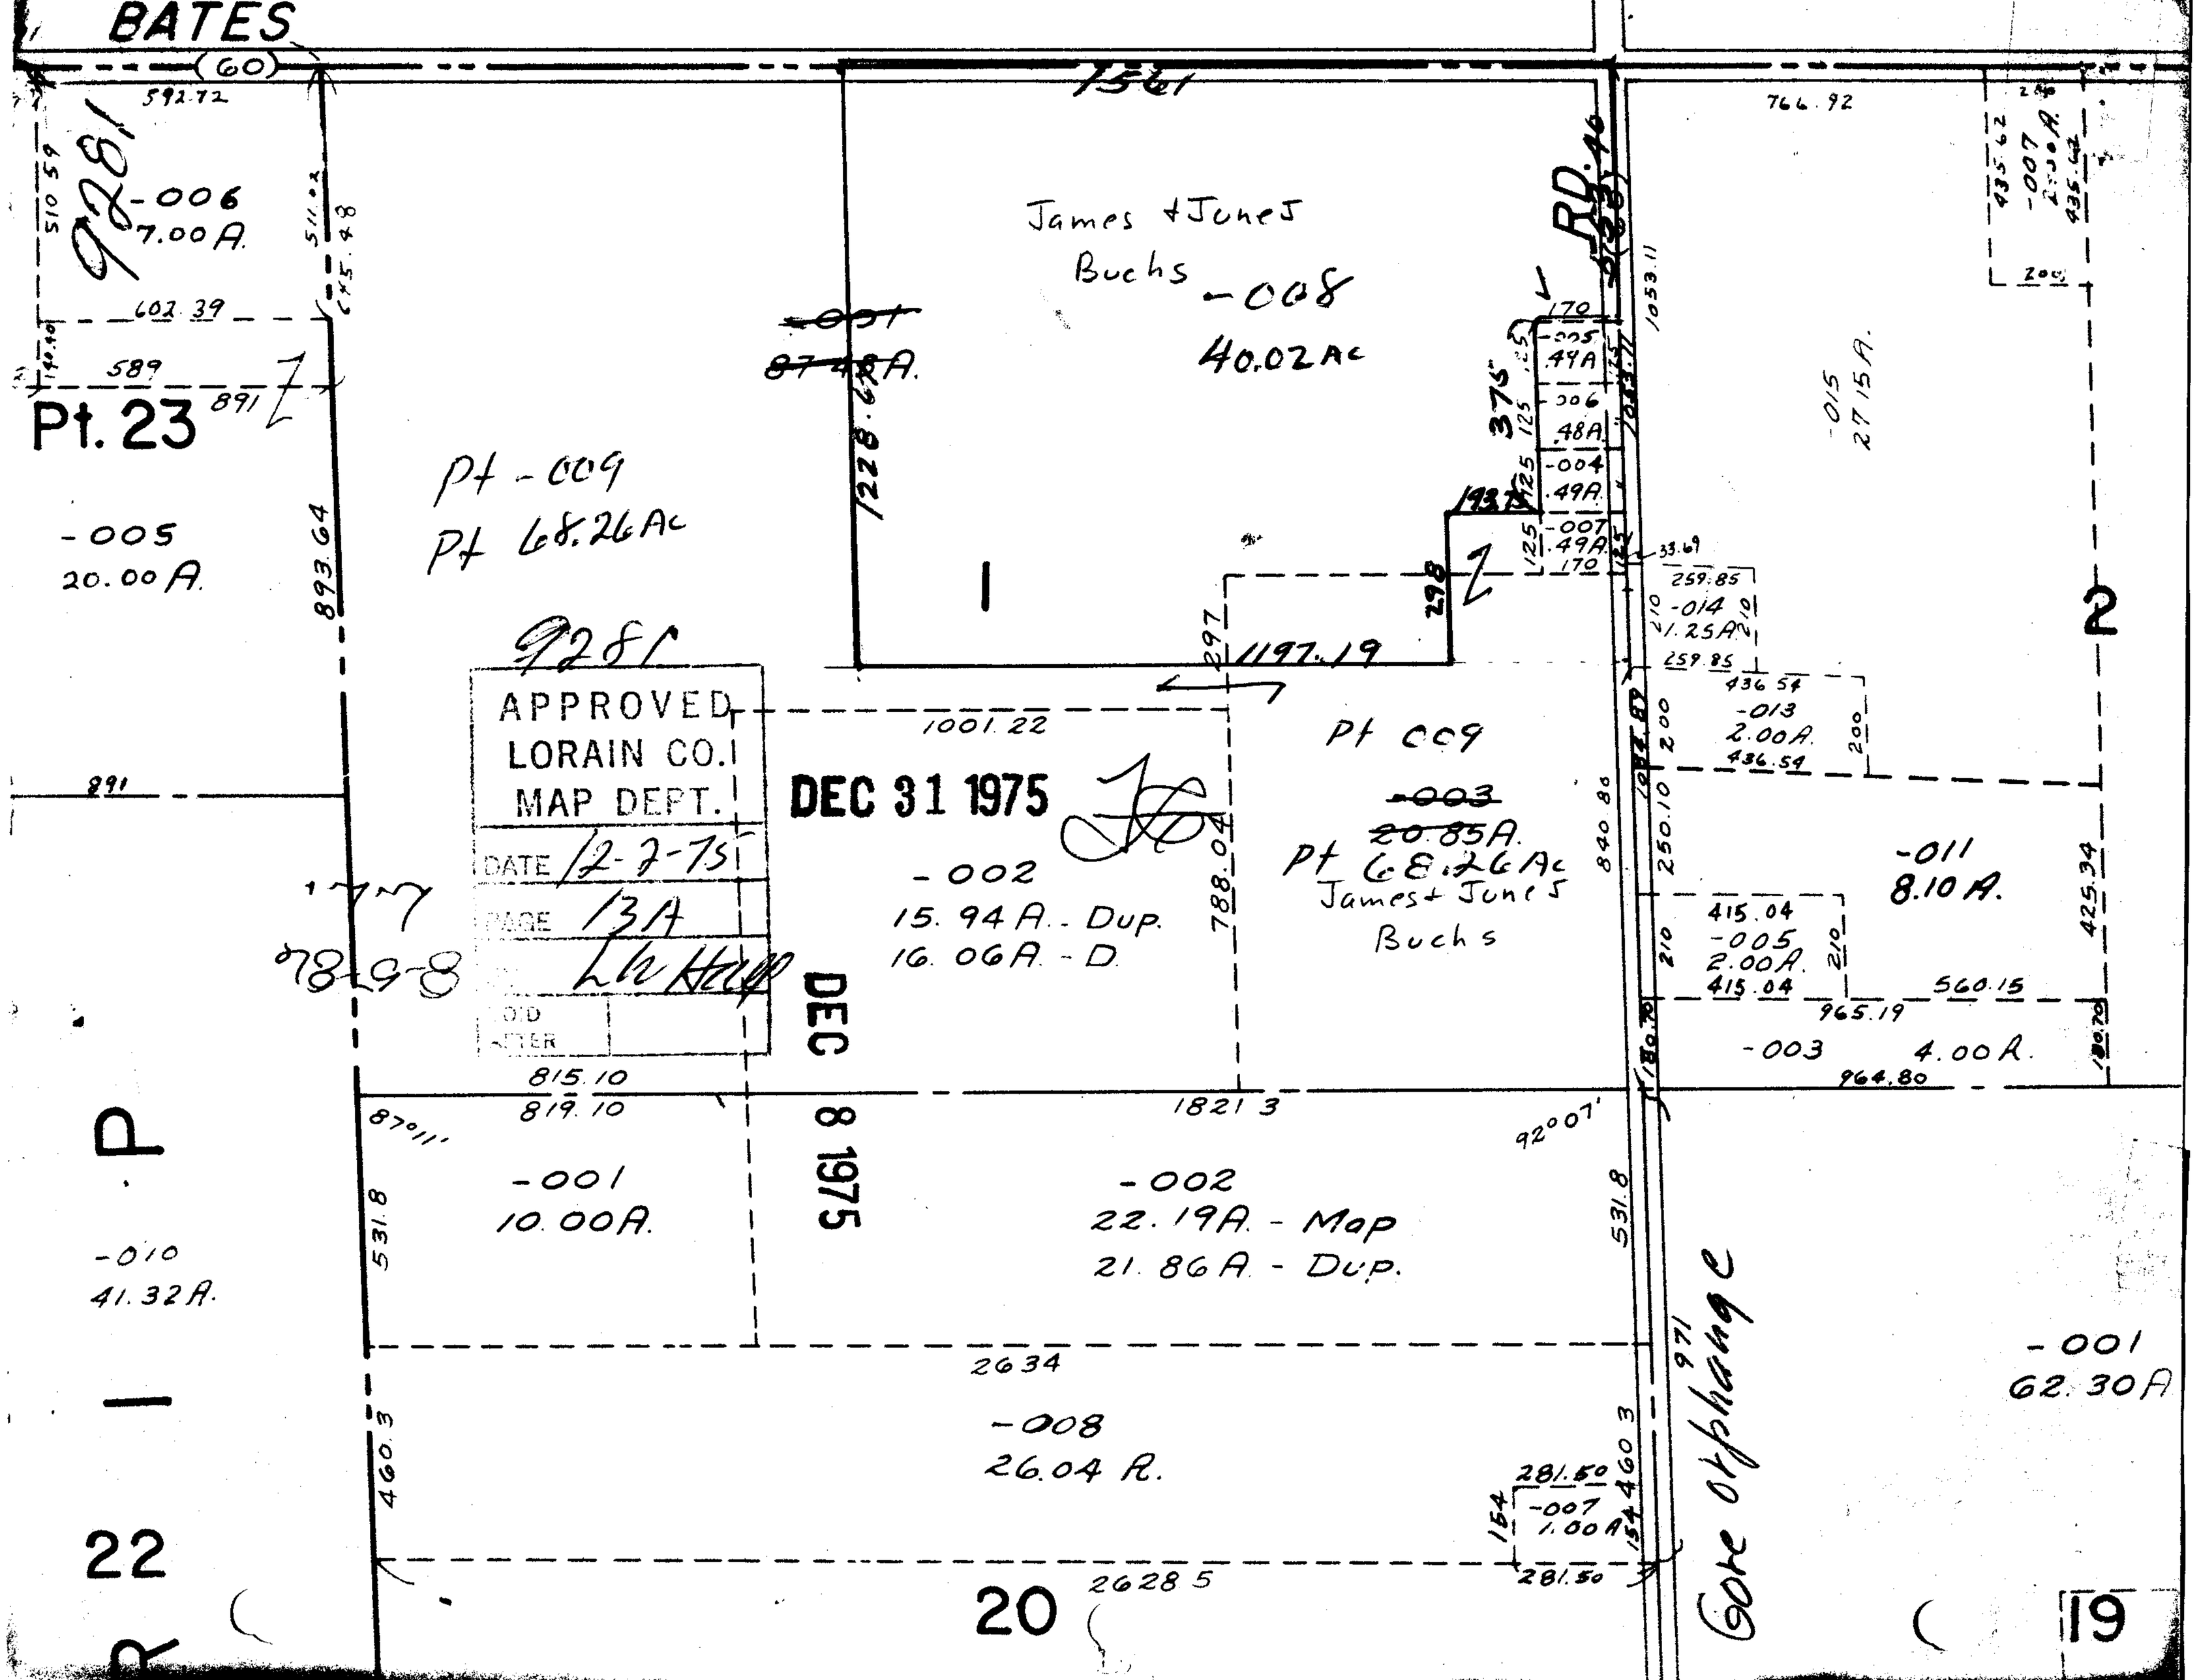
BATES
(60)
1561
James + Jones Buchs
-008
40.02 Ac
RD.
9281
-006
7.00 A.
Pt. 23
-005
20.00 A.
Pt -009
Pt 68.26 Ac
1228.67
1197.19
1001.22
Pt 009
-003
20.85 A.
Pt 68.26 Ac
James + Jones Buchs
-002
15.94 A. - Dup.
16.06 A. - D.
-011
8.10 A.
-015
27.15 A.
-014
1.25 A.
-013
2.00 A.
-005
2.00 A.
-003
4.00 A.
-001
10.00 A.
-002
22.19 A. - Map
21.86 A. - Dup.
-010
41.32 A.
-008
26.04 A.
-007
1.00 A.
-001
62.30 A
Gore Orphange
22
20
19
2
1
P
R
APPROVED
LORAIN CO.
MAP DEPT.
DATE 12-2-75
PAGE 13A
DEC 31 1975
DEC 8 1975