


84

SEE 4

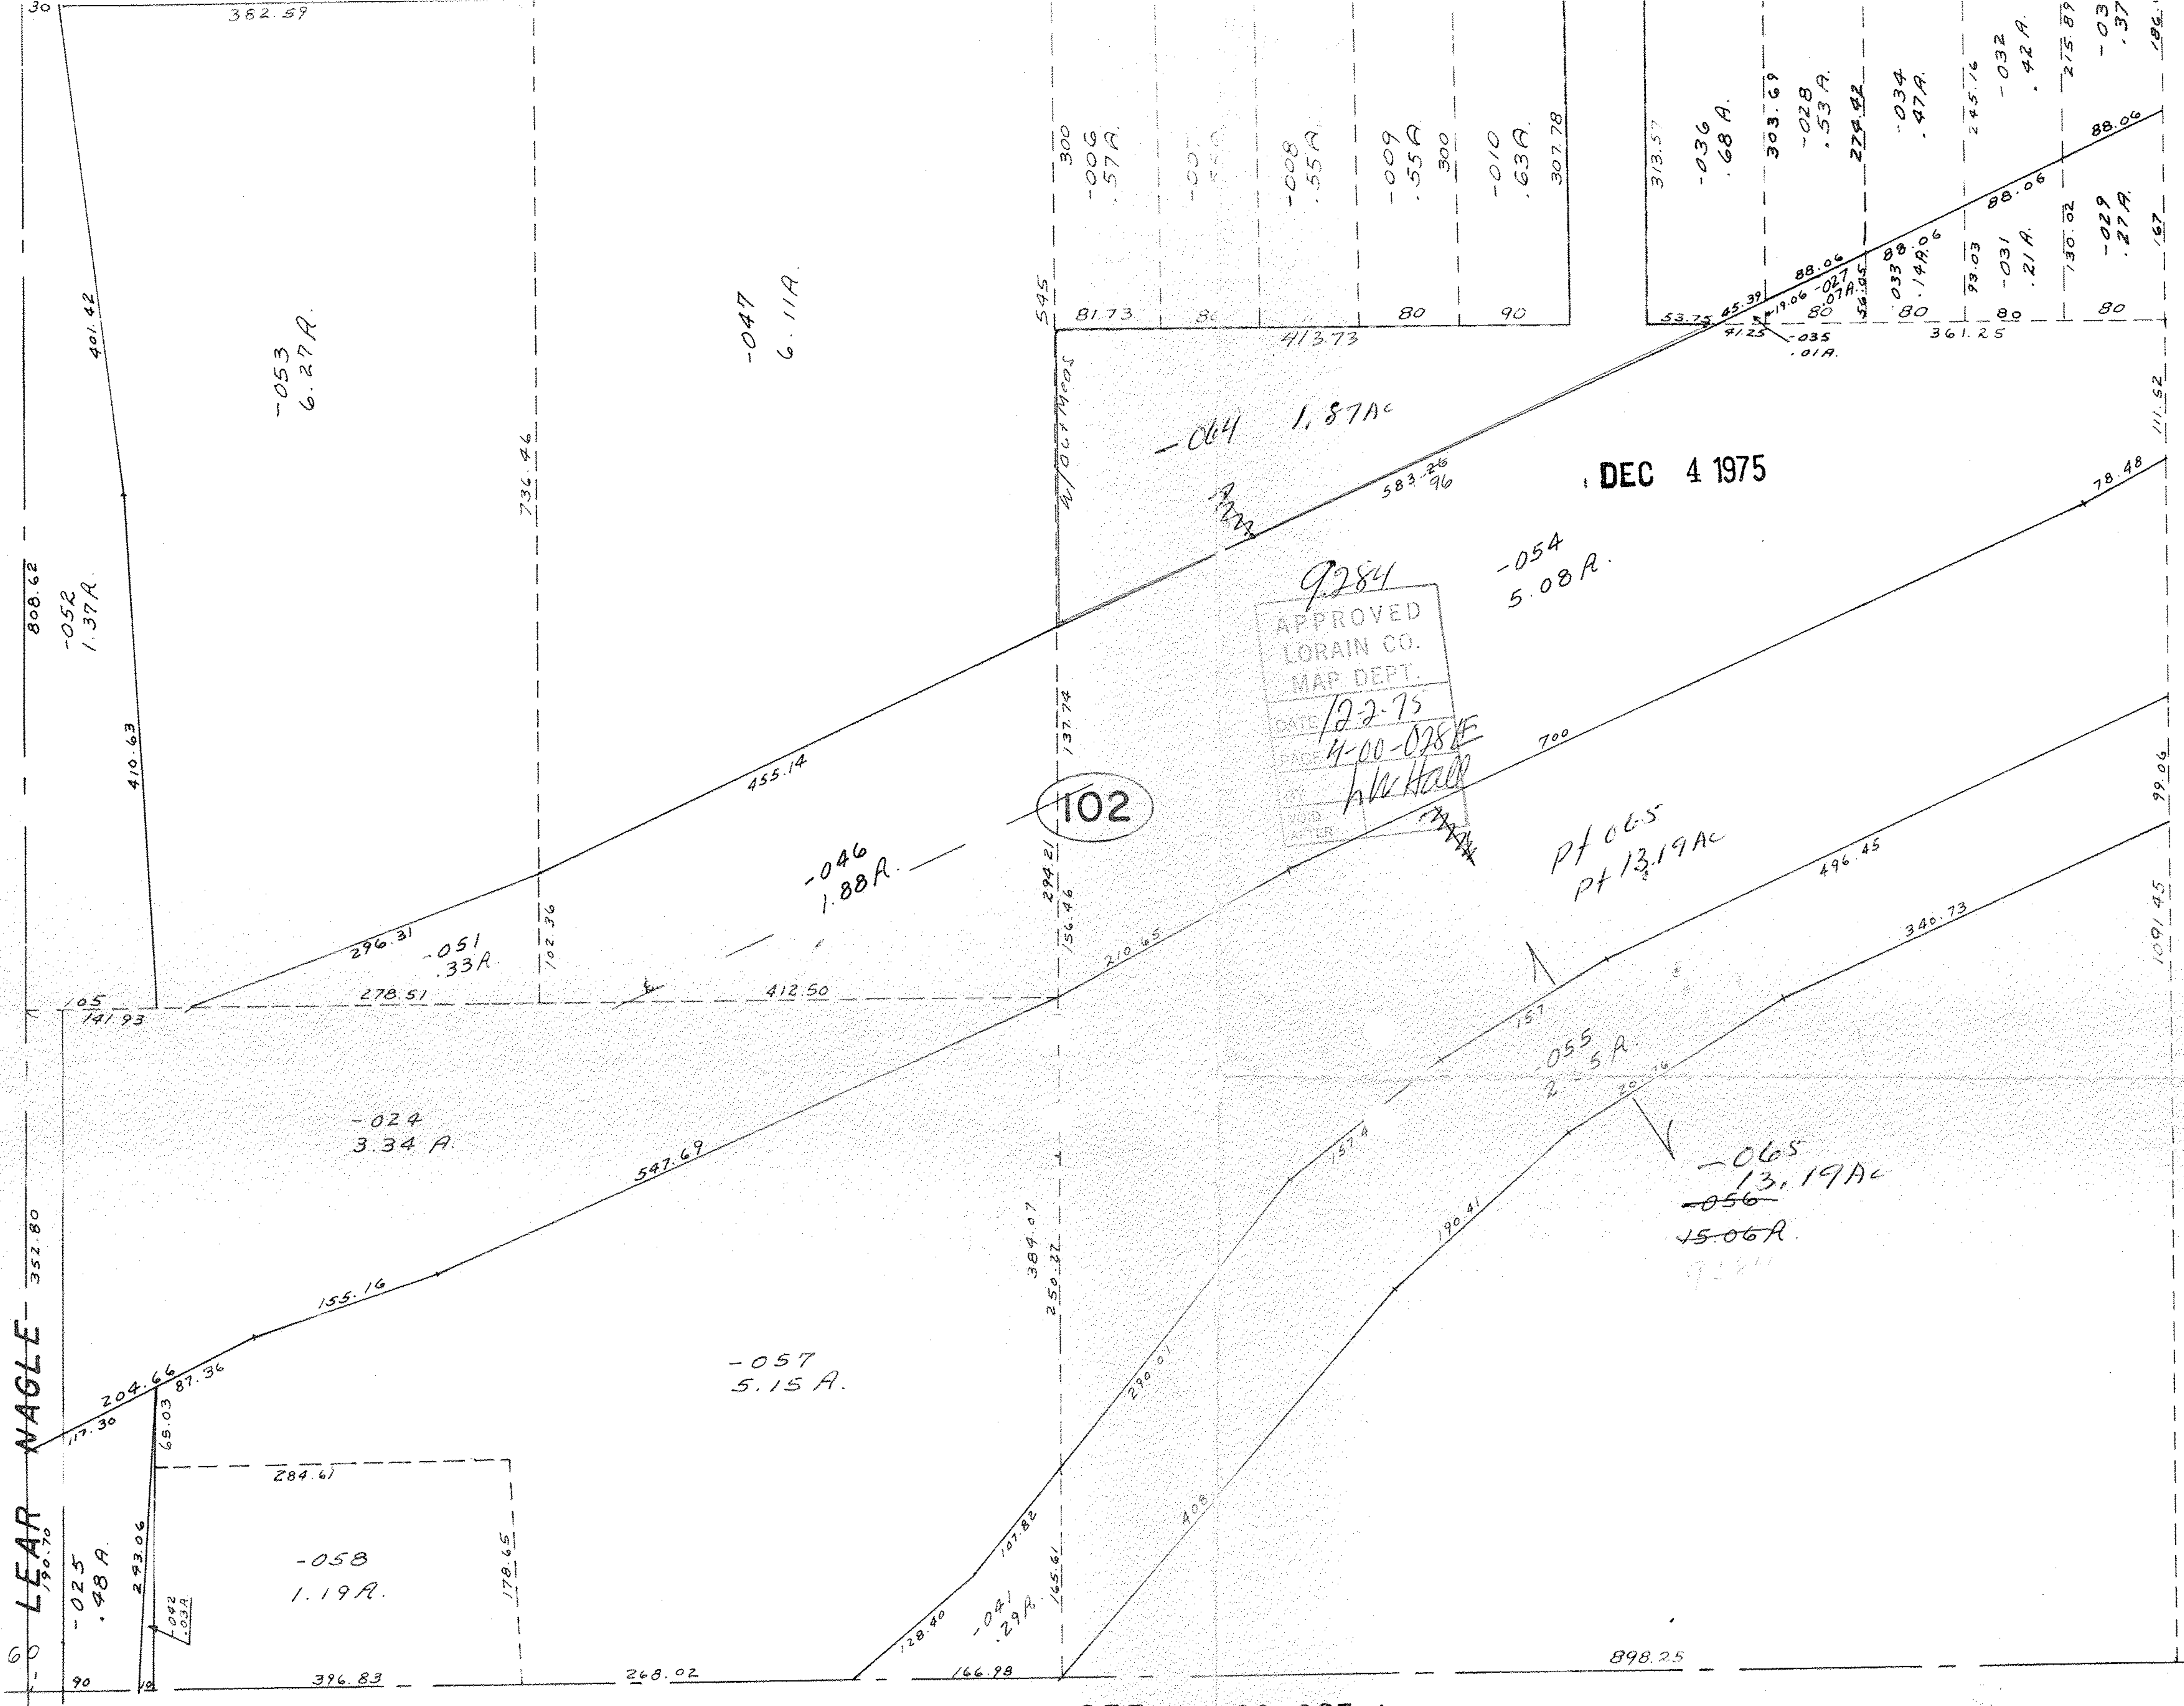

SEE


SEE 4-00-027-A

AVON VILLAGE

9284
11-00-027E