


See 6-125
A/B

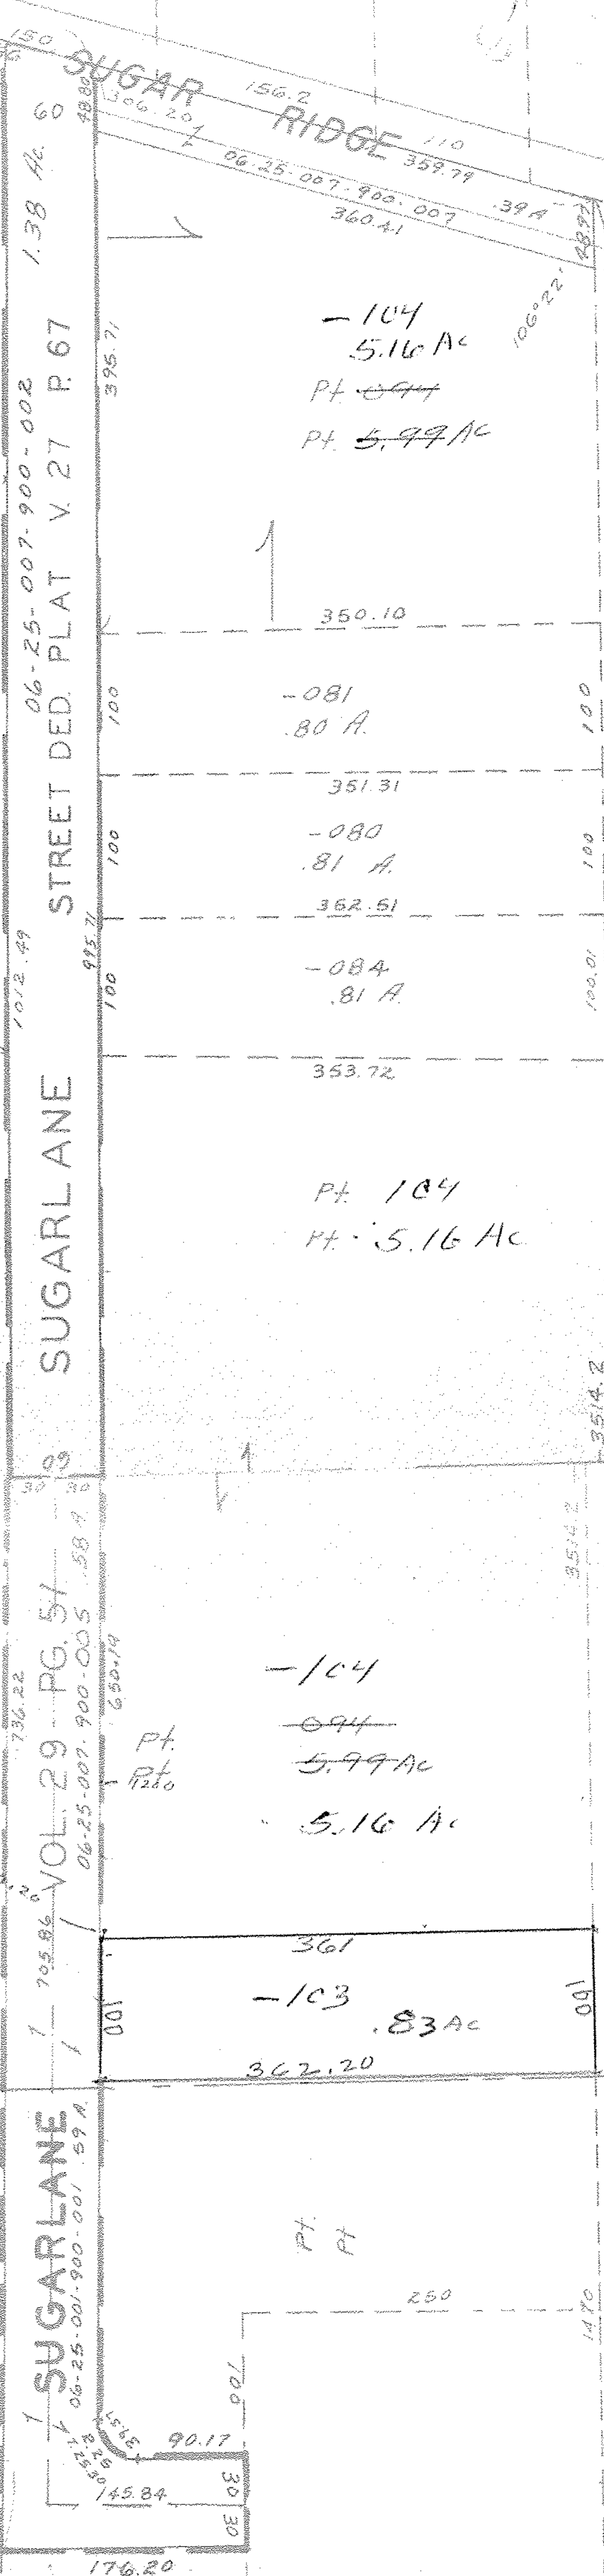

9286

DEC 4 1975



DEC 1 1975

9286

APPROVED
LORAIN CO.
MAP DEPT.
DATE 12-2-75
PAGE 6-126
BY L.W. Hall
VOID AFTER

6-126

9286

7

6-144

9286

APPROVED
LORAIN CO.
MAP DEPT.
DATE 12-2-75
PAGE 6-144
BY L.W. Hall
VOID AFTER

See 6-144
Also

SUGARLANE STREET DED. PLAT V. 27 P. 67

SUGARLANE VOL. 29 PG. 51

SUGAR RIDGE

SUGARLANE