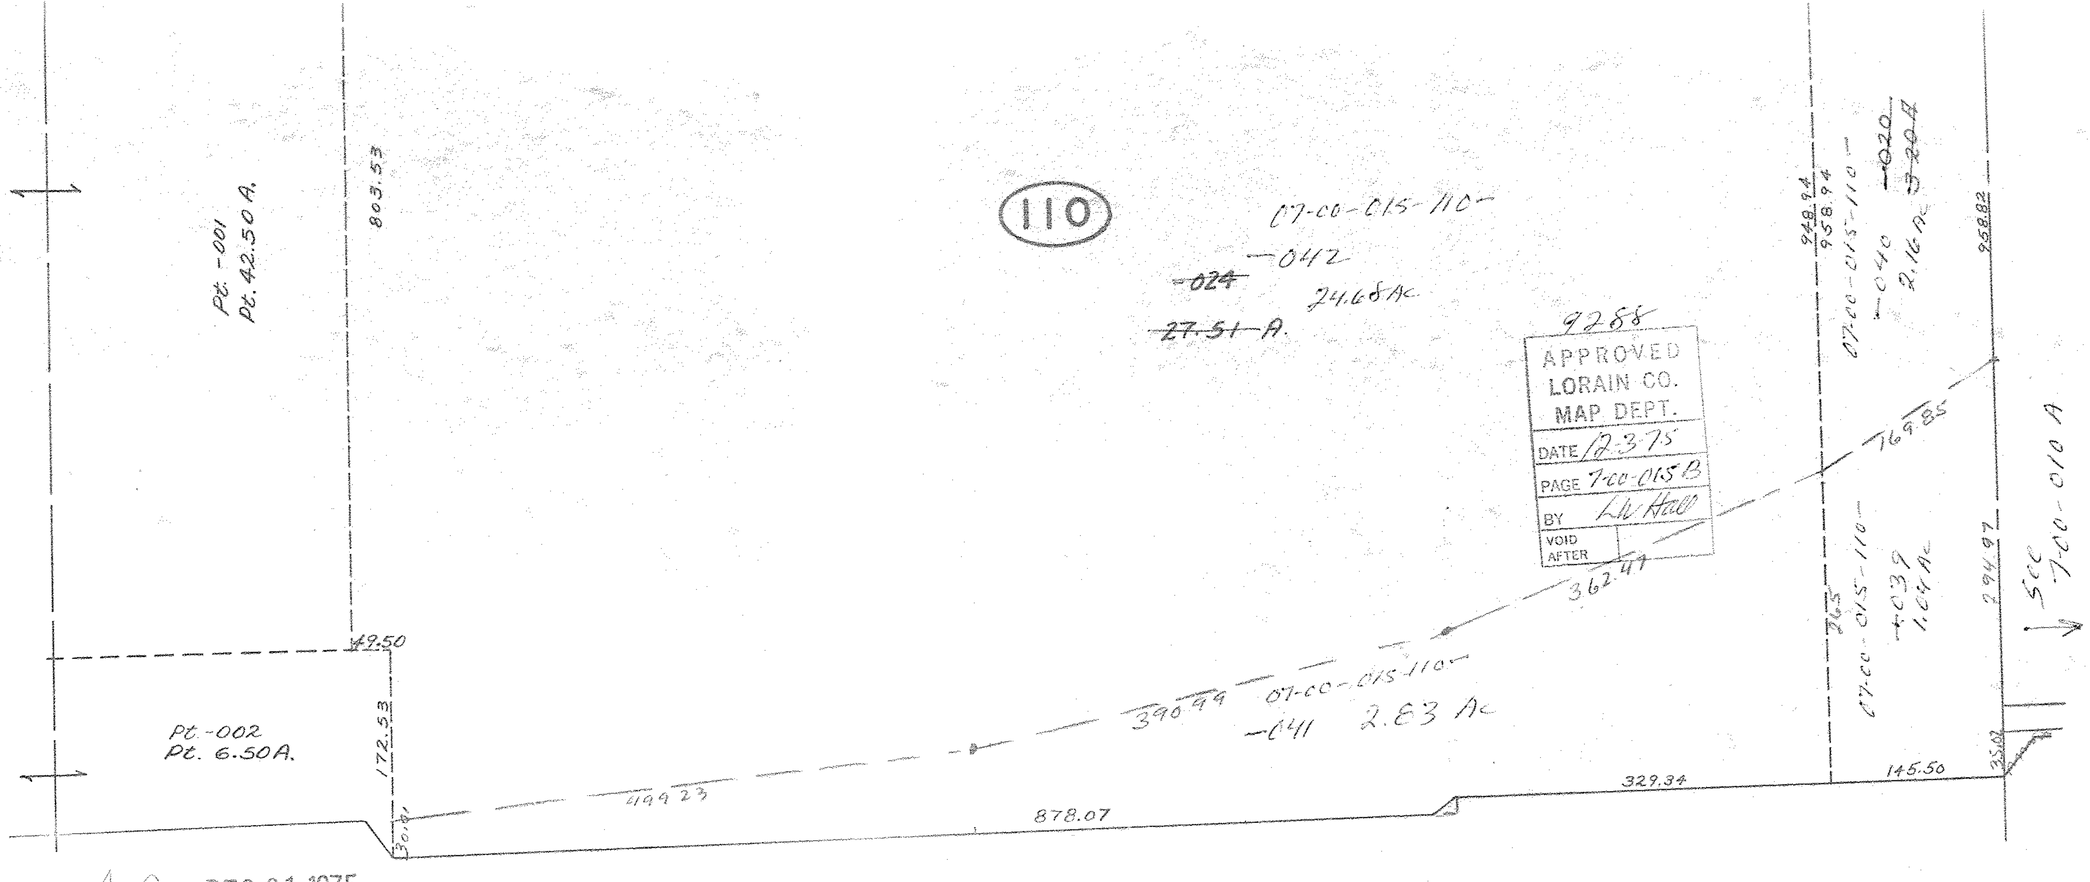
110
Pt. -001
Pt. 42.50 A.
803.53
07-00-015-110-
-042
-024
24.68Ac
27.51 A.
9288
APPROVED
LORAIN CO.
MAP DEPT.
DATE 12-3-75
PAGE 7-00-015 B
BY W. Hall
VOID AFTER
948.94
958.94
07-00-015-110-
-040
-020
2.16 Ac
958.82
49.50
Pt. -002
Pt. 6.50 A.
172.53
30.81
499.23
390.99
07-00-015-110-
-041
2.83 Ac
362.47
169.85
07-00-015-110-
-039
1.64 Ac
294.97
See 7-00-010 A
329.34
145.50
878.07
DEC 31 1975
OHIO
SEE 7-00-015-D
TURNPIKE
DEC 5 1975