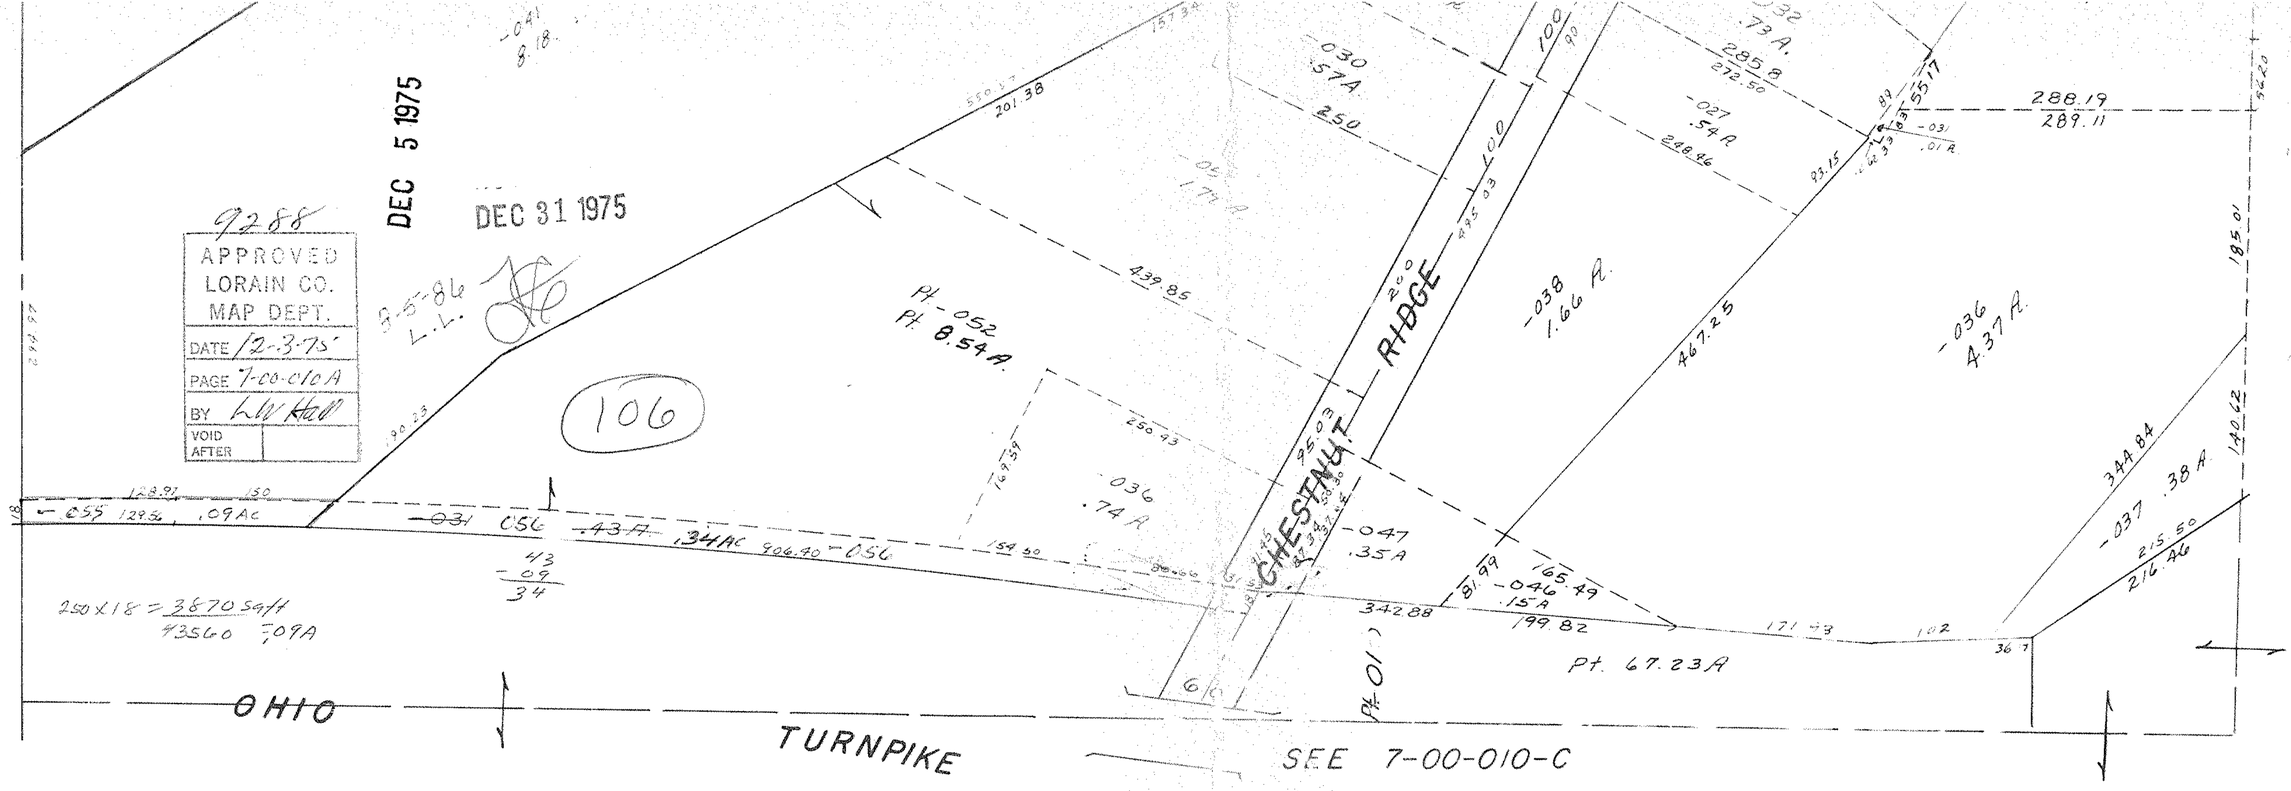

1964
23-74

7-00-010-A

RIDGEVILLE TWP.

SCALE: 1" = 100'

N.W. 1/4 LOT 10