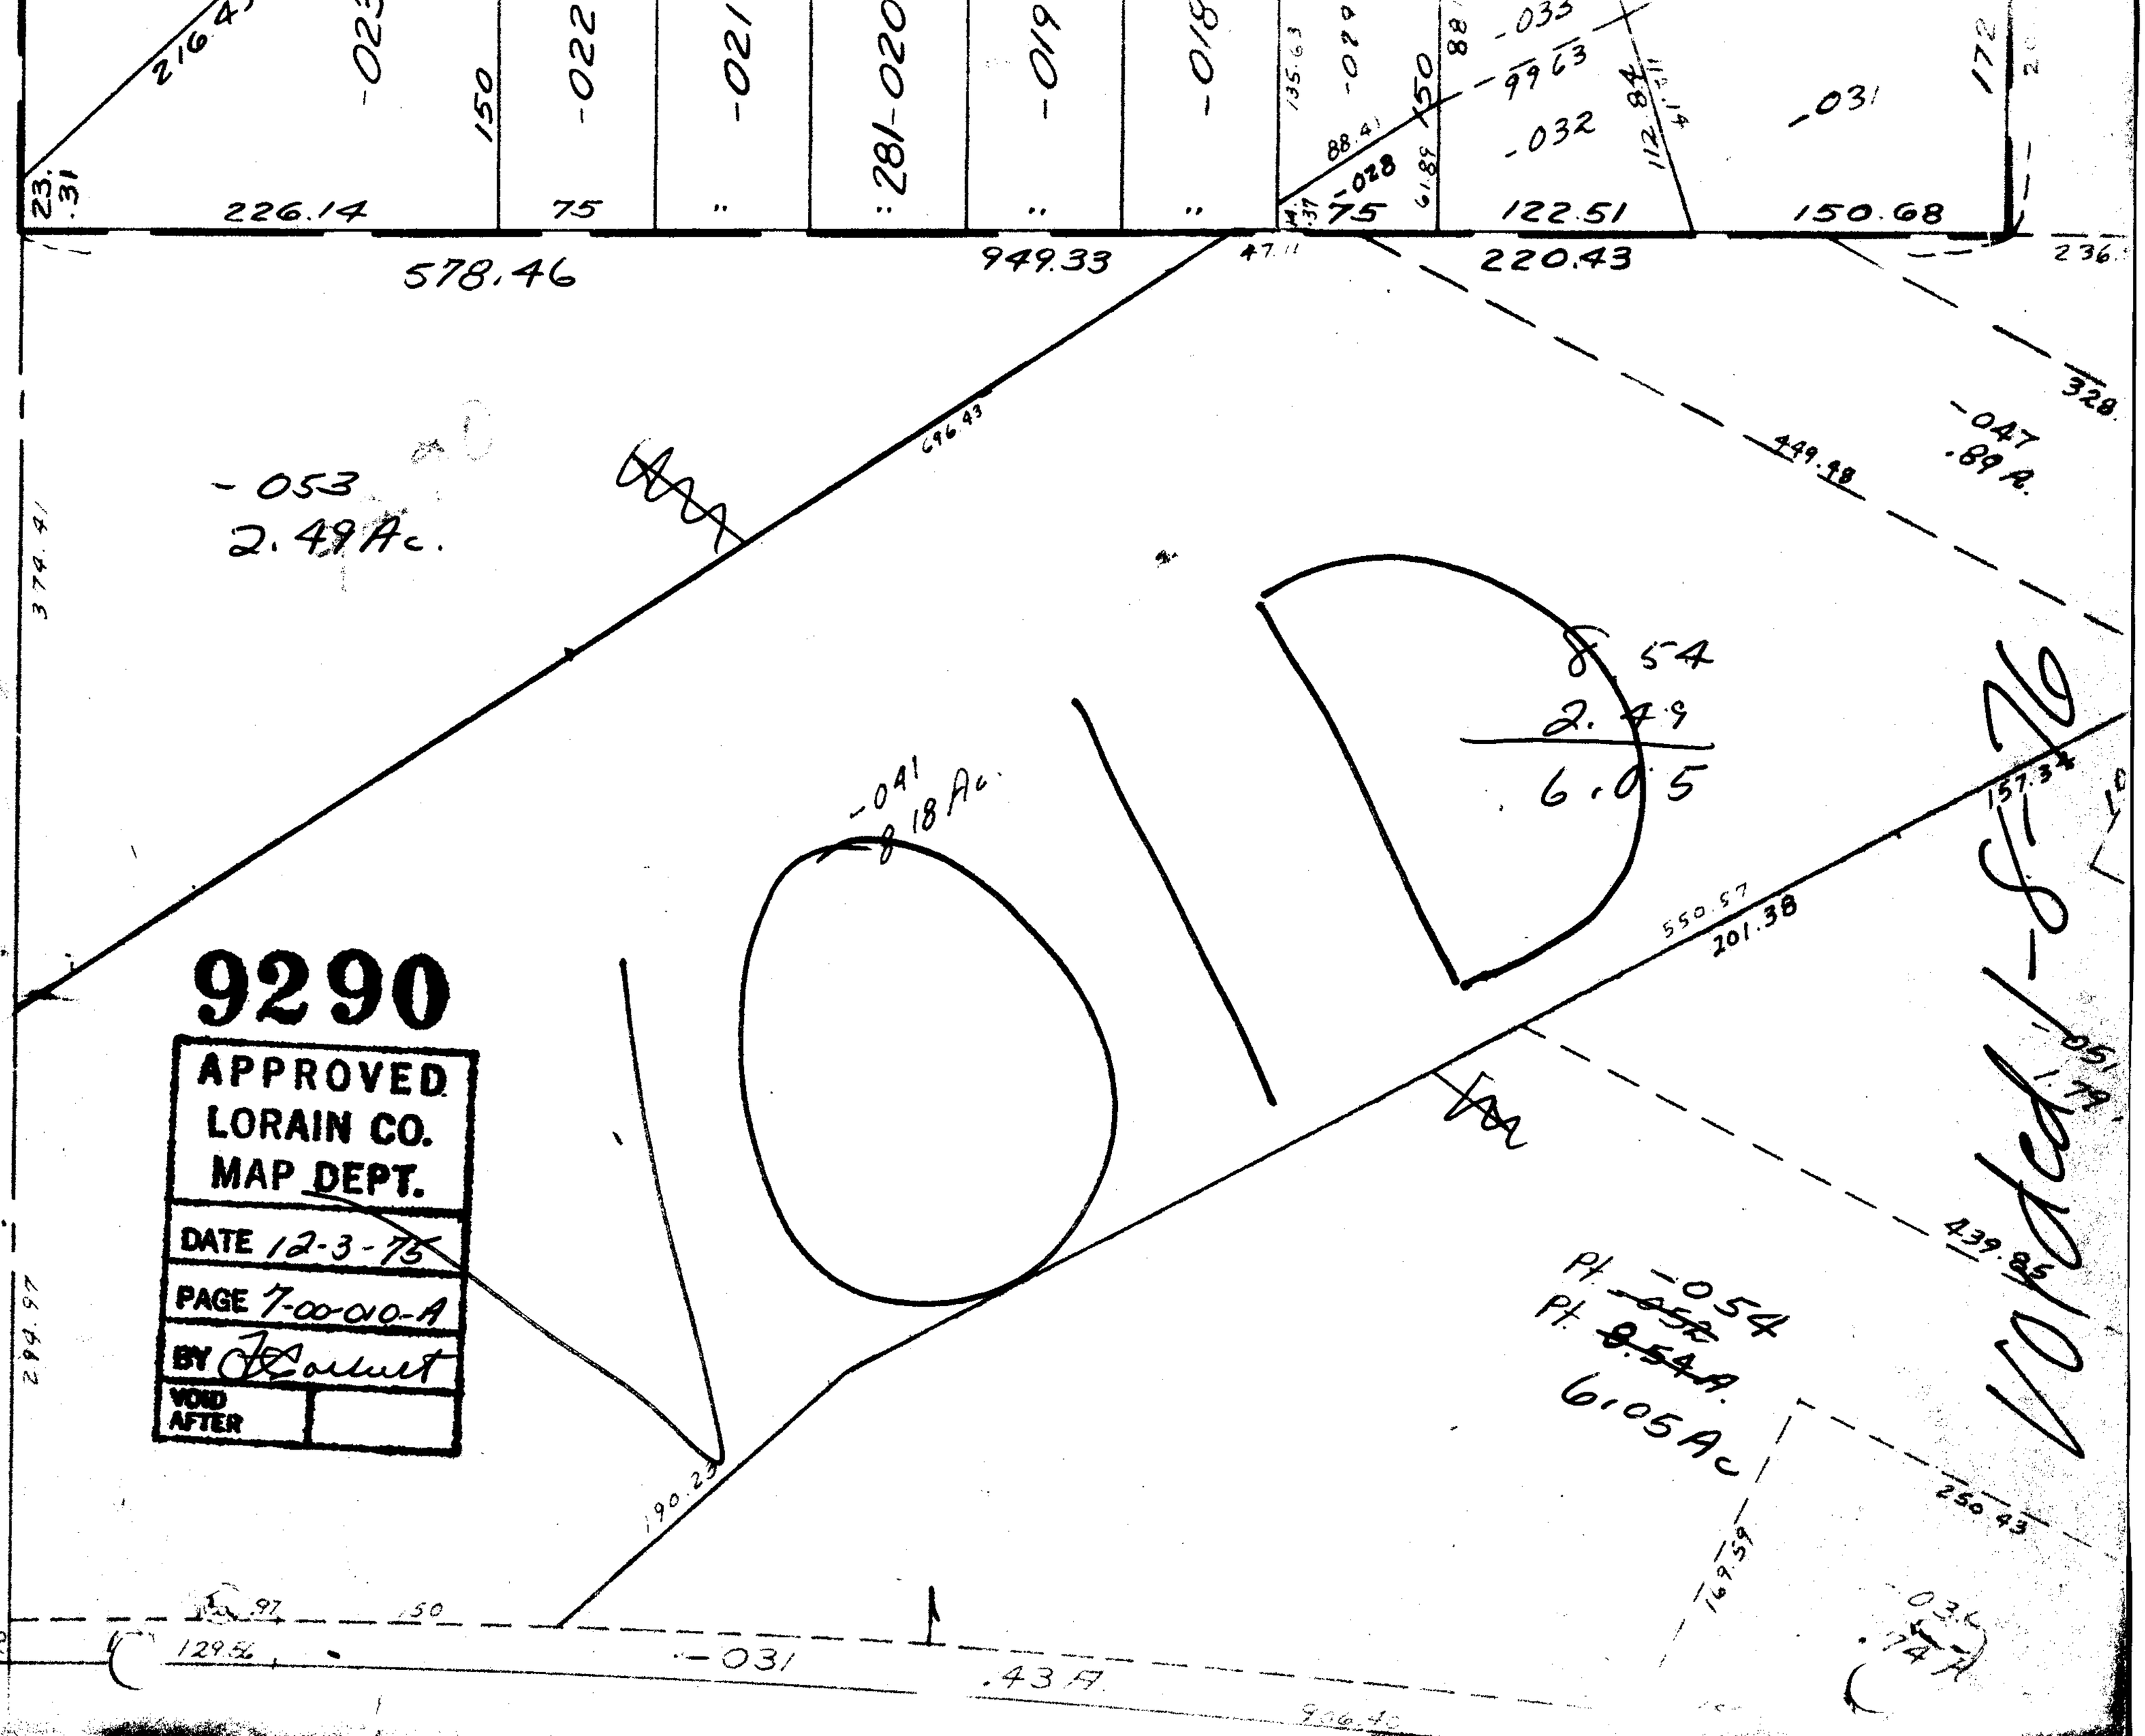

9290

APPROVED
LORAIN CO.
MAP DEPT.

DATE 12-3-75

PAGE 7-00-010-A

BY [signature]

VOID AFTER

Voided 1-8-76