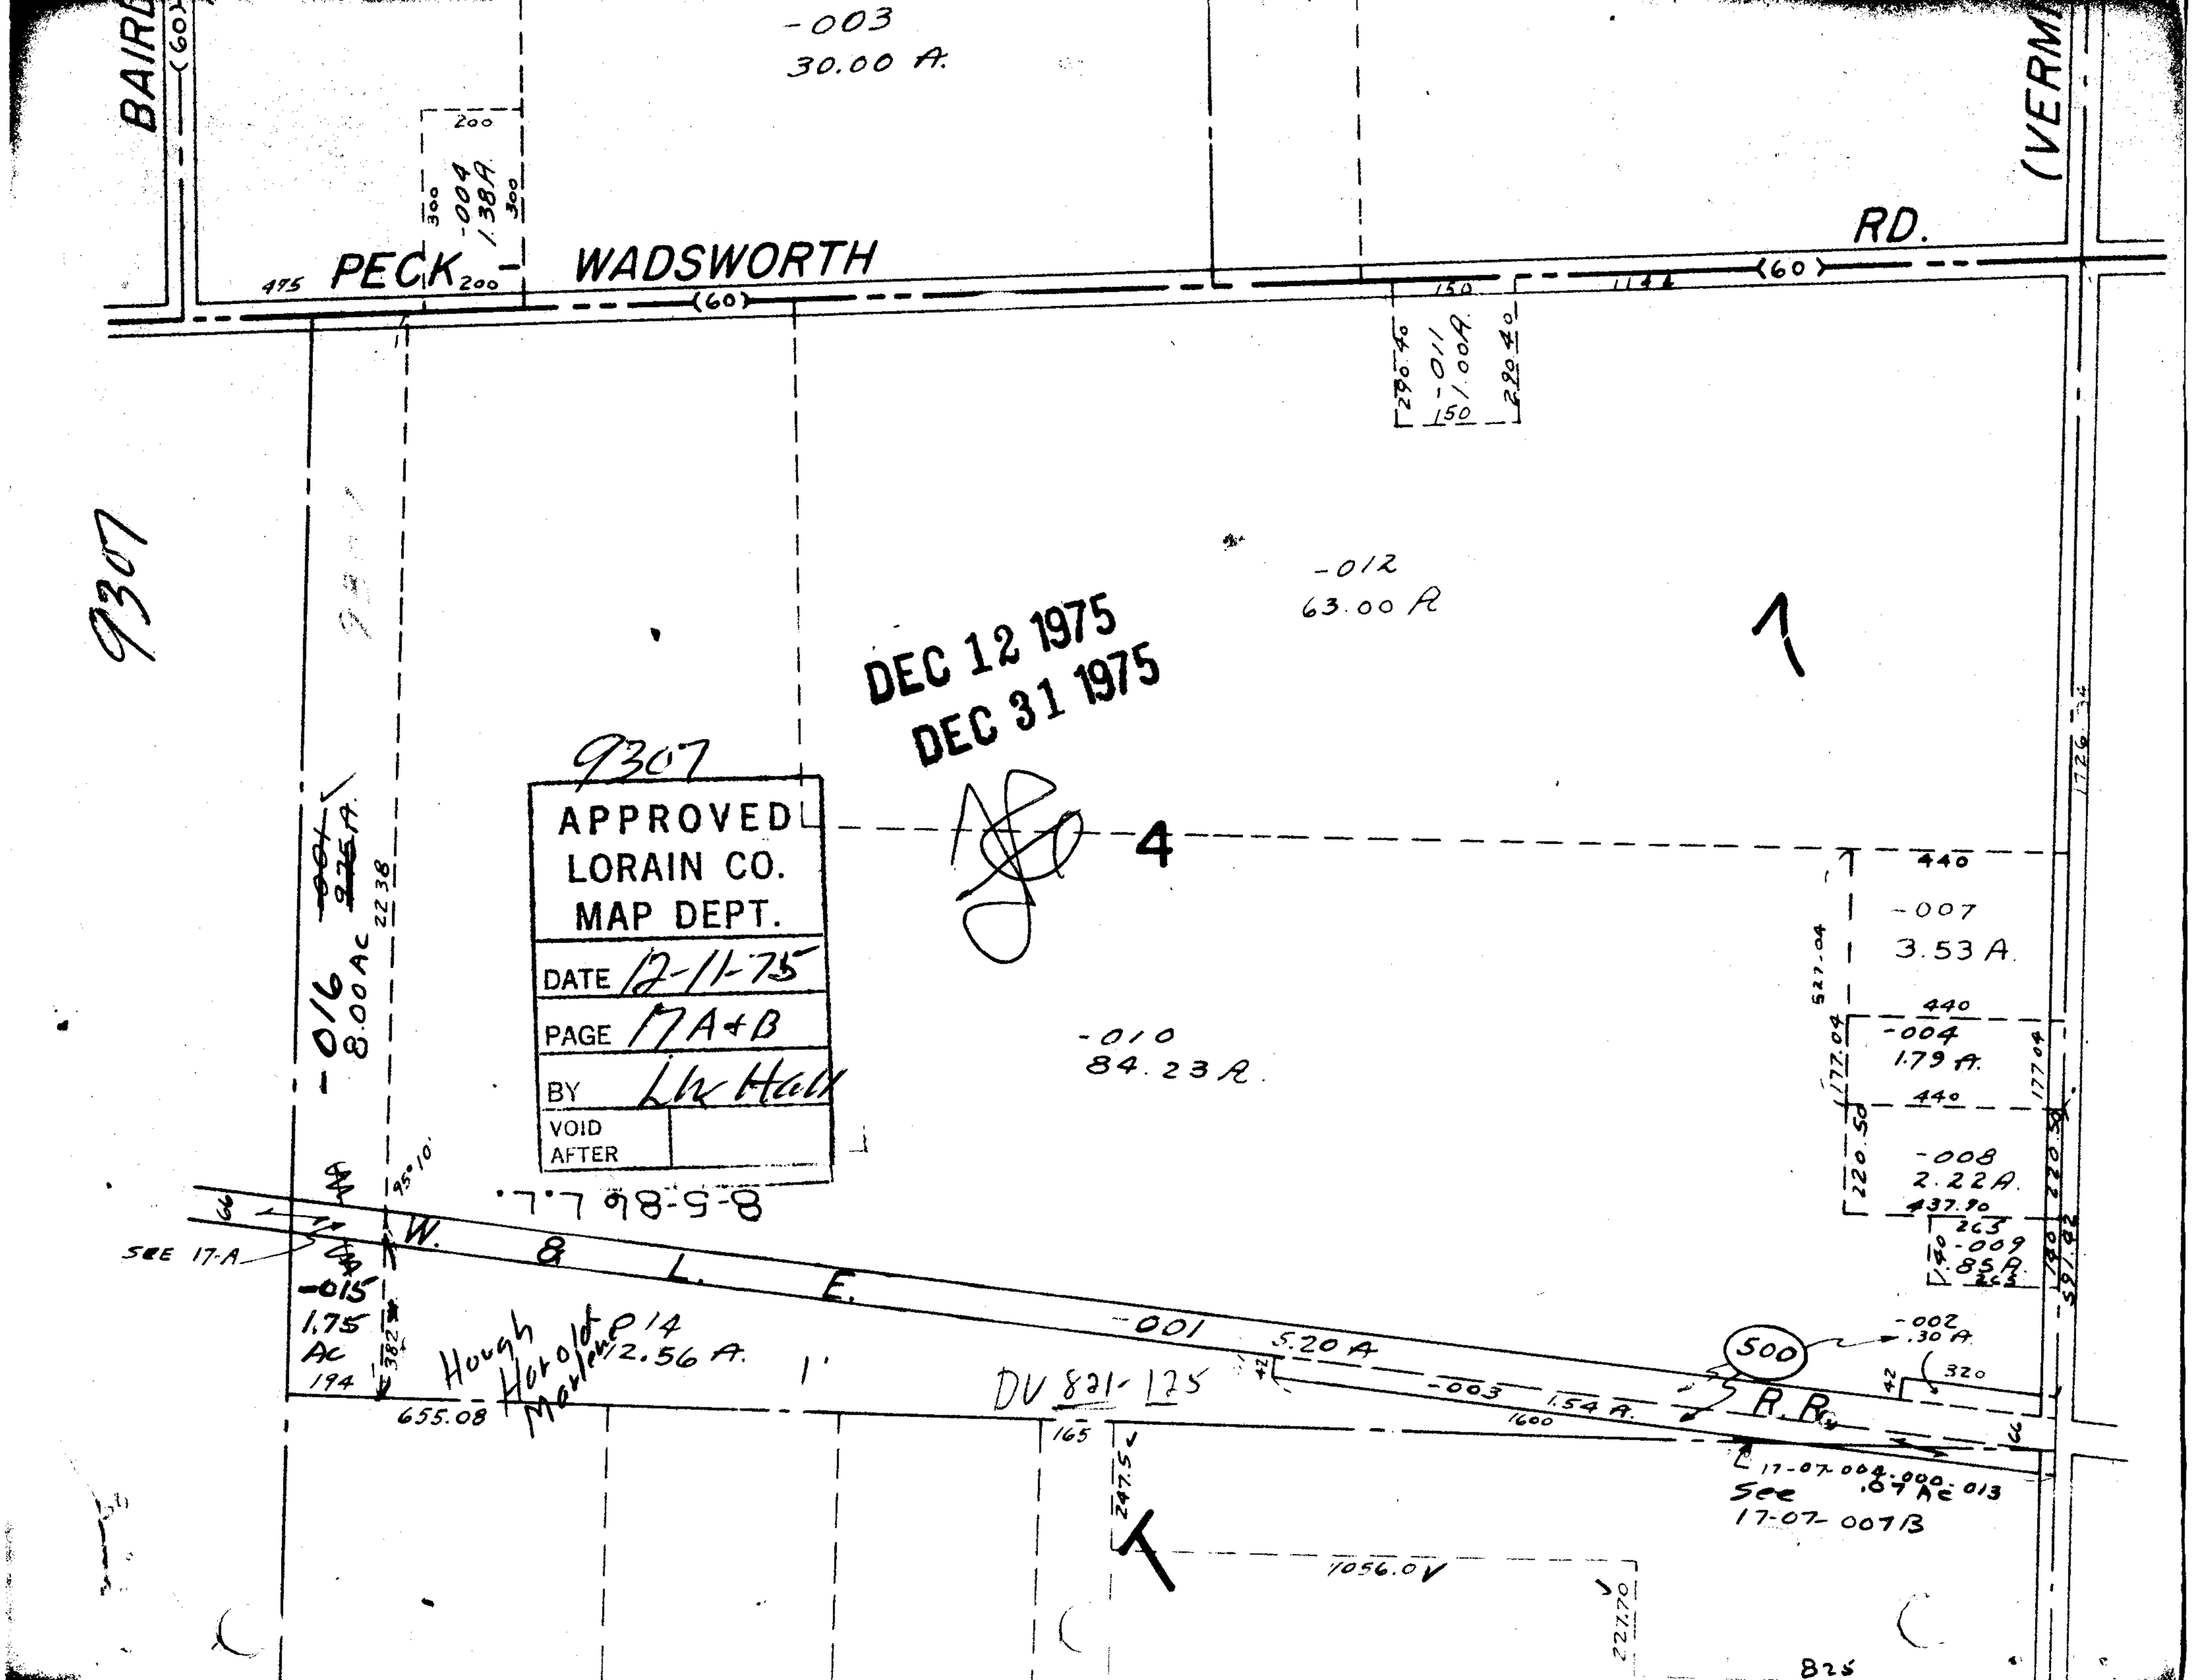

BAIRD
(60)
-003
30.00 A.
200
300
-004
1.38A
300
PECK - WADSWORTH
RD.
(VERM
475
200
(60)
150
1144
(60)
290.40
-011
1.00A
150
290.40
9307
-012
63.00 A
DEC 12 1975
DEC 31 1975
9307
APPROVED
LORAIN CO.
MAP DEPT.
DATE 12-11-75
PAGE 17A+B
BY Lk Hall
VOID
AFTER
4
440
-007
3.53 A.
527.04
440
-004
1.79 A.
177.04
440
-010
84.23 A.
-008
2.22A.
437.90
220.50
8-5-86 L.L.
95°10'
SEE 17-A
W. & L. E.
-015
1.75
AC
194
382
Hough
Harold
Marlene
014
12.56 A.
-001
5.20 A
-003
1.54 A.
1600
DV 821-125
500
-002
.30 A
320
R.R.
655.08
165
247.5
17-07-004-000-013
.07 AC
See
17-07-007B
1056.0
227.70
825