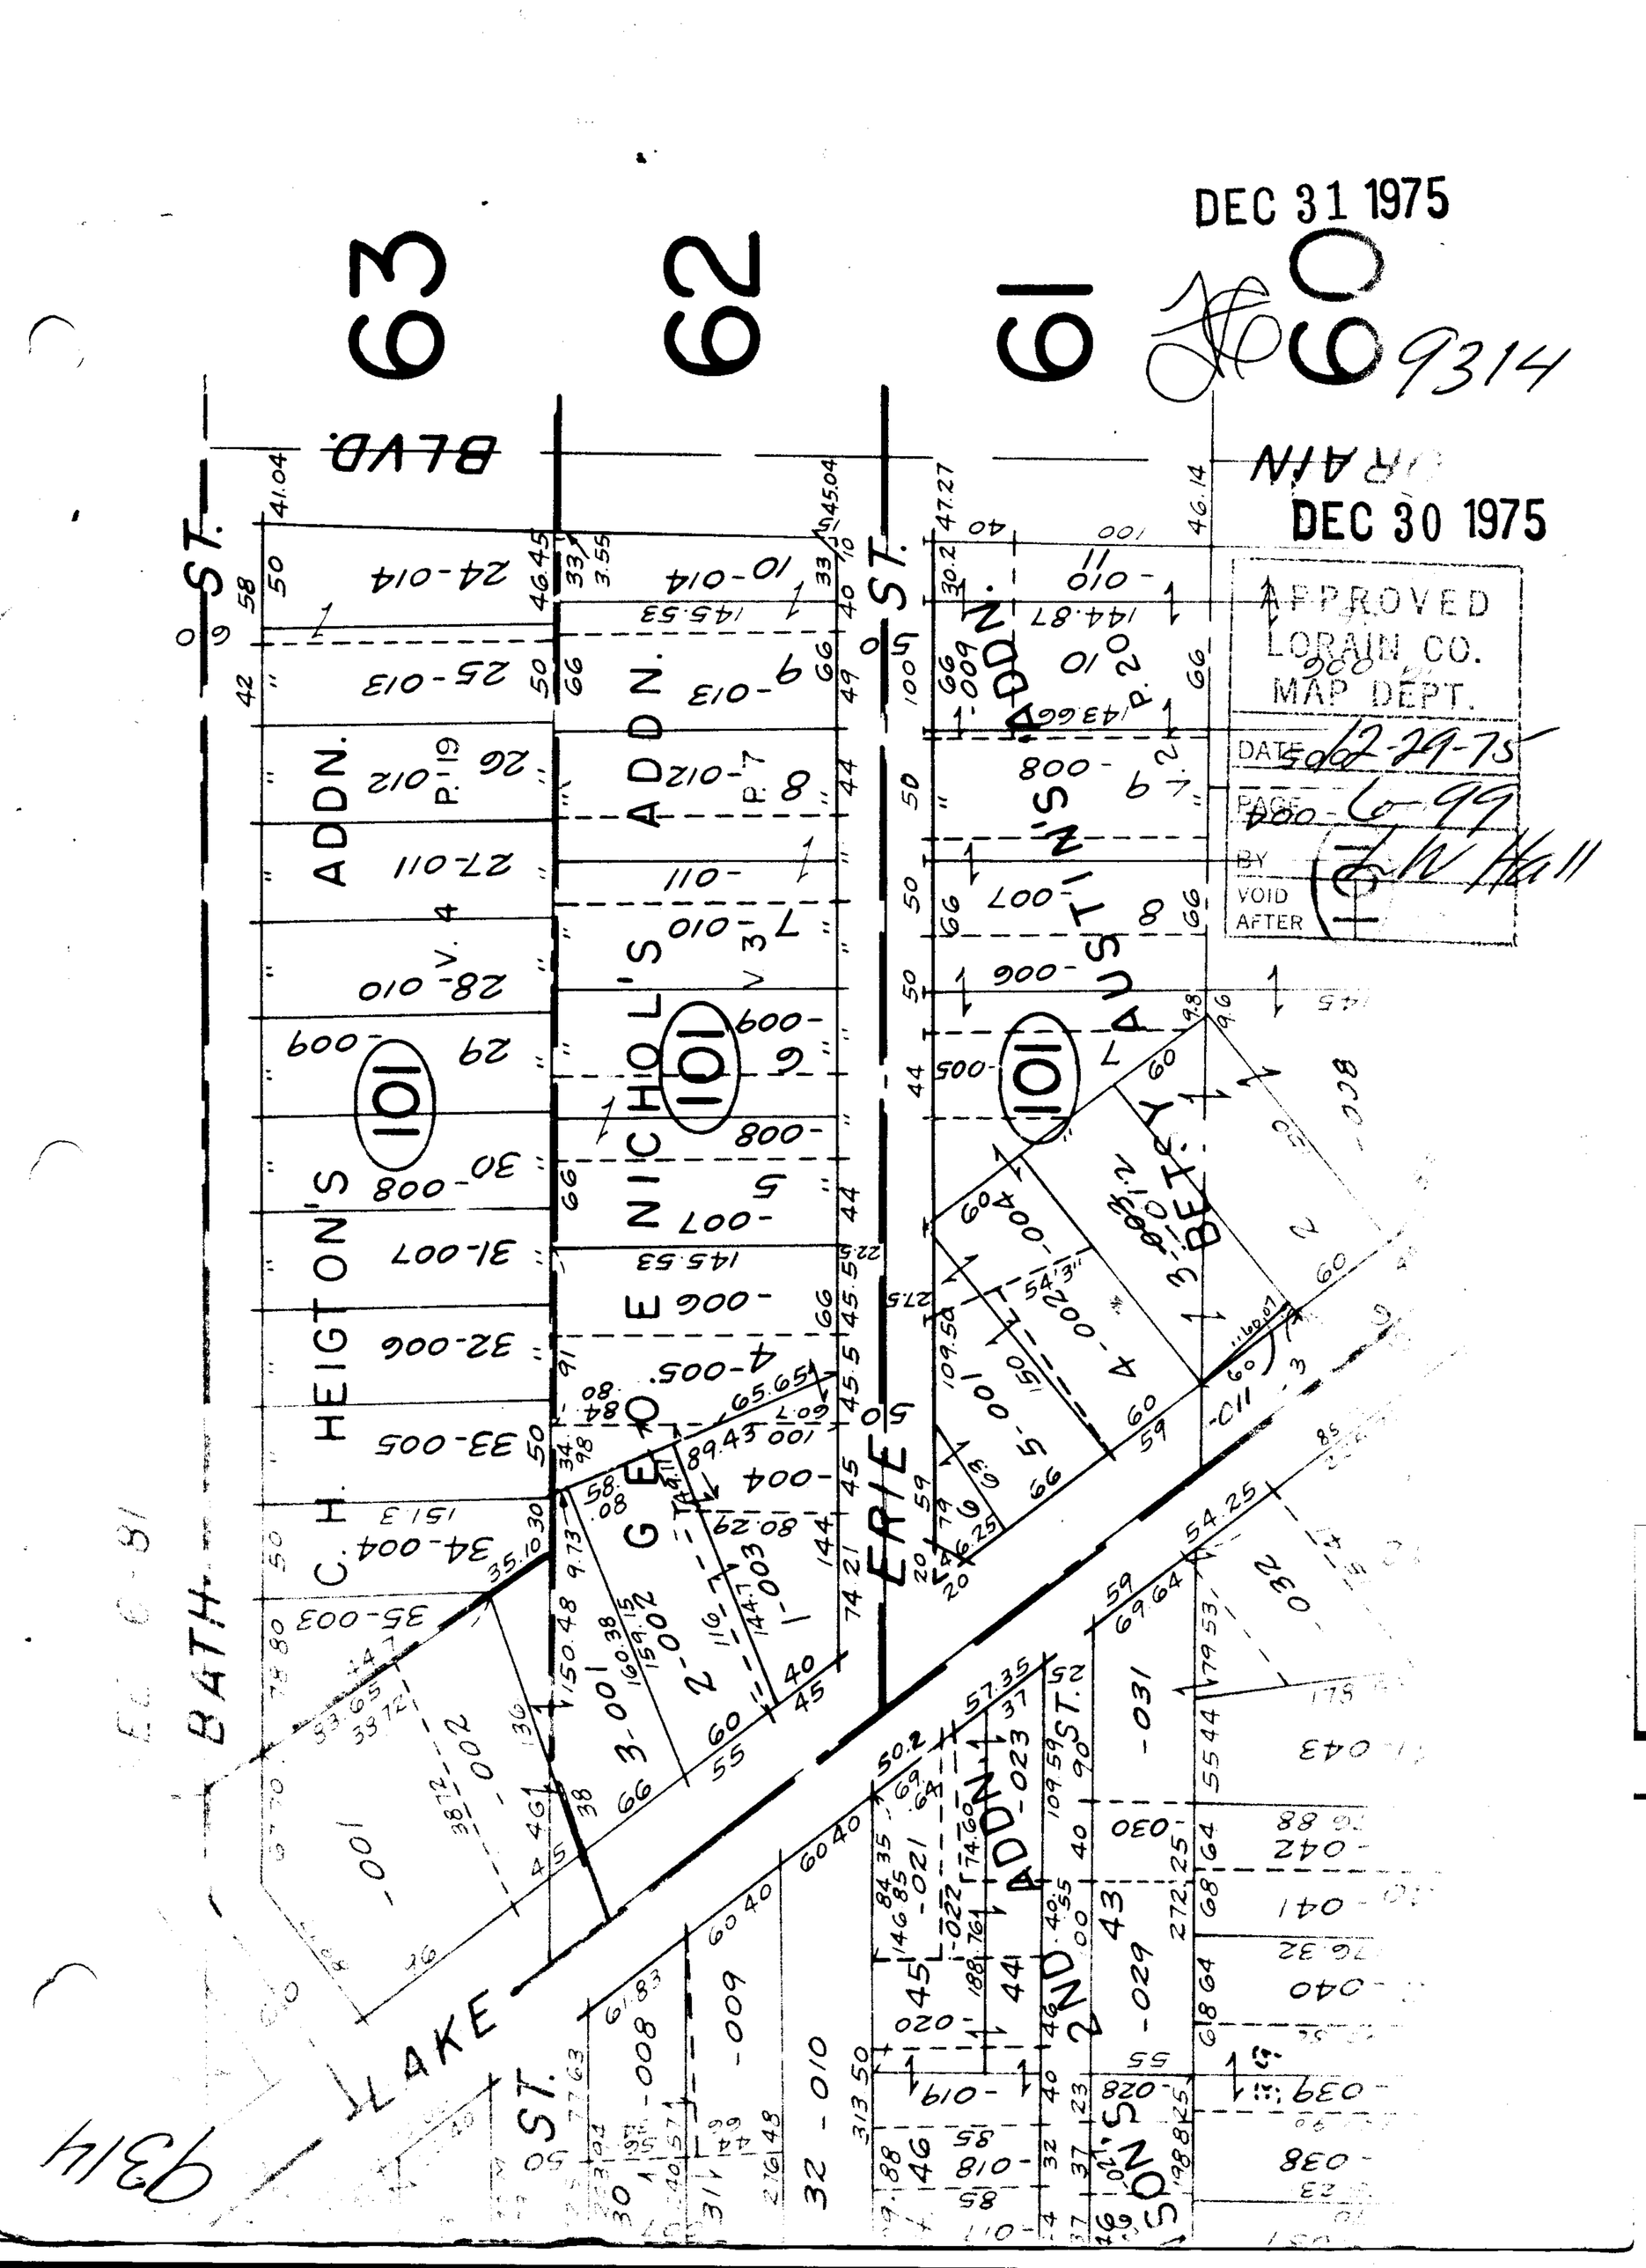
DEC 31 1975
9314
DEC 30 1975
APPROVED
LORAIN CO.
MAP DEPT.
DATE 12-29-75
PAGE 6-99
BY
VOID
AFTER
63
62
61
60
BLVD.
ST.
BATH
LAKE
ERIE
ST.
C. H. HEIGTON'S ADDN.
GEO. E. NICHOL'S ADDN.
AUSTIN'S ADDN.
2ND ADDN.
101
9314