


7.56A.

57

-137
5.30A.


9324

DEC 18 1975

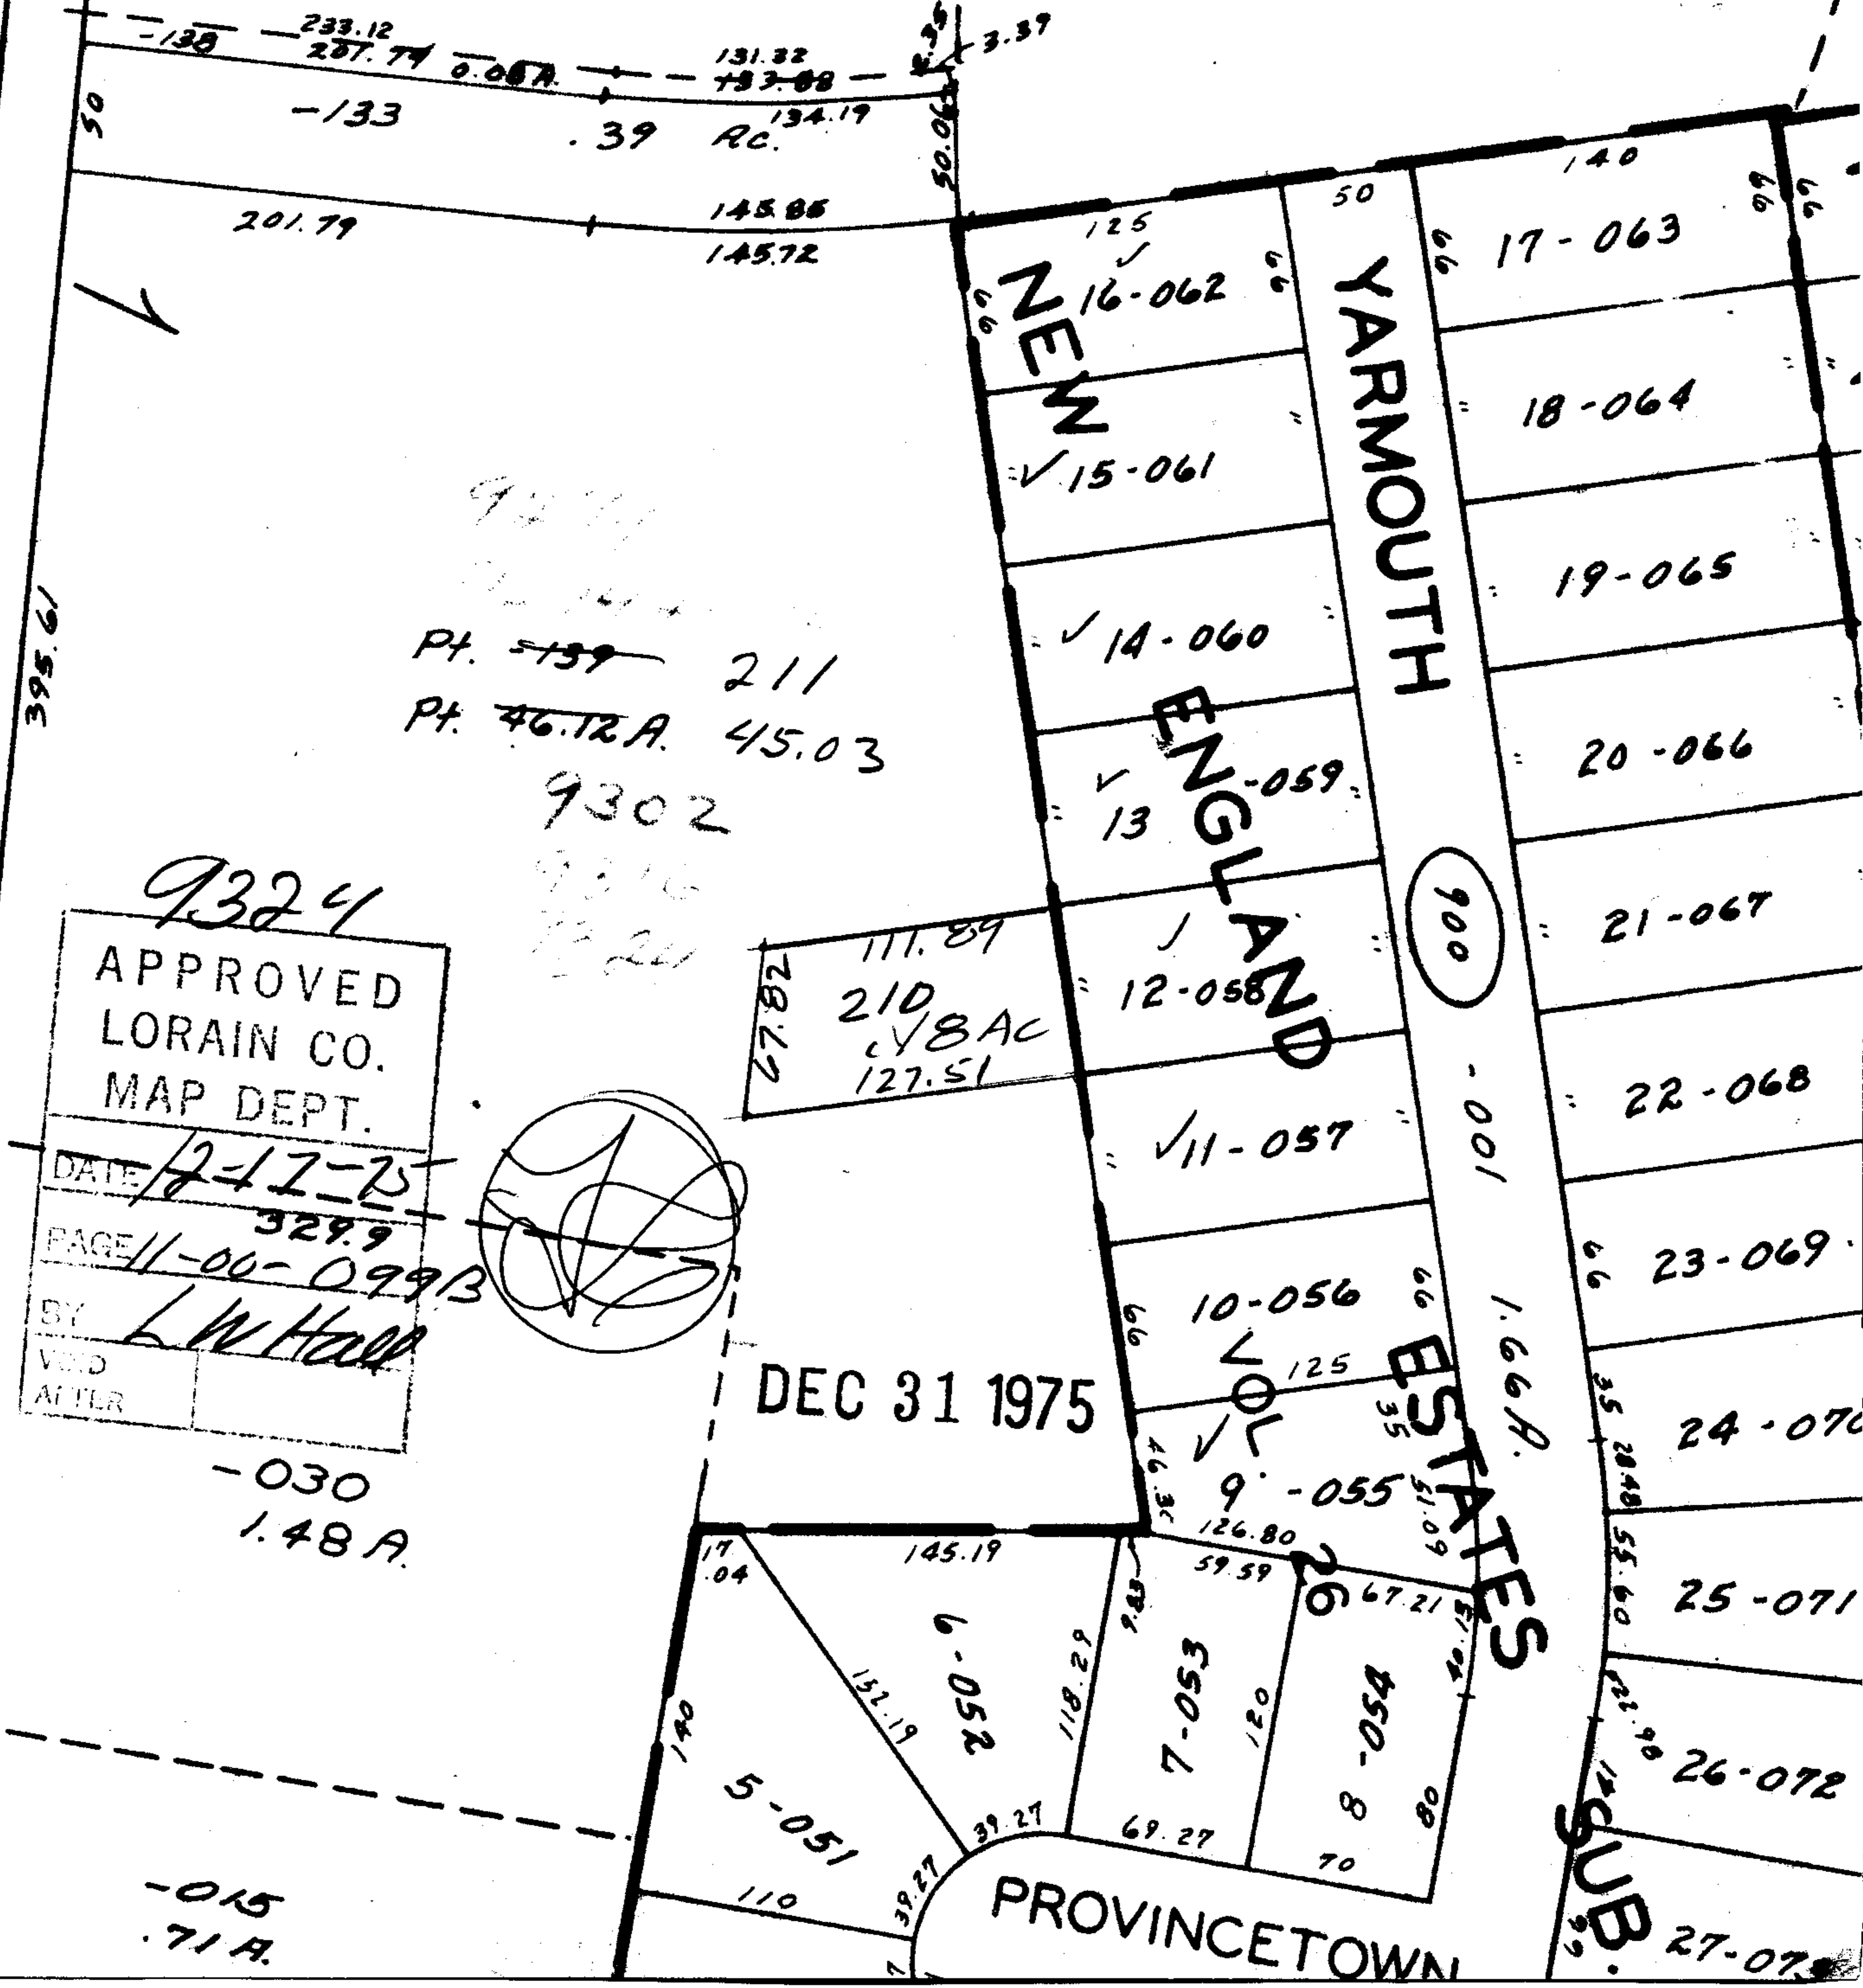

9324
 Pt. 5139 211
 Pt. 46.12A. 45.03
 9302

9324
 APPROVED
 LORAIN CO.
 MAP DEPT.
 DATE 12-17-75
 PAGE 11-00-099B
 BY L.W. Hall
 VED
 ATTLR

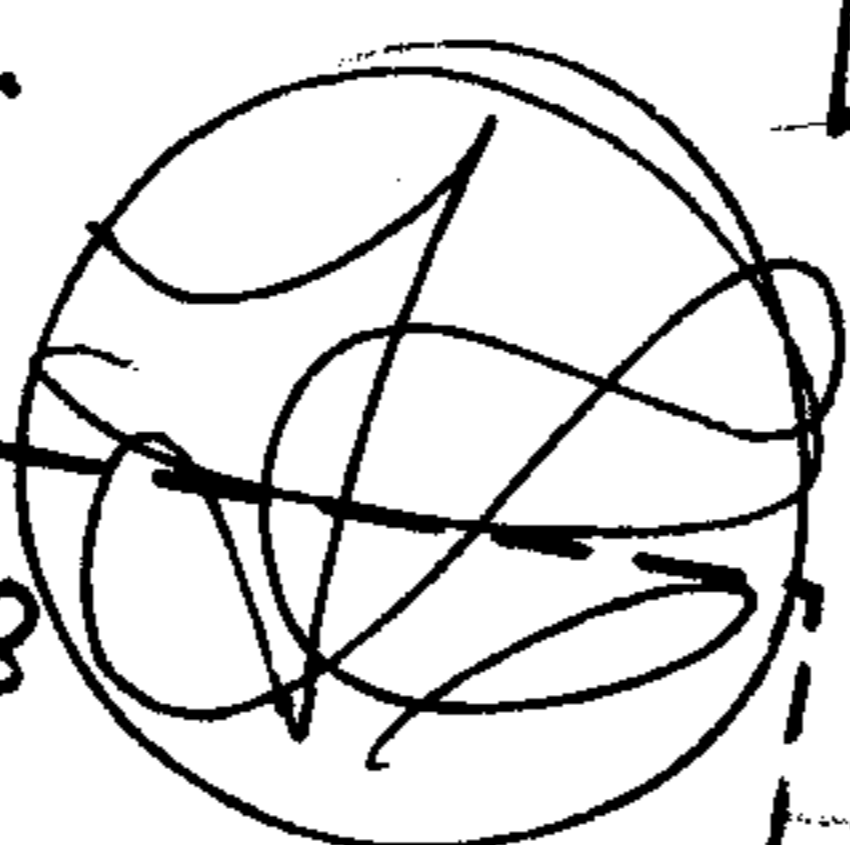

DEC 31 1975

-030
1.48A.

-015
.71A.

PROVINCETOWN

YARMOUTH

ENGLAND

ESTATES

SUB.

900

1001

1.66A.

140

17-063

18-064

19-065

20-066

21-067

22-068

23-069

24-070

25-071

26-072

27-073

18.672

279.81

3.39

50.065

125

16-062

15-061

14-060

13-059

12-058

11-057

10-056

9-055

8-054

7-053

6-052

5-051

170

192.06

134.19

131.32

133.08

134.19

145.86

145.72

201.79

233.12

287.74

0.057

133

39

RC.



























