


9330

RICHFIELD

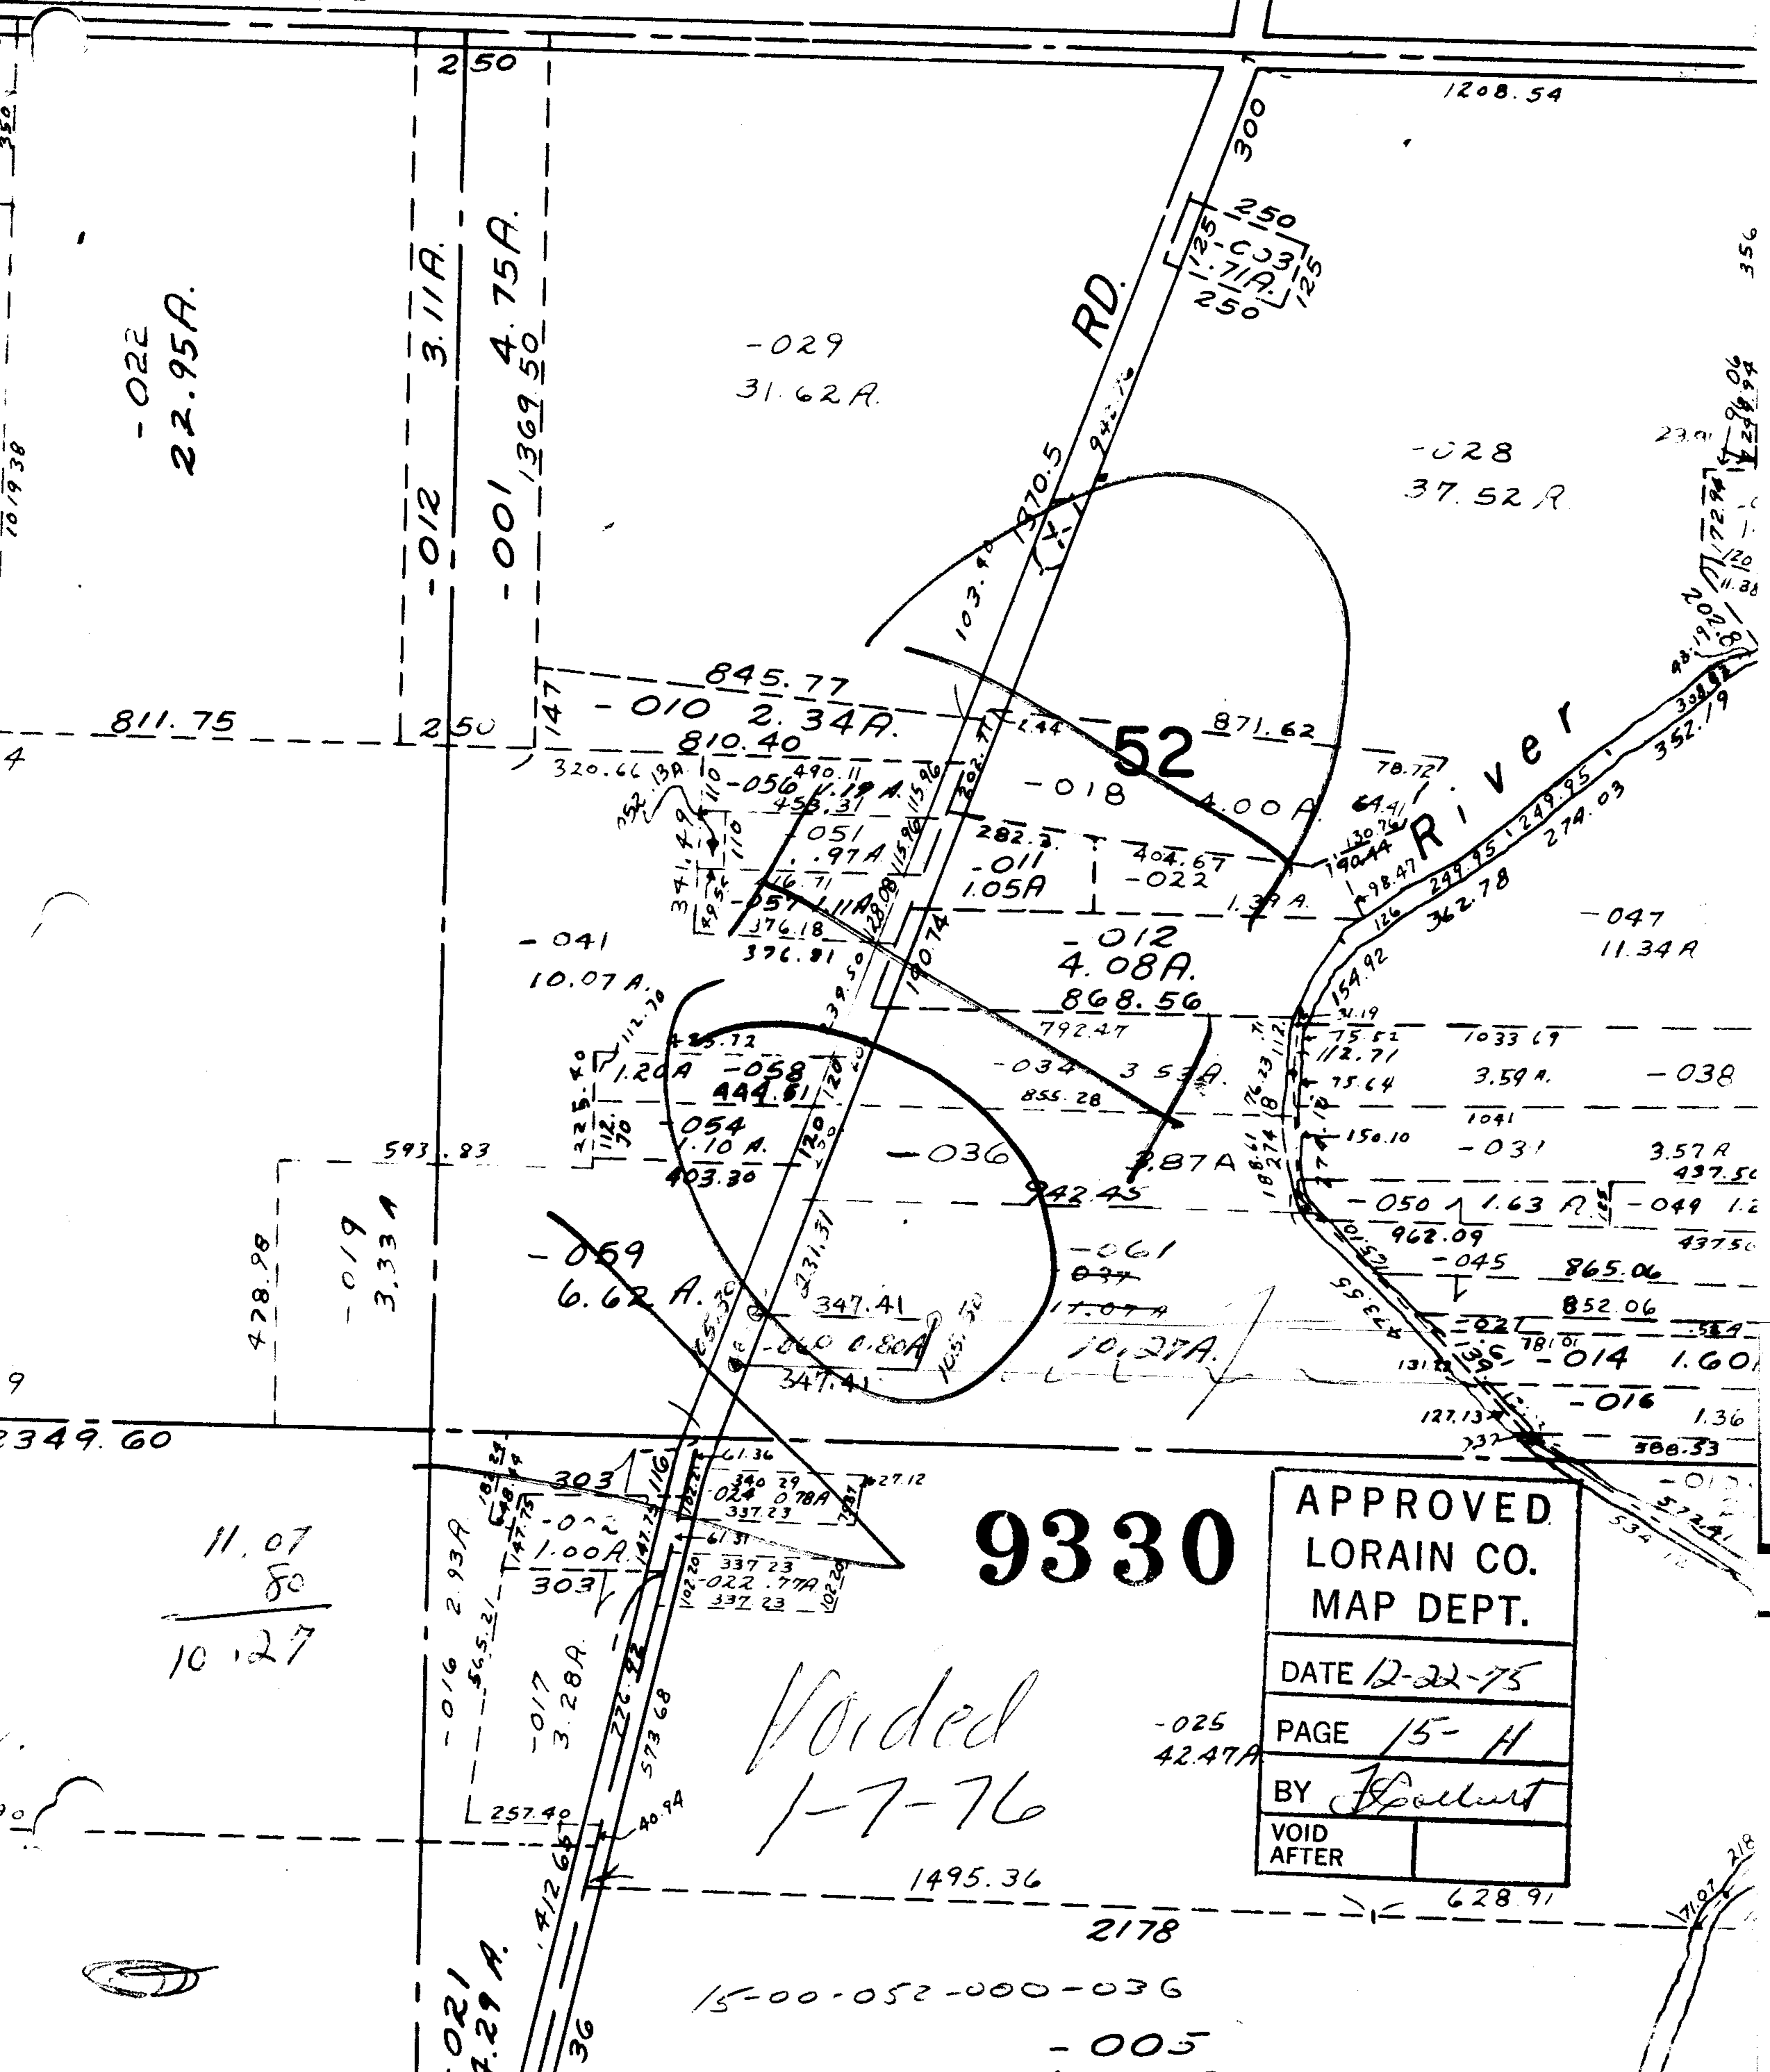

-022
22.95A.

-012 3.11A.
-001 1369.50
4.75A.

-029
31.62A.

-028
37.52R.

811.75

250

845.77
-010 2.34A.
810.40

52

871.62

River

-041
10.07A.

-012
4.08A.
868.56

-047
11.34A.

-058
444.61

-034
3.53A.
855.28

-038

-019
3.33A

-059
6.62A.

-061

-031
3.57A.

-049
1.2

43750

865.06

852.06

-014
1.60

-016
1.36

580.33

-010

572.41

534.10

171.02

218

9330

APPROVED
LORAIN CO.
MAP DEPT.

DATE 12-22-75

PAGE 15-H

BY *Spallert*

VOID AFTER

Voided
1-7-76

-025
42.47A

1495.36

2178

15-00-052-000-036

-005

628.91

11.07
80
10.27

-021
4.29A.

36

-016 2.93A
-017 3.28A.

303

303

