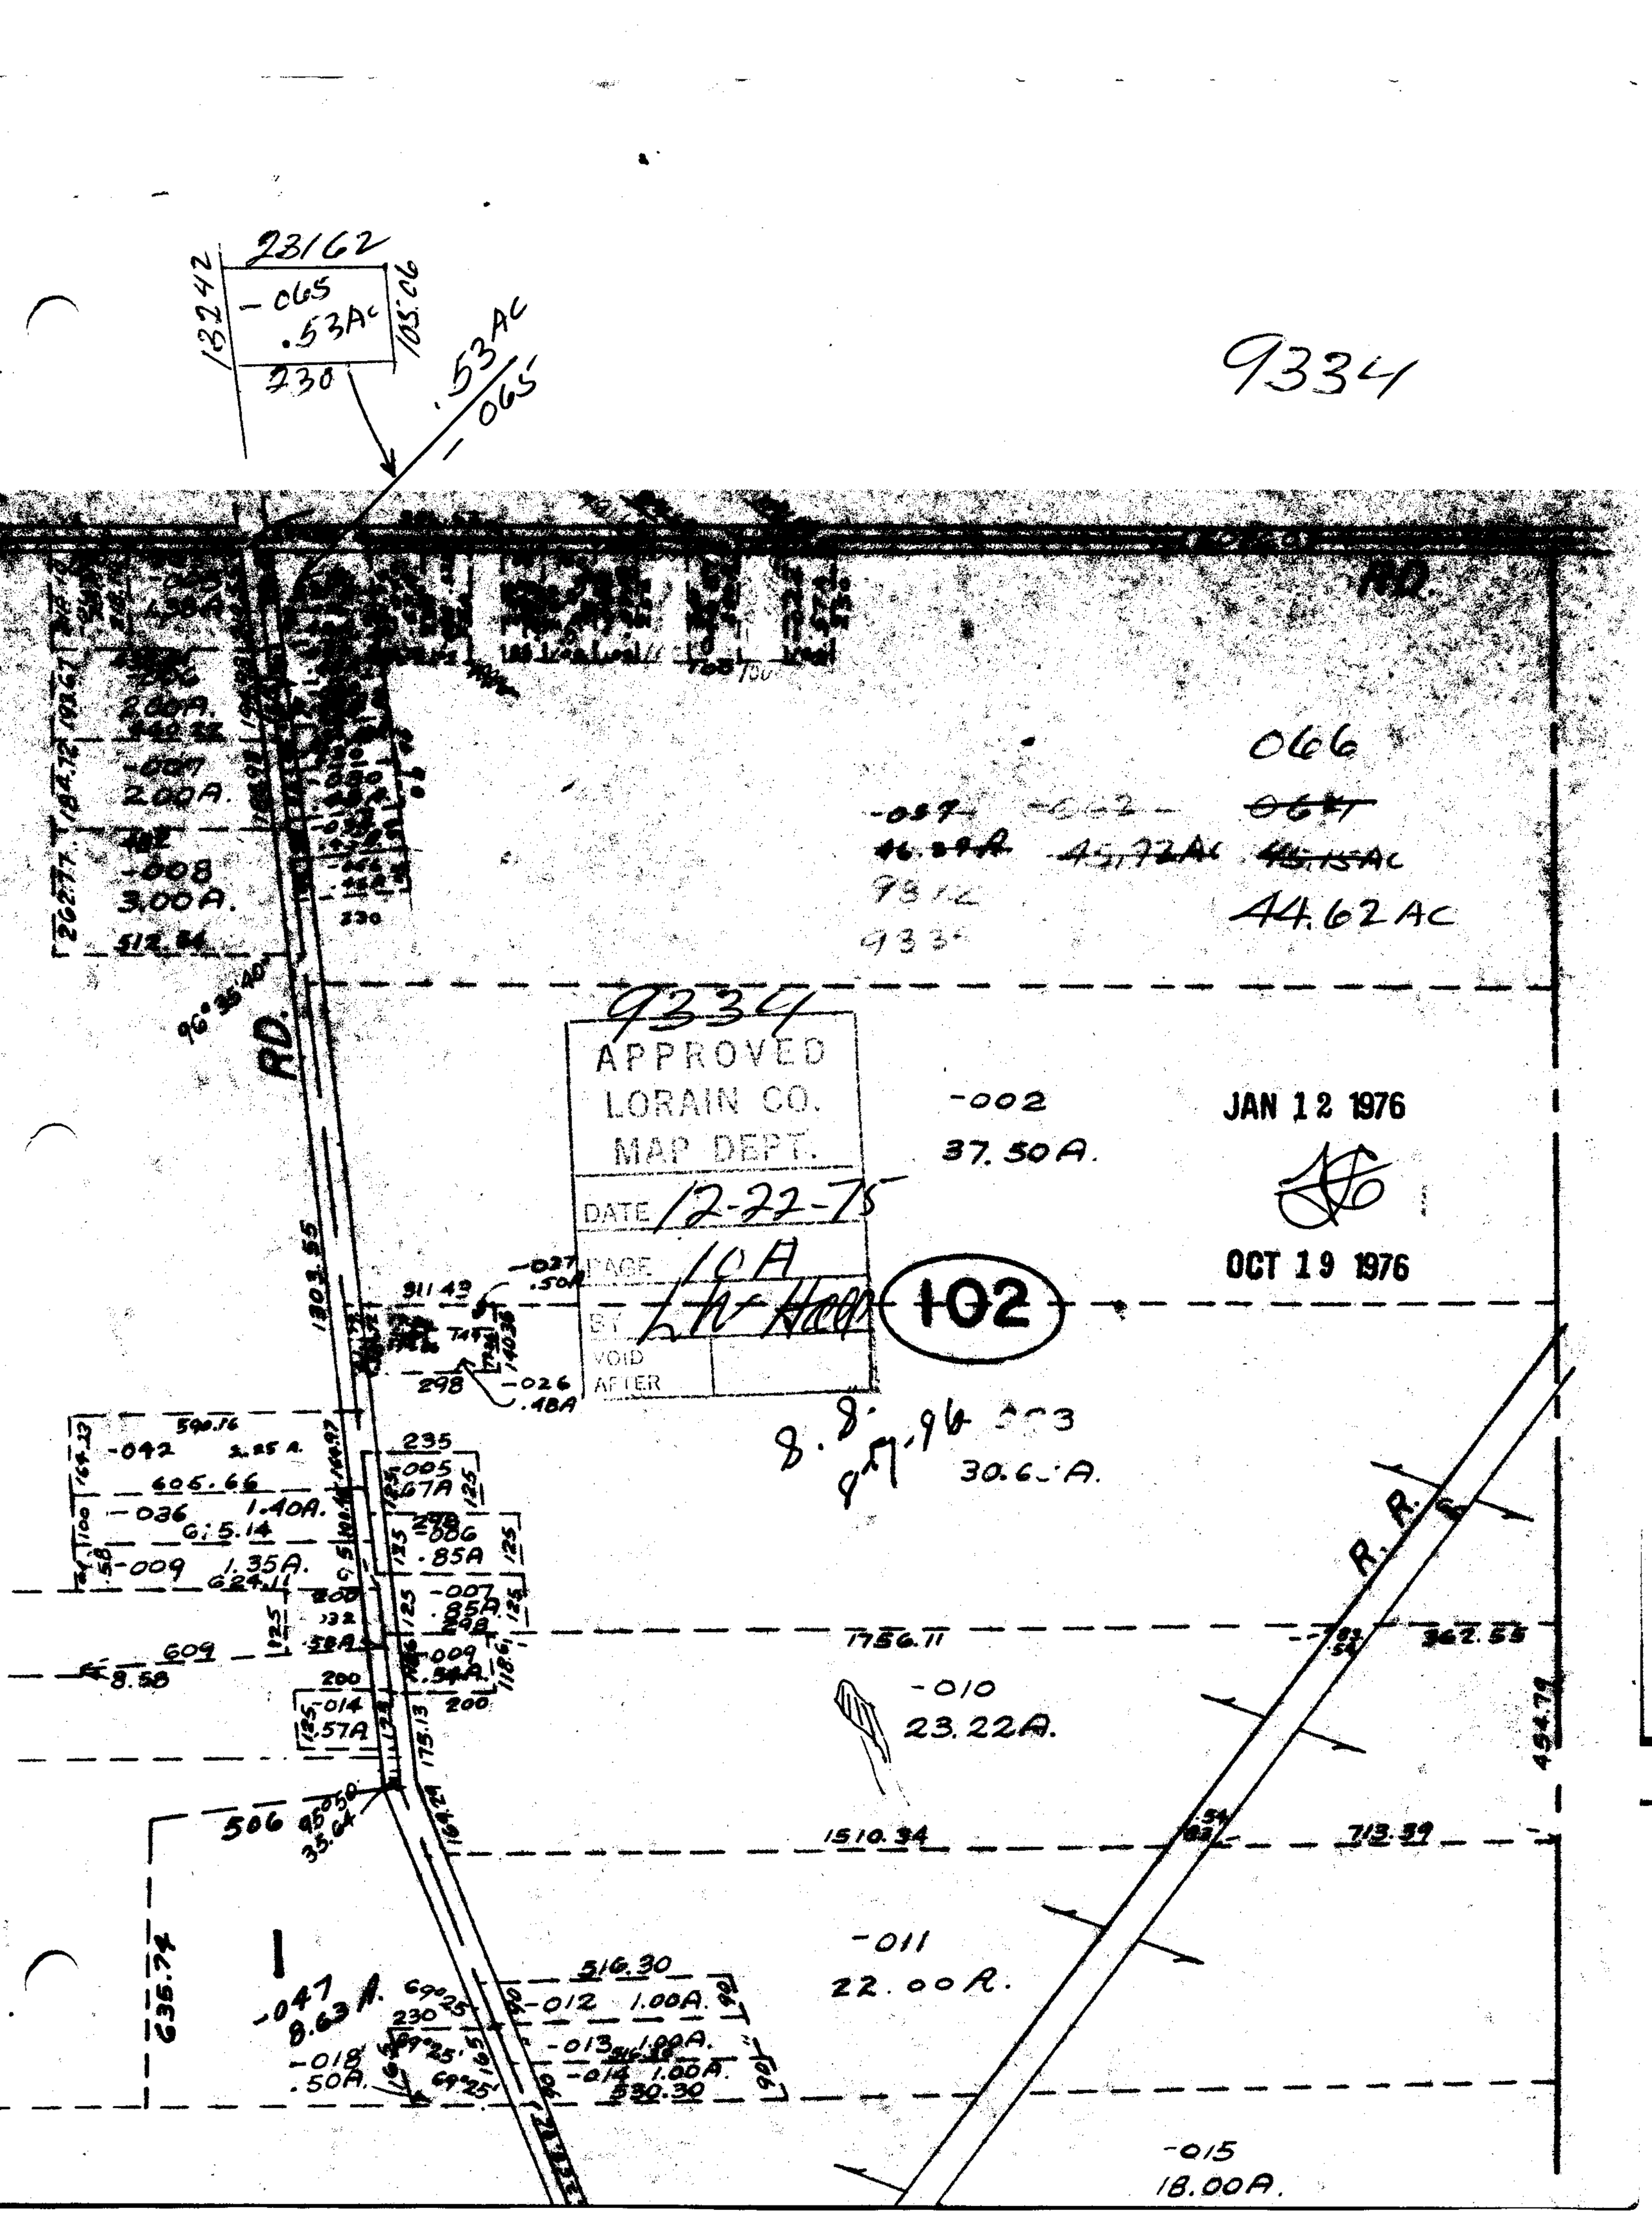
23162
-065
.53AC
132.42
105.06
230
.53AC
-065
9334
066
-067
-062
~~066~~
~~46.29A~~
~~45.72AC~~
~~45.15AC~~
9312
9334
44.62AC
9334
APPROVED
LORAIN CO.
MAP DEPT.
DATE 12-22-75
PAGE 10A
BY
VOID
AFTER
-002
37.50A.
JAN 12 1976
OCT 19 1976
102
8.8.96
30.6 A.
R.R.
-010
23.22A.
-011
22.00A.
-015
18.00A.
-047
8.63A.
-018
.50A.
-012
1.00A.
-013
1.00A.
-014
1.00A.
-042
2.25A.
-036
1.40A.
-009
1.35A.
-014
.57A
-026
.48A
-027
.50A
-005
.67A
-006
.85A
-007
.85A
-009
.54A
-050
35.64
1756.11
1510.34
713.39
362.53
494.79
635.74
1303.55
2677.7
1847.72
1917.67