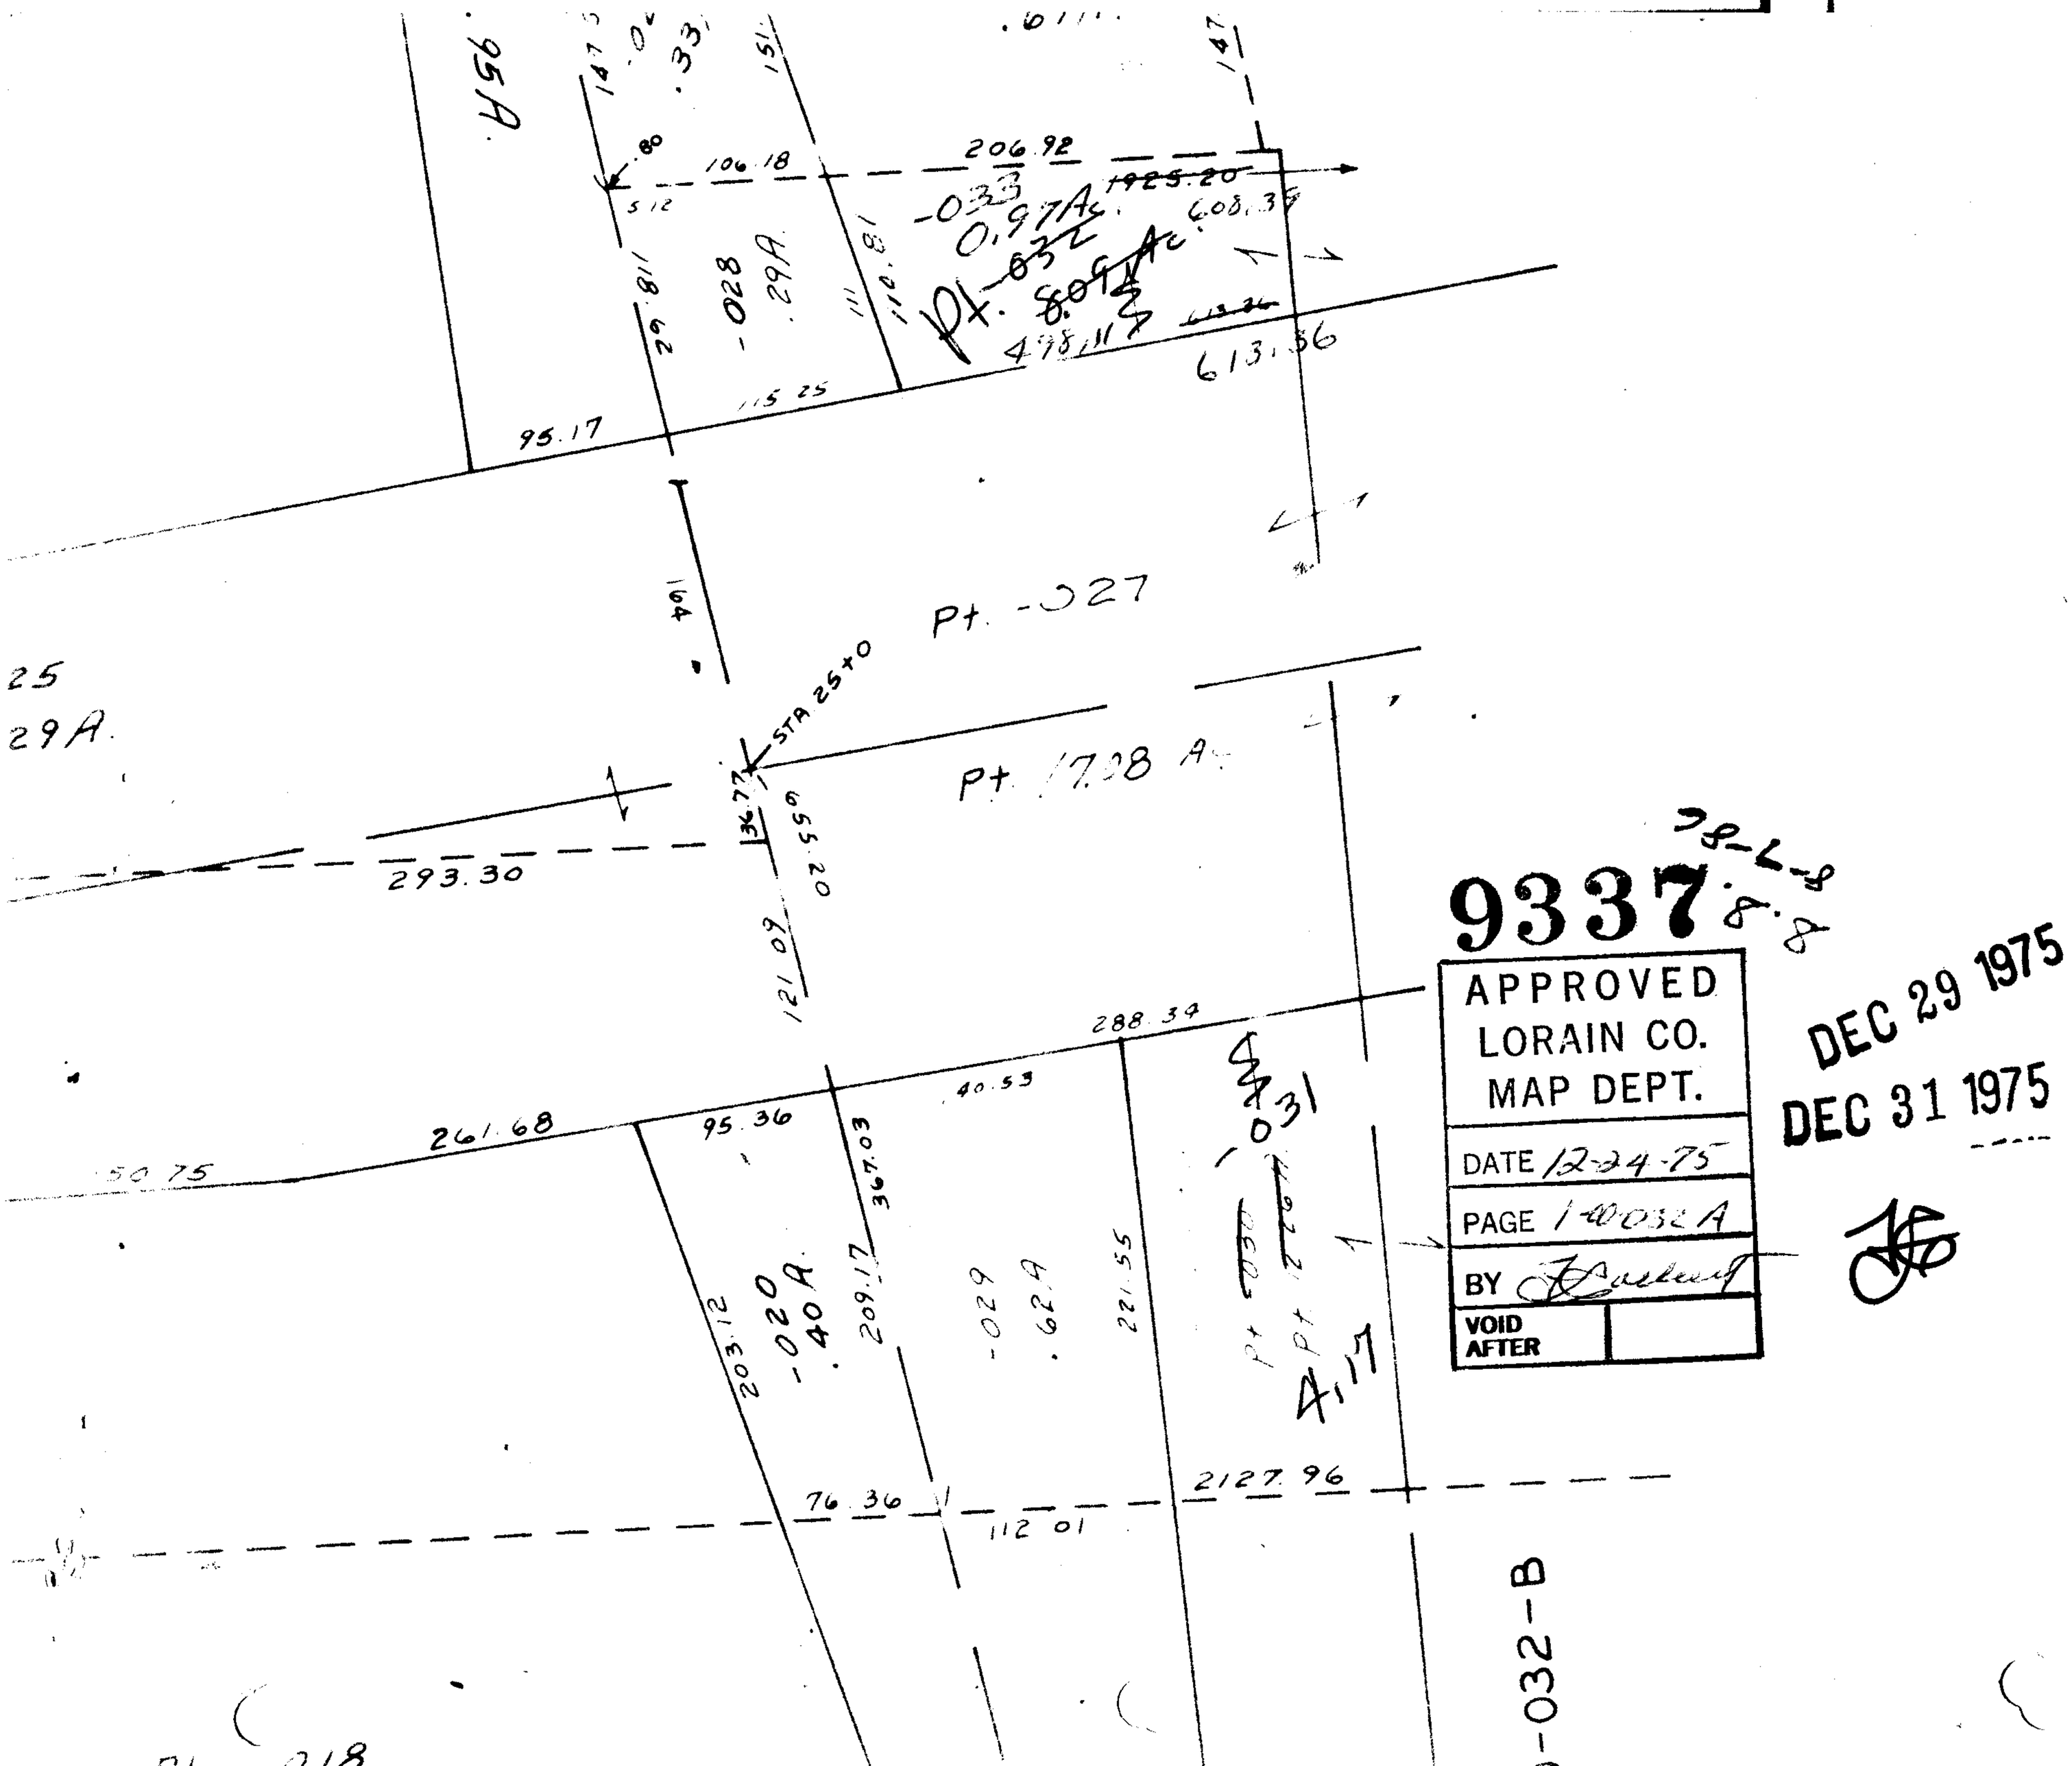

9337

APPROVED
LORAIN CO.
MAP DEPT.

DATE 12-24-75

PAGE 1-00-032 A

BY [signature]

VOID AFTER

DEC 29 1975

DEC 31 1975