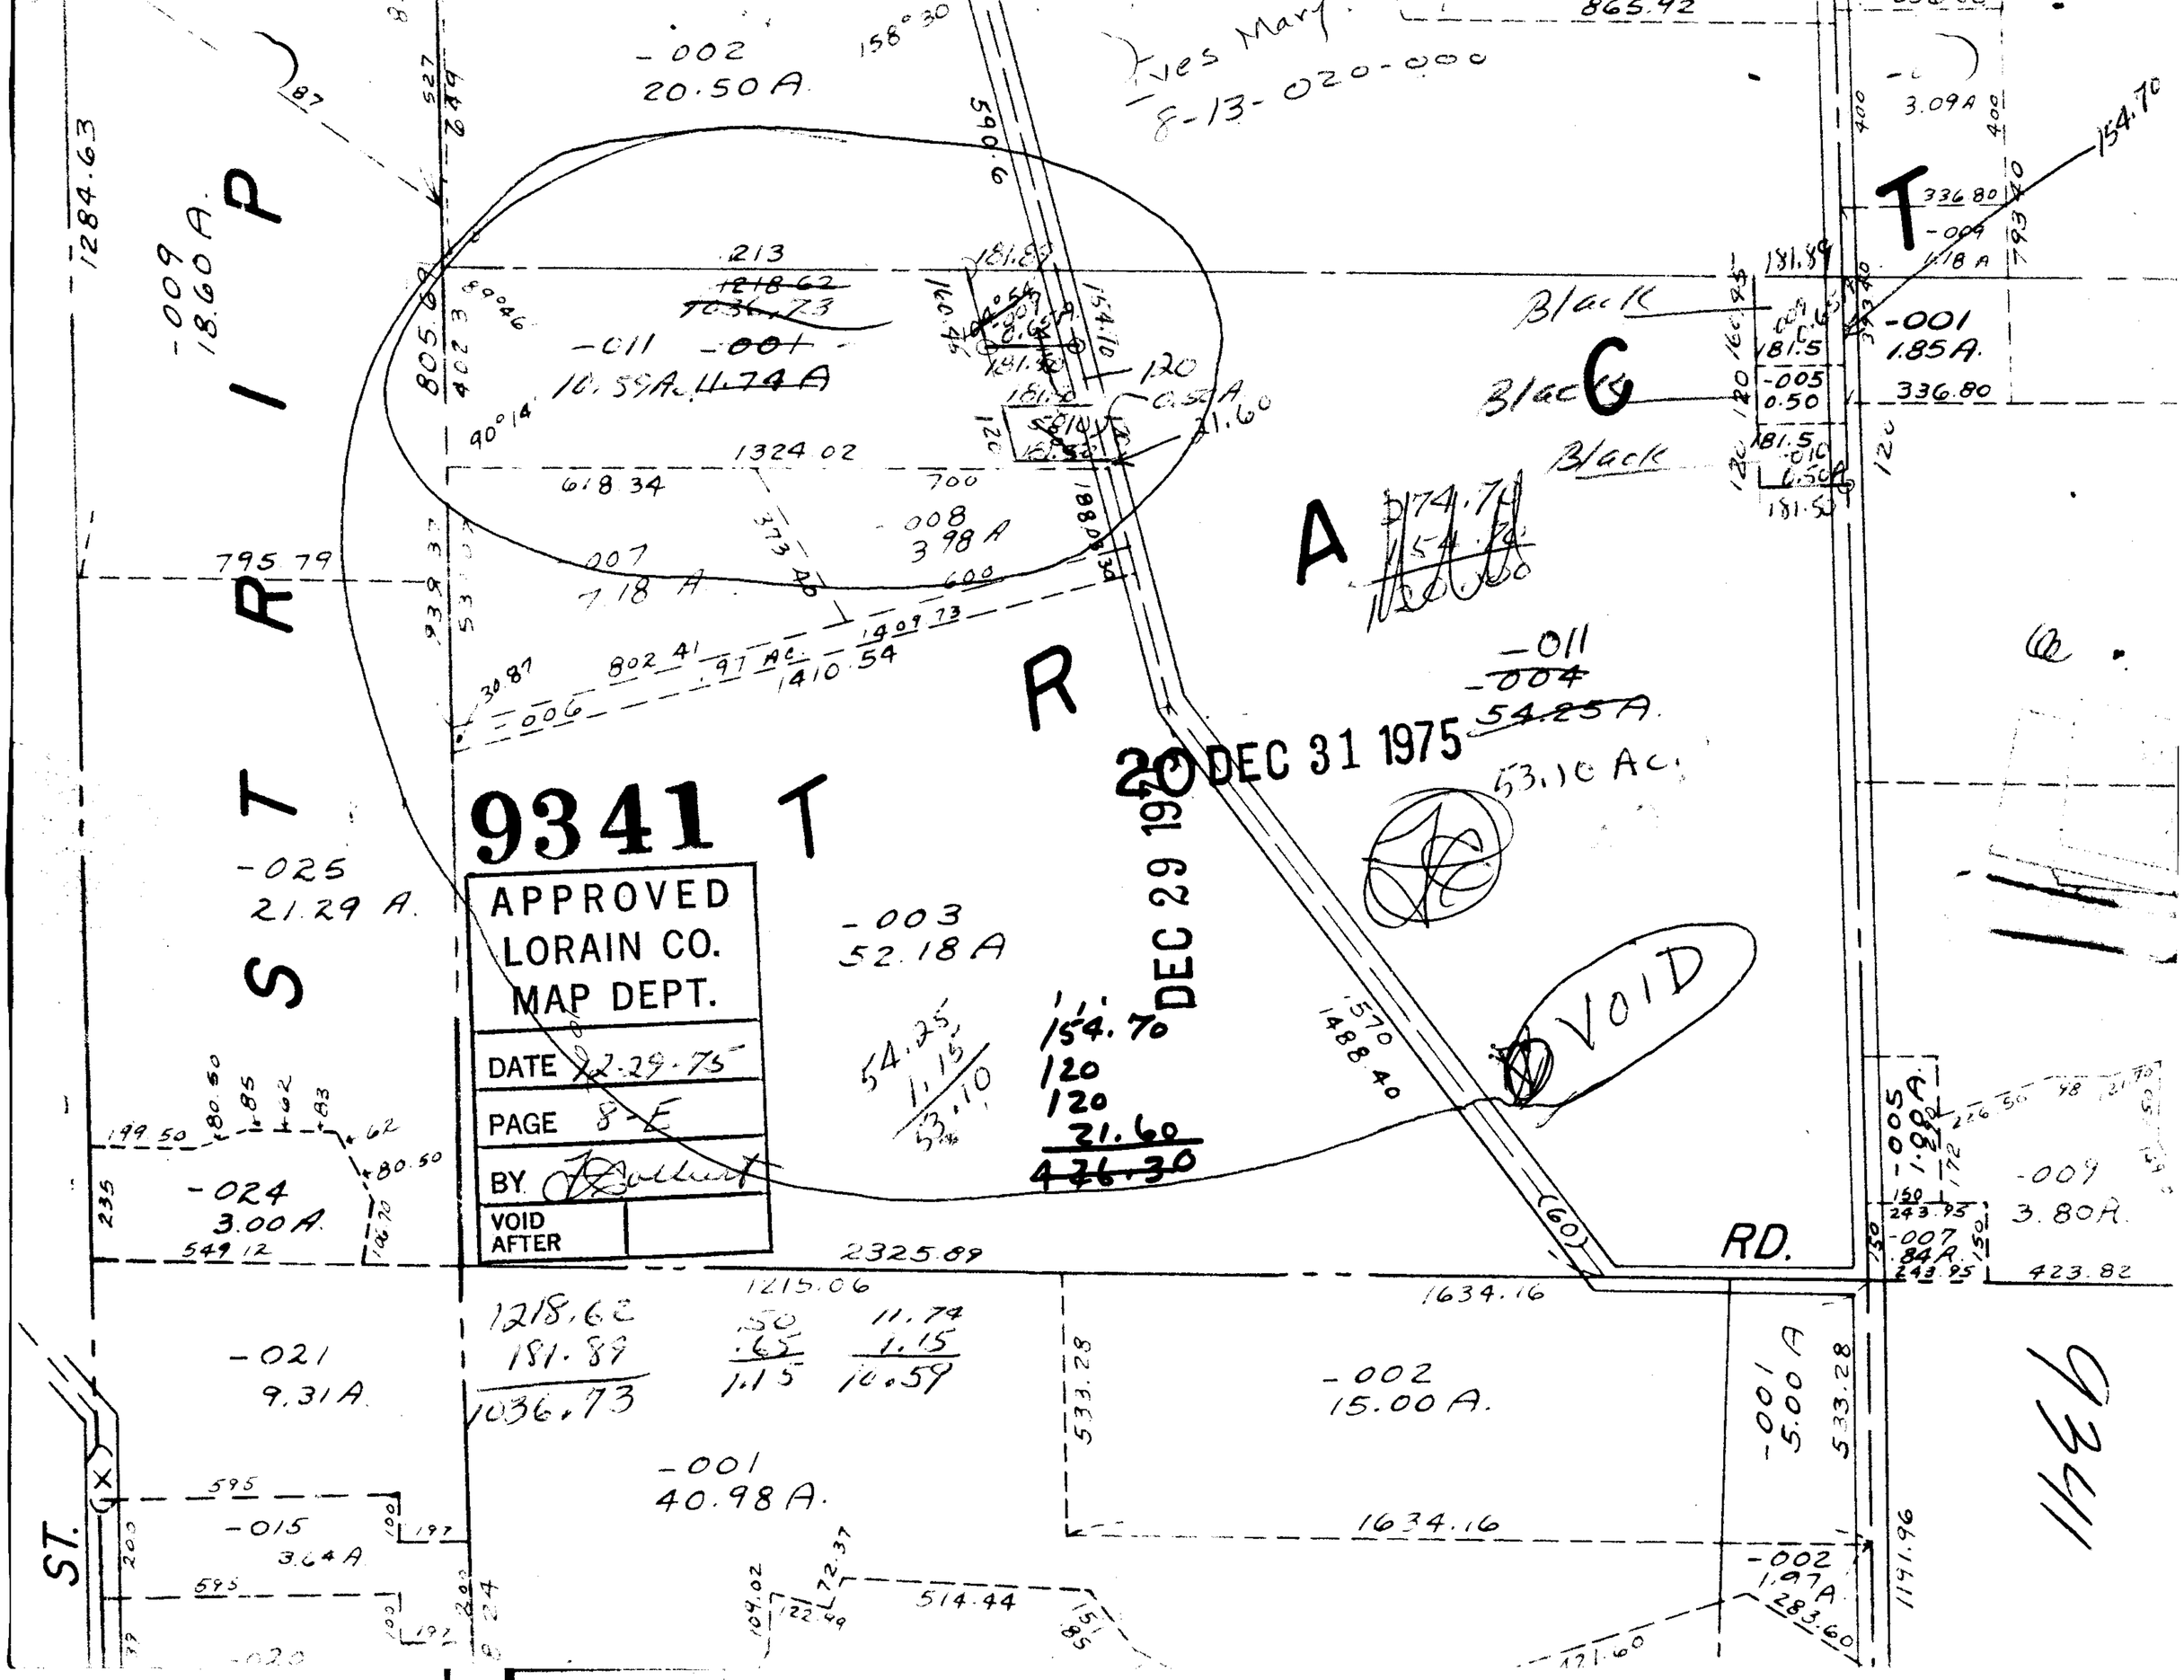

9341
APPROVED
LORAIN CO.
MAP DEPT.
DATE 12-29-75
PAGE 8-E
BY
VOID AFTER
DEC 29 1975
DEC 31 1975
VOID
Black
Black
Black
-002
20.50 A.
-011
10.59 A.
-001
11.74 A
-008
3.98 A
-007
7.18 A
-011
-004
54.25 A.
53.10 Ac.
-003
52.18 A
-025
21.29 A.
-024
3.00 A.
-021
9.31 A.
-015
3.64 A
-001
40.98 A.
-002
15.00 A.
-001
5.00 A
-002
1.97 A
-009
3.80 A.
-001
1.85 A.
-009
18.60 A.
-005
1.00 A.
-007
.84 A.
1218.62
181.89
1036.73
11.74
1.15
10.59
54.25
1.15
53.10
154.70
120
120
21.60
476.30
2325.89
1634.16
1634.16
1215.06
1324.02
1410.54
1409.73
1284.63
795.79
865.92
1488.40
1570
(60)
RD.
ST.