


9347

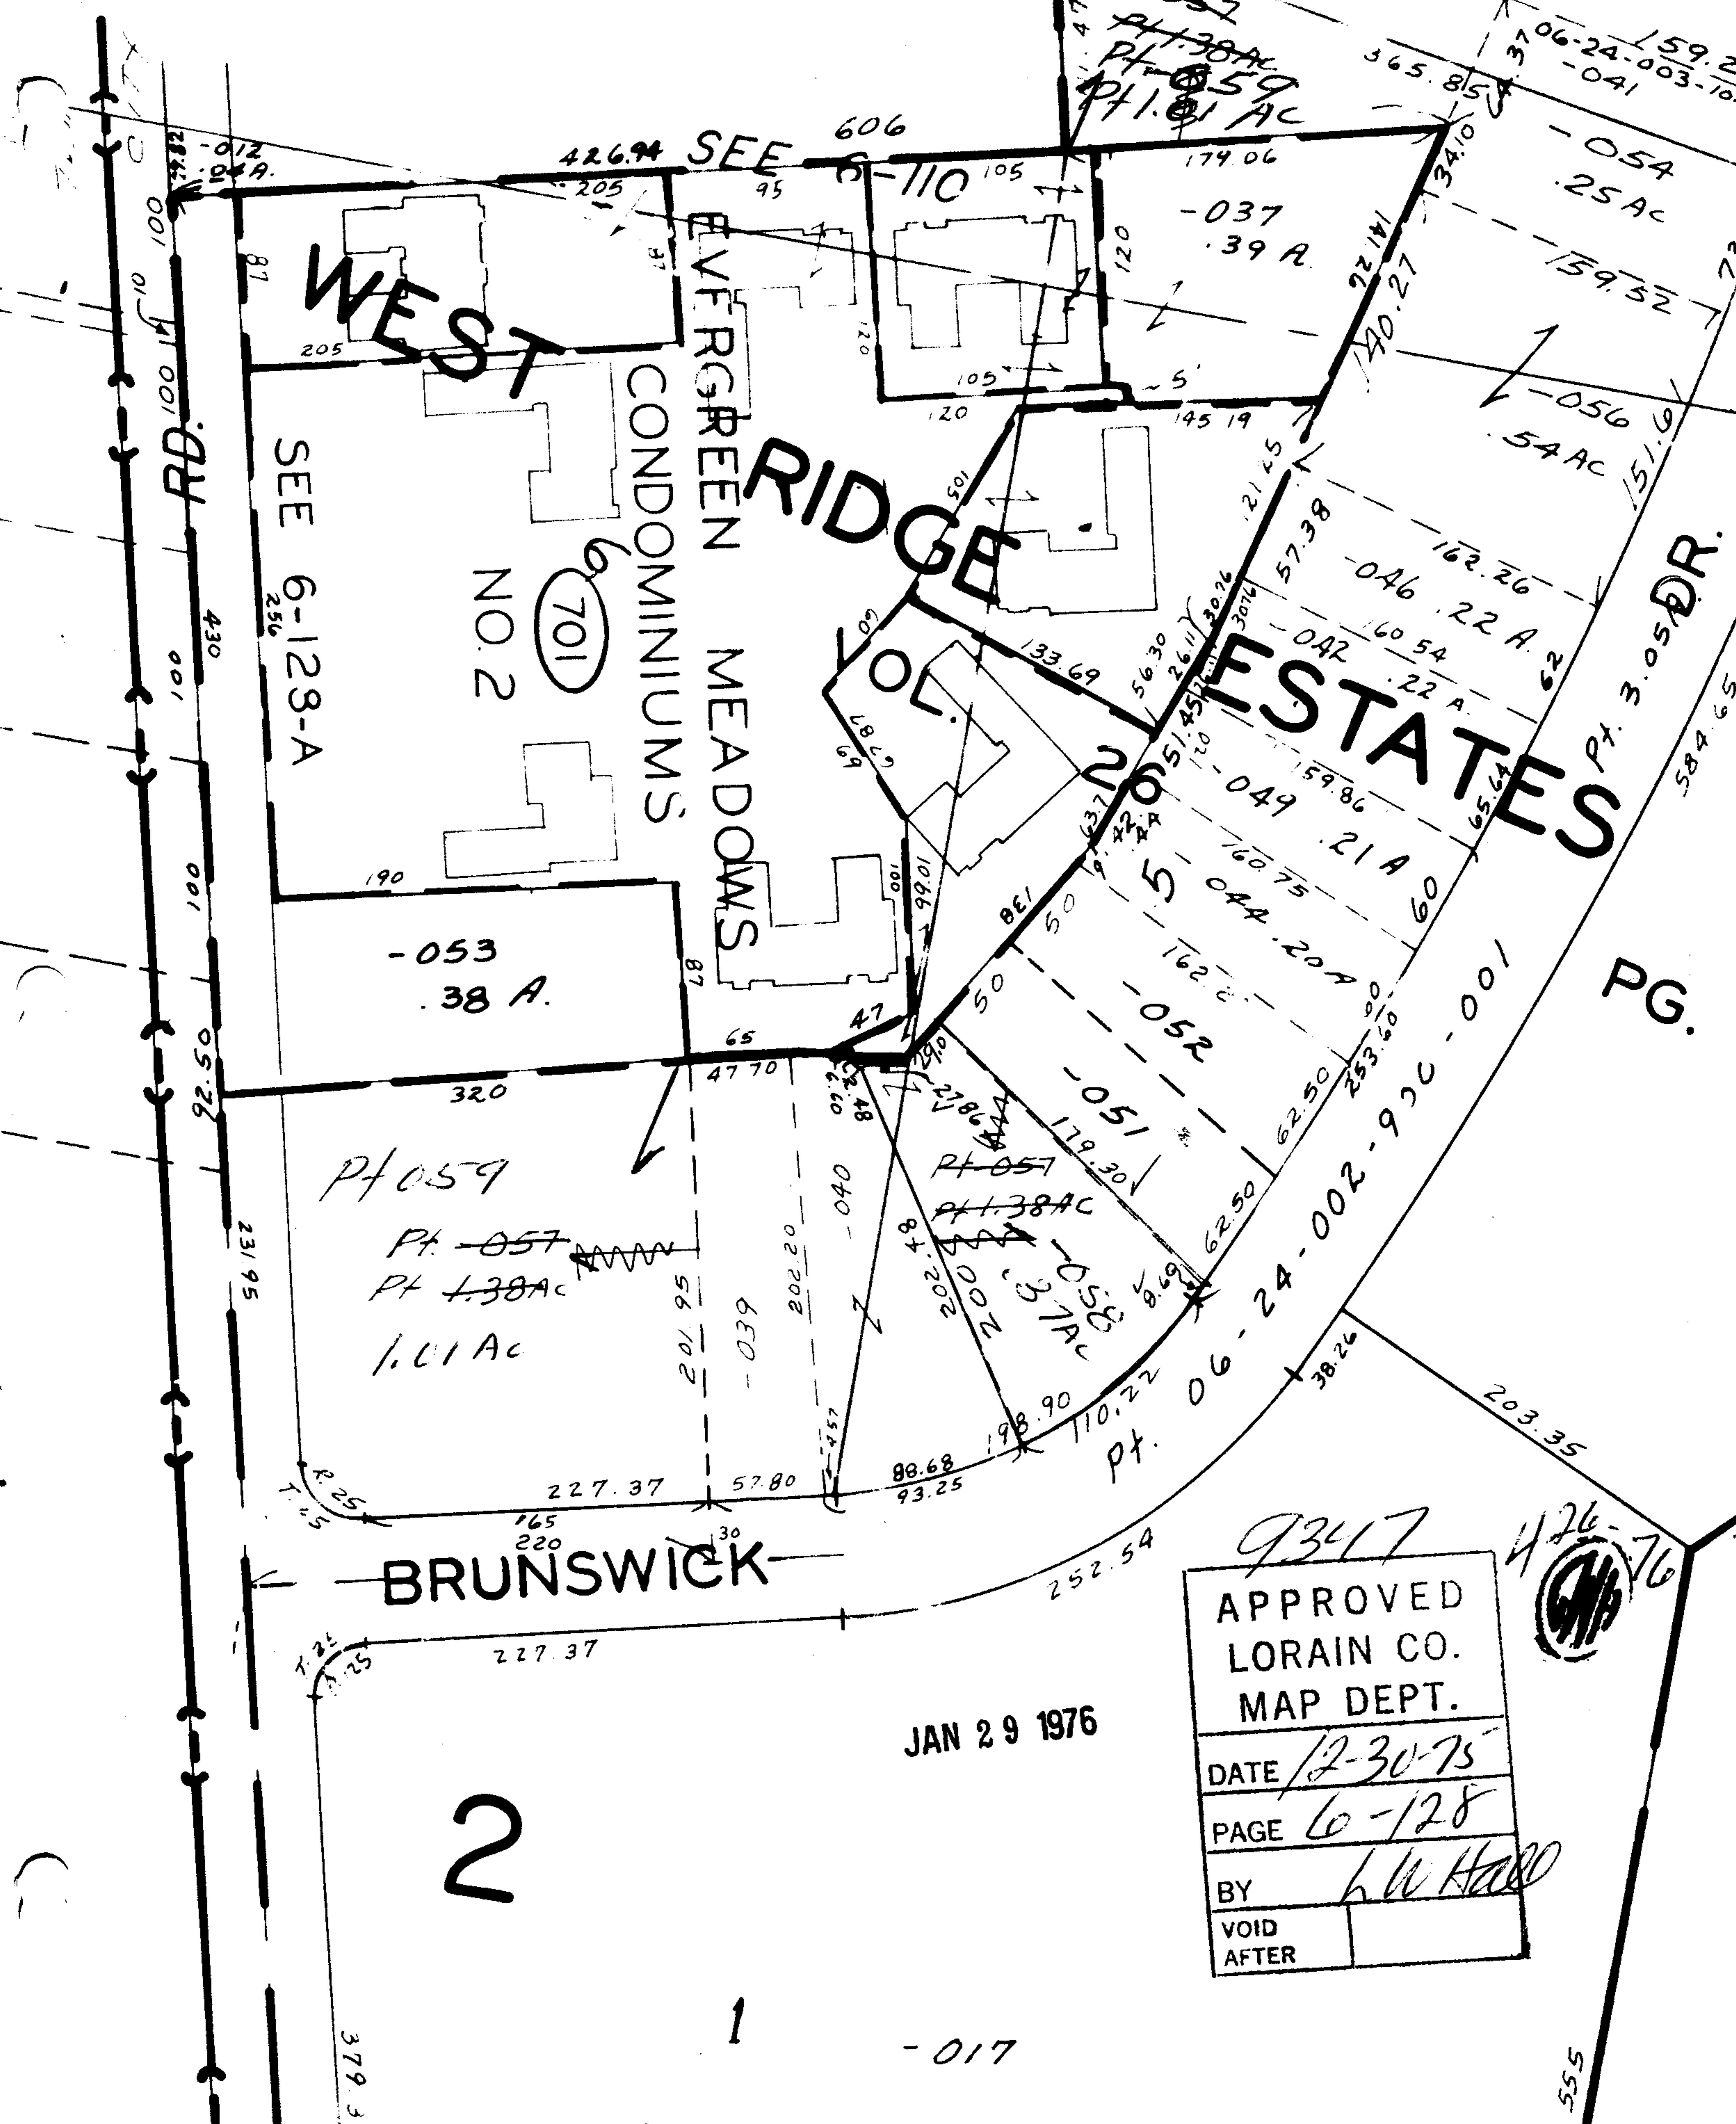

WEST

EVERGREEN RIDGE  
CONDOMINIUMS  
NO. 2

SEE 6-128-A

SEE 6-110

-053  
38 A.

PT 059

PT. 057  
PT. 1.38 AC

1.01 AC

BRUNSWICK

2

1

JAN 29 1976

- 017

9347

APPROVED  
LORAIN CO.  
MAP DEPT.

DATE 12-30-75

PAGE 6-128

BY L.W. Hall

VOID AFTER



555