


9357

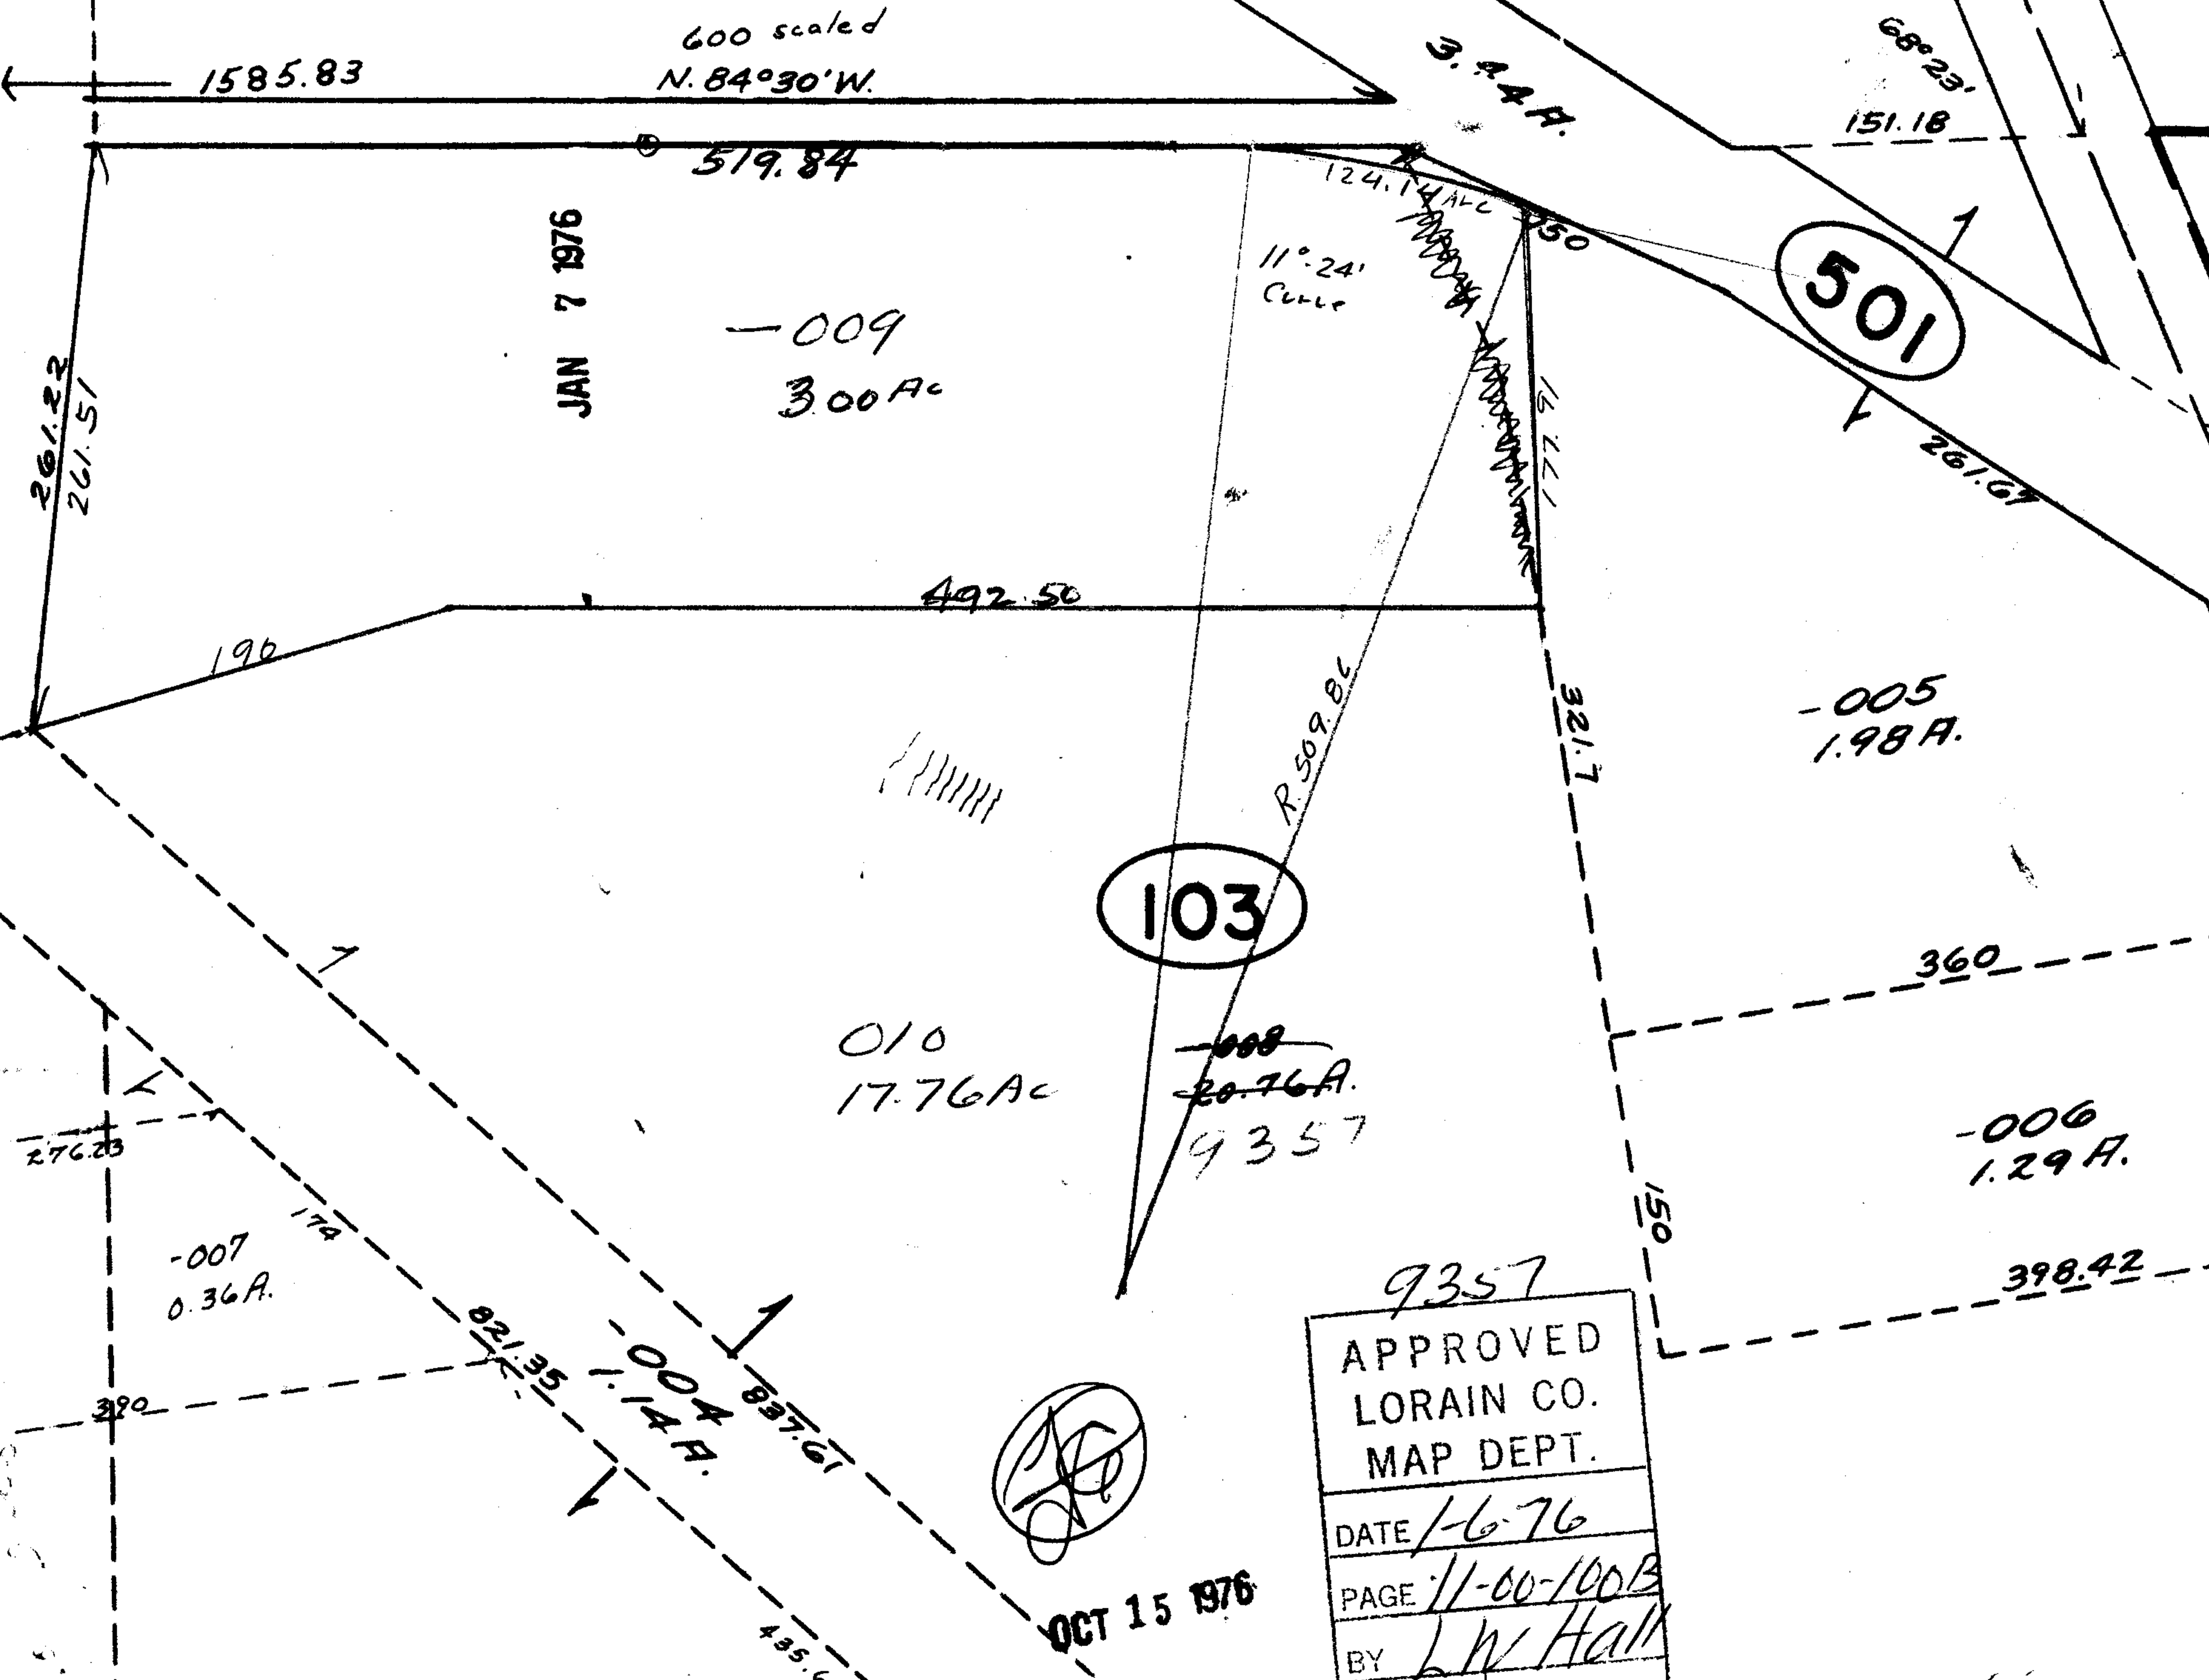

(Handwritten signature)

OCT 15 1976

9357

APPROVED	
LORAIN CO.	
MAP DEPT.	
DATE	1-6-76
PAGE	11-00-100B
BY	LW Hall
VOID	
AFTER	