


9370

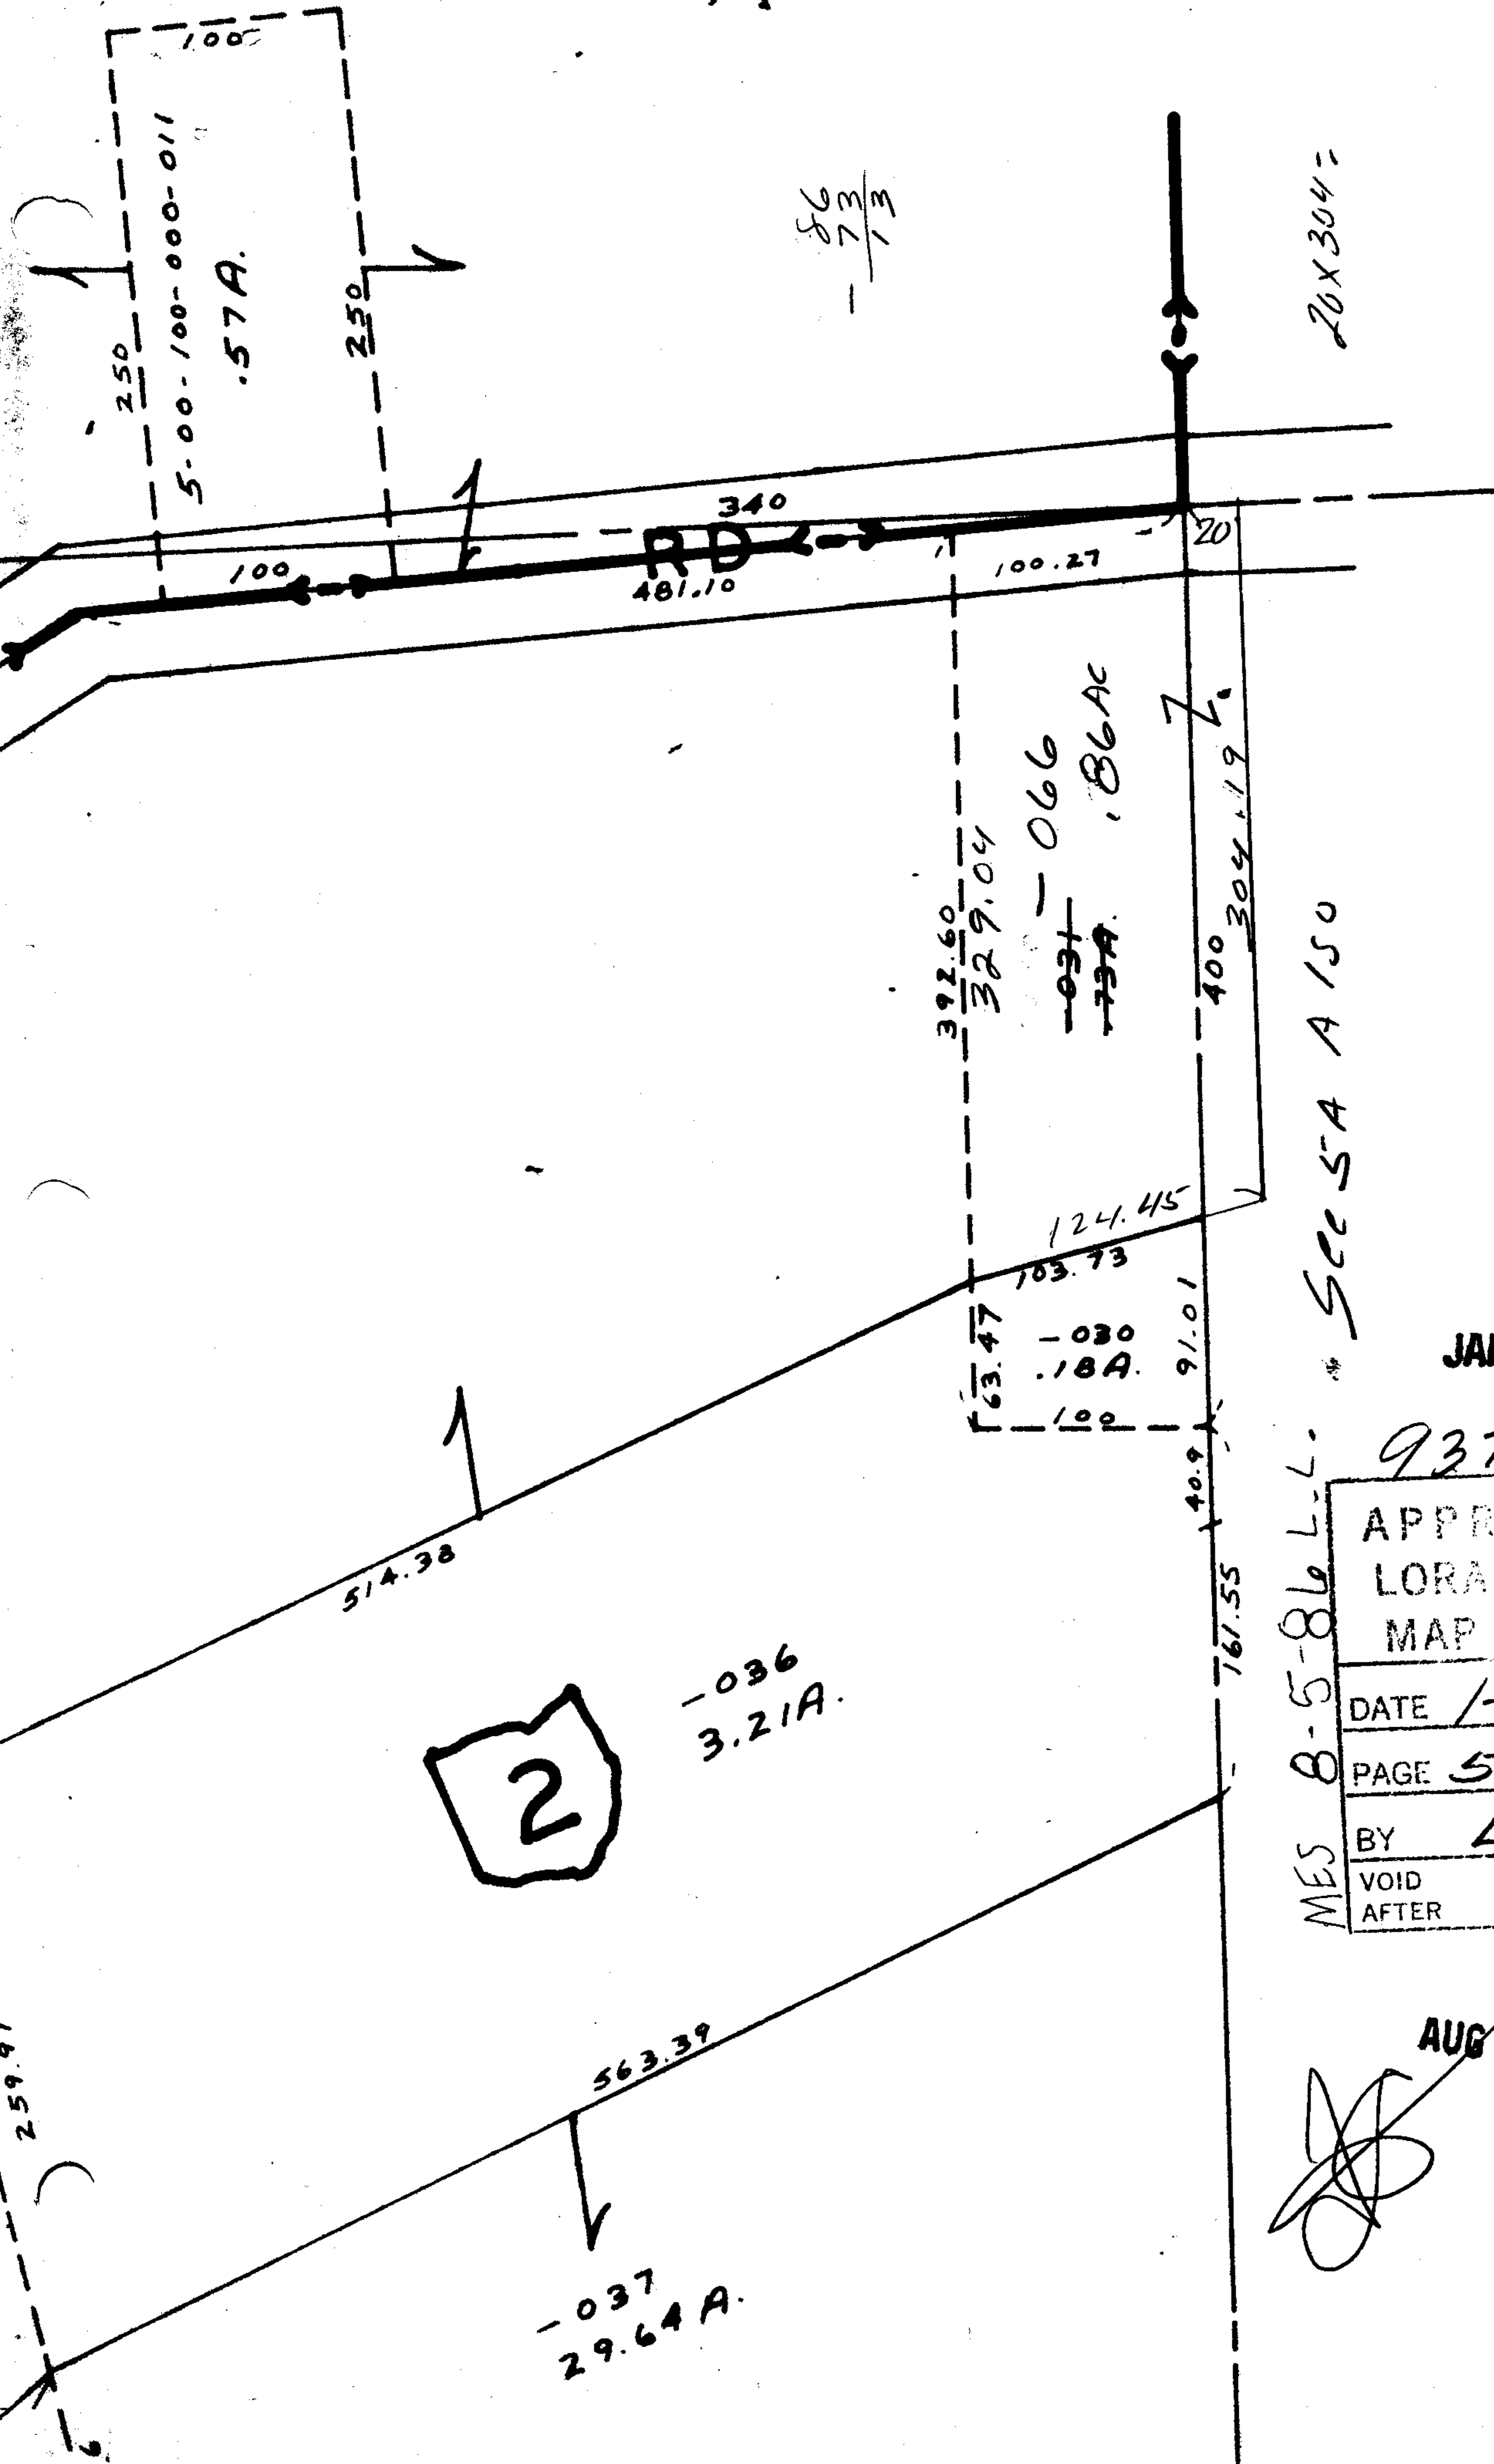

20X304

RD

SEE SA A 150

JAN 16 1976

9370

APPROVED
LORAIN
MAP DEPT.
DATE 1-15-76
PAGE 5-00-099C
BY LW Hall
VOID AFTER

MES 8-5-86 L-L.

AUG 11 1977

2

-036
3.21A.

-037
29.64A.