


RICHFIELD

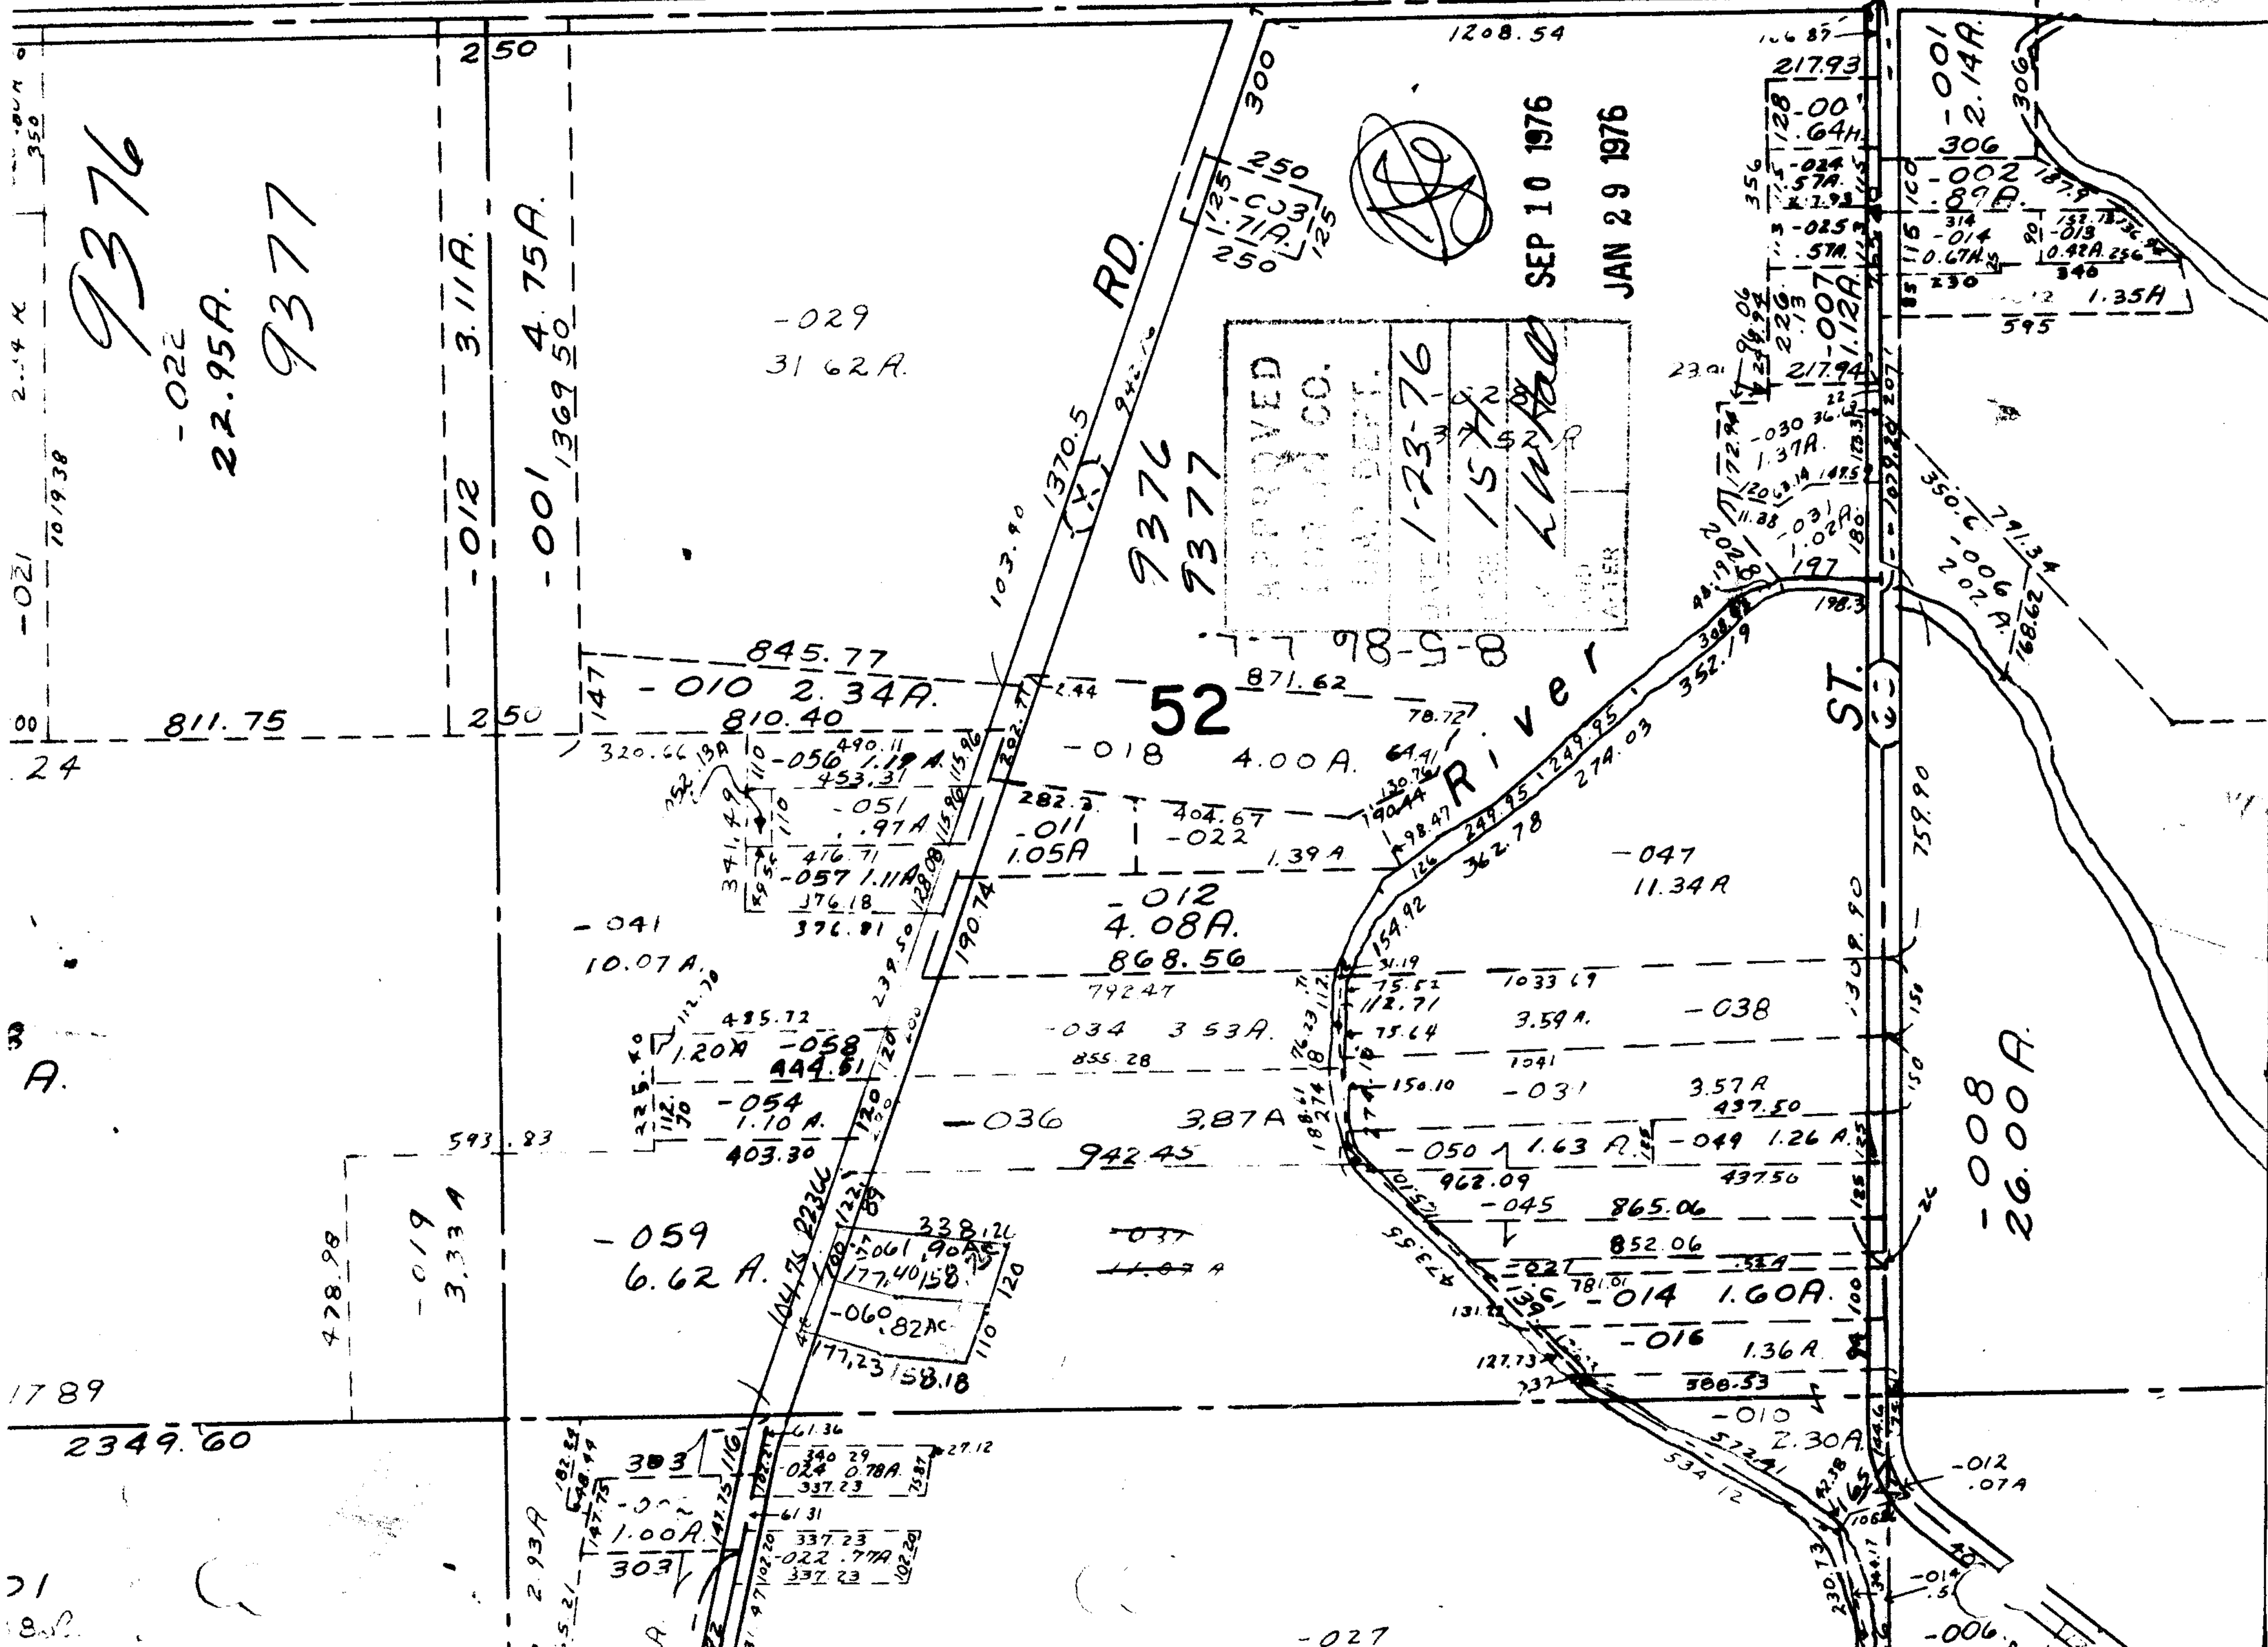

9376

-022
22.95A.

9377

-012 3.11A.
-001 4.75A.
1369.50

-029
3162A.

9376
9377

APPROVED
LAND CO.
DATE 1-23-76
L.W. HALL

SEP 10 1976
JAN 29 1976

52

River

ST.

-008
26.00A.

2349.60

-019
3.33A

-059
6.62A.

-036
3.87A
942.45

-012
4.08A.
868.56

-018
4.00A.

-047
11.34A

-038

-031
3.57A
497.50

-049
1.26A.
437.50

-045
865.06

-022
852.06

-014
1.60A.

-016
1.36A.

-010
2.30A.

-012
.07A

-014
.5

-006

-027