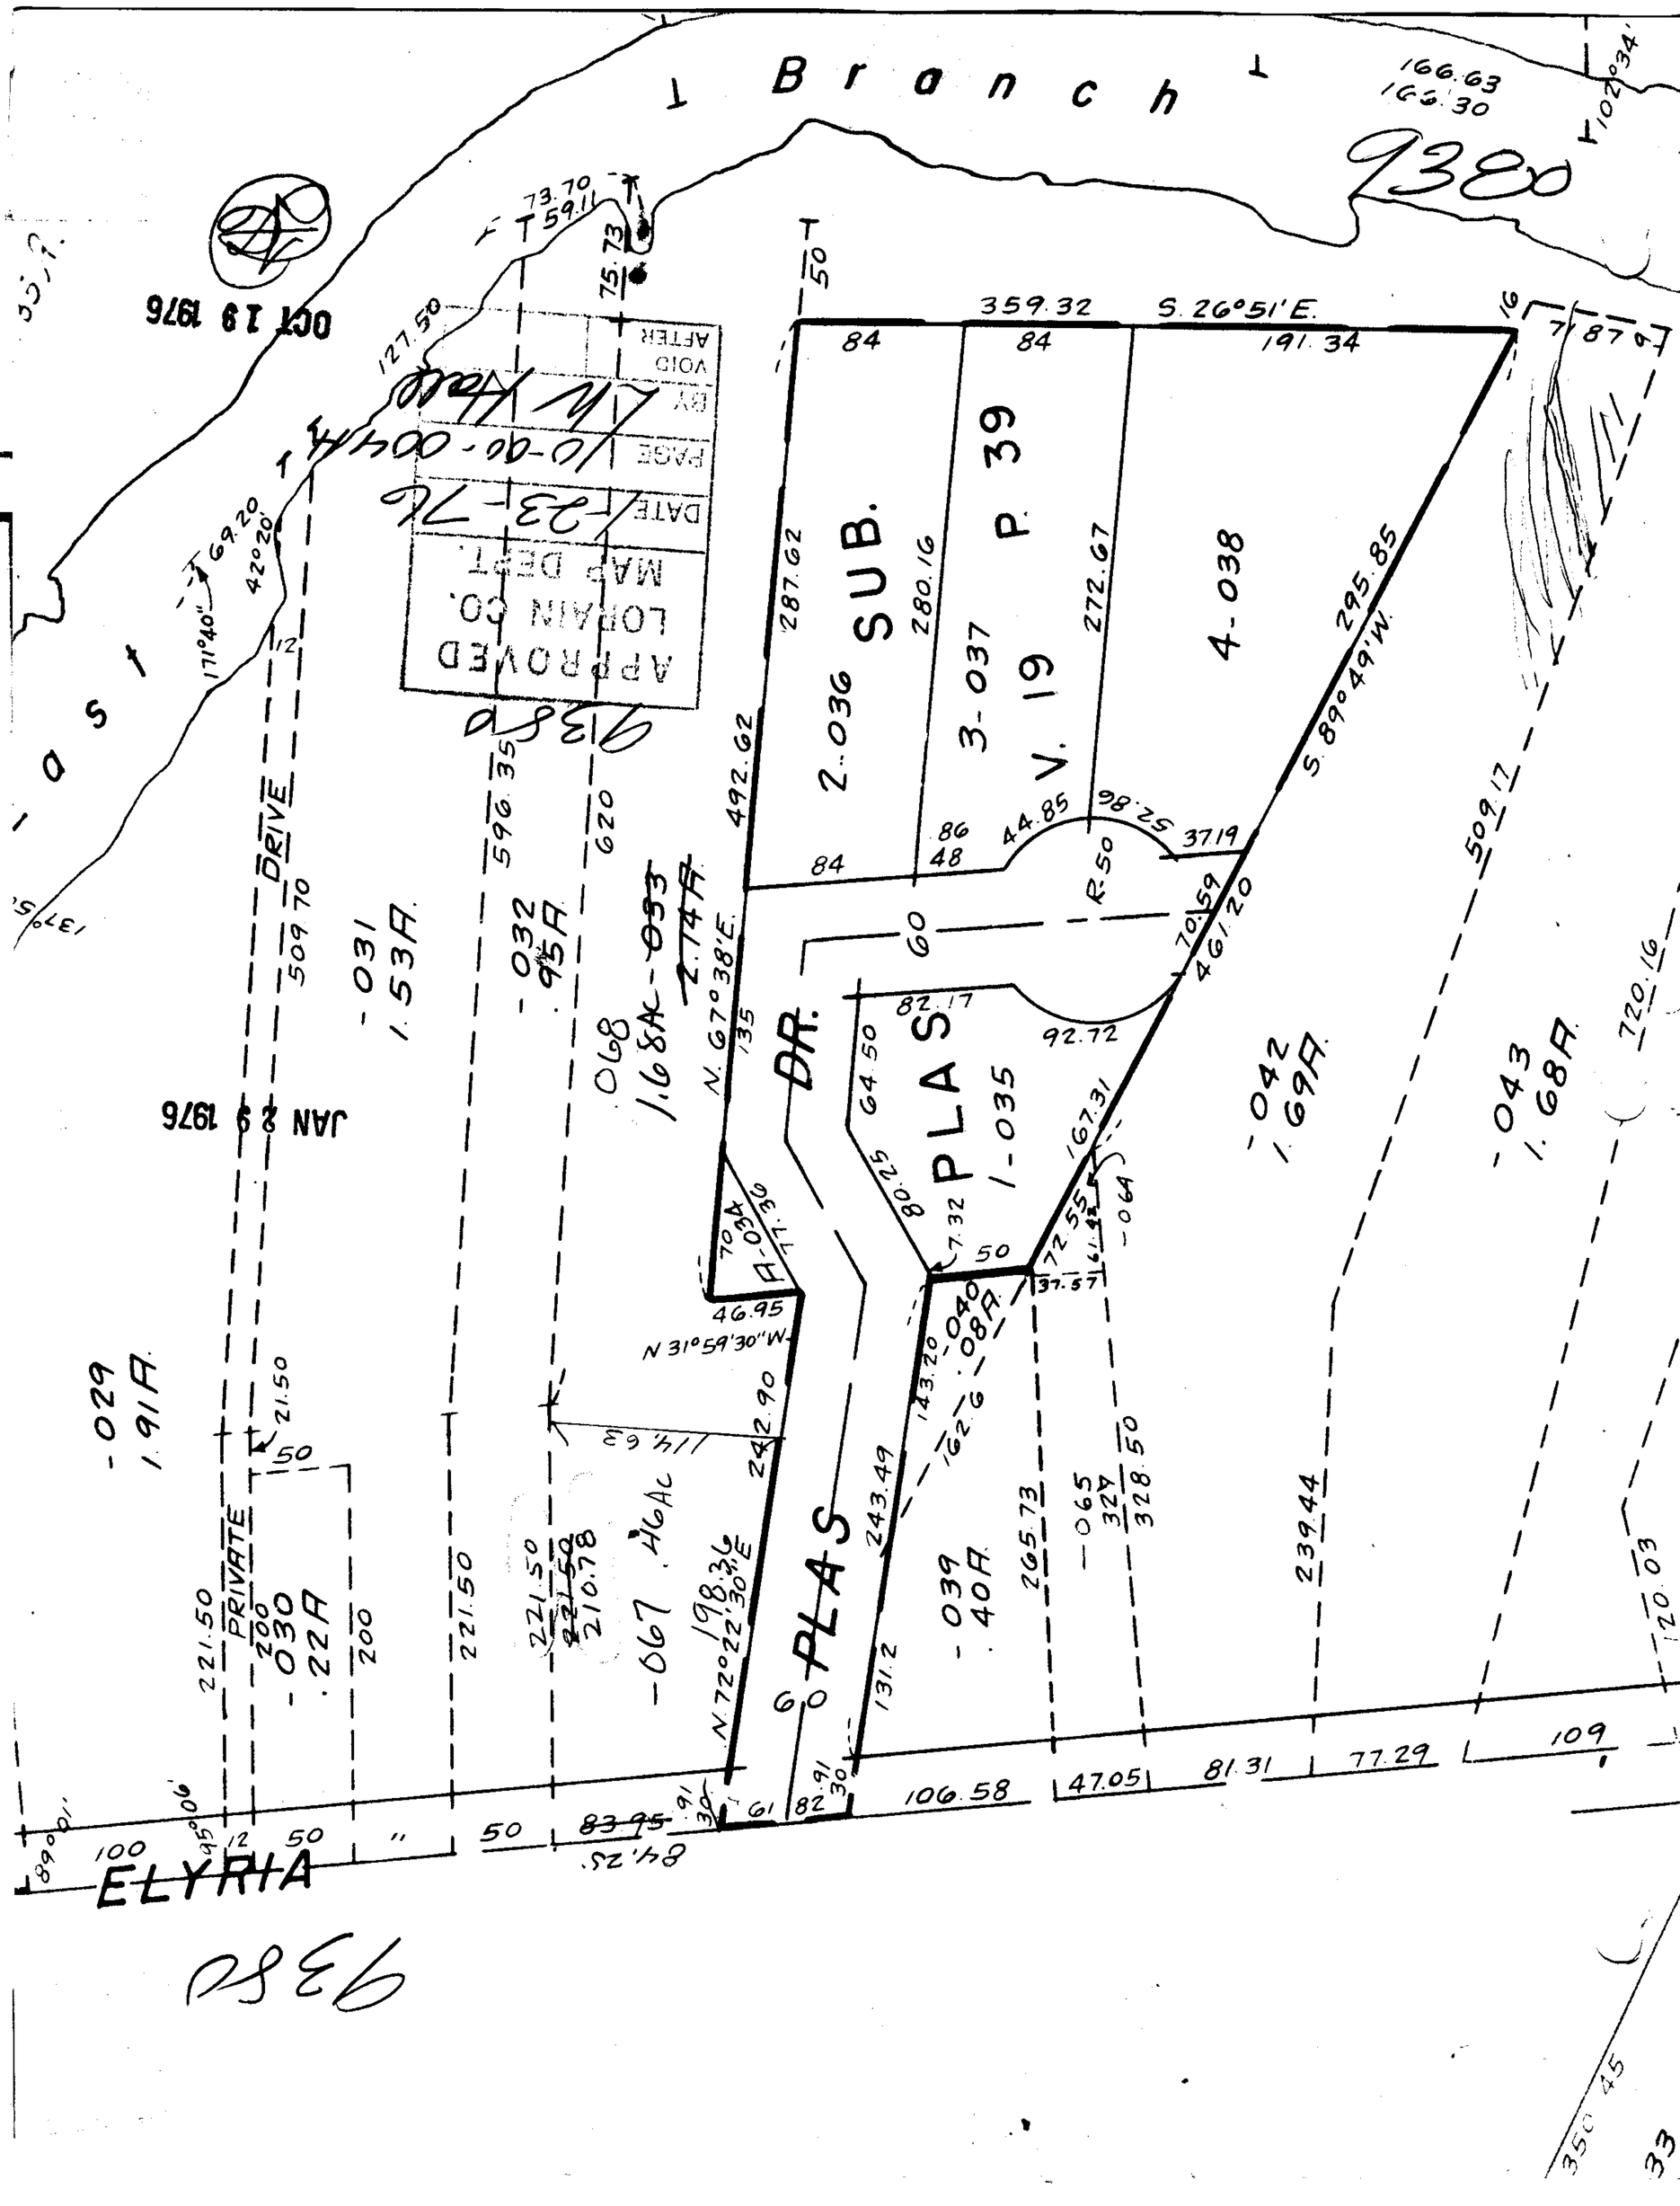

Branch
9380
OCT 19 1976
JAN 29 1976
APPROVED
LORAIN CO.
MAP DEPT.
DATE 1-23-76
PAGE 10-00-004A
BY
VOID
AFTER
SUB.
P. 39
V. 19
PLAS
DR.
PLAS
ELYRIA
DRIVE
PRIVATE
S. 26°51'E.
S. 89°49'W.
N. 67°38'E.
N 31°59'30"W.
N 72°22'30"E