


9383

161.94
71.93

90.01

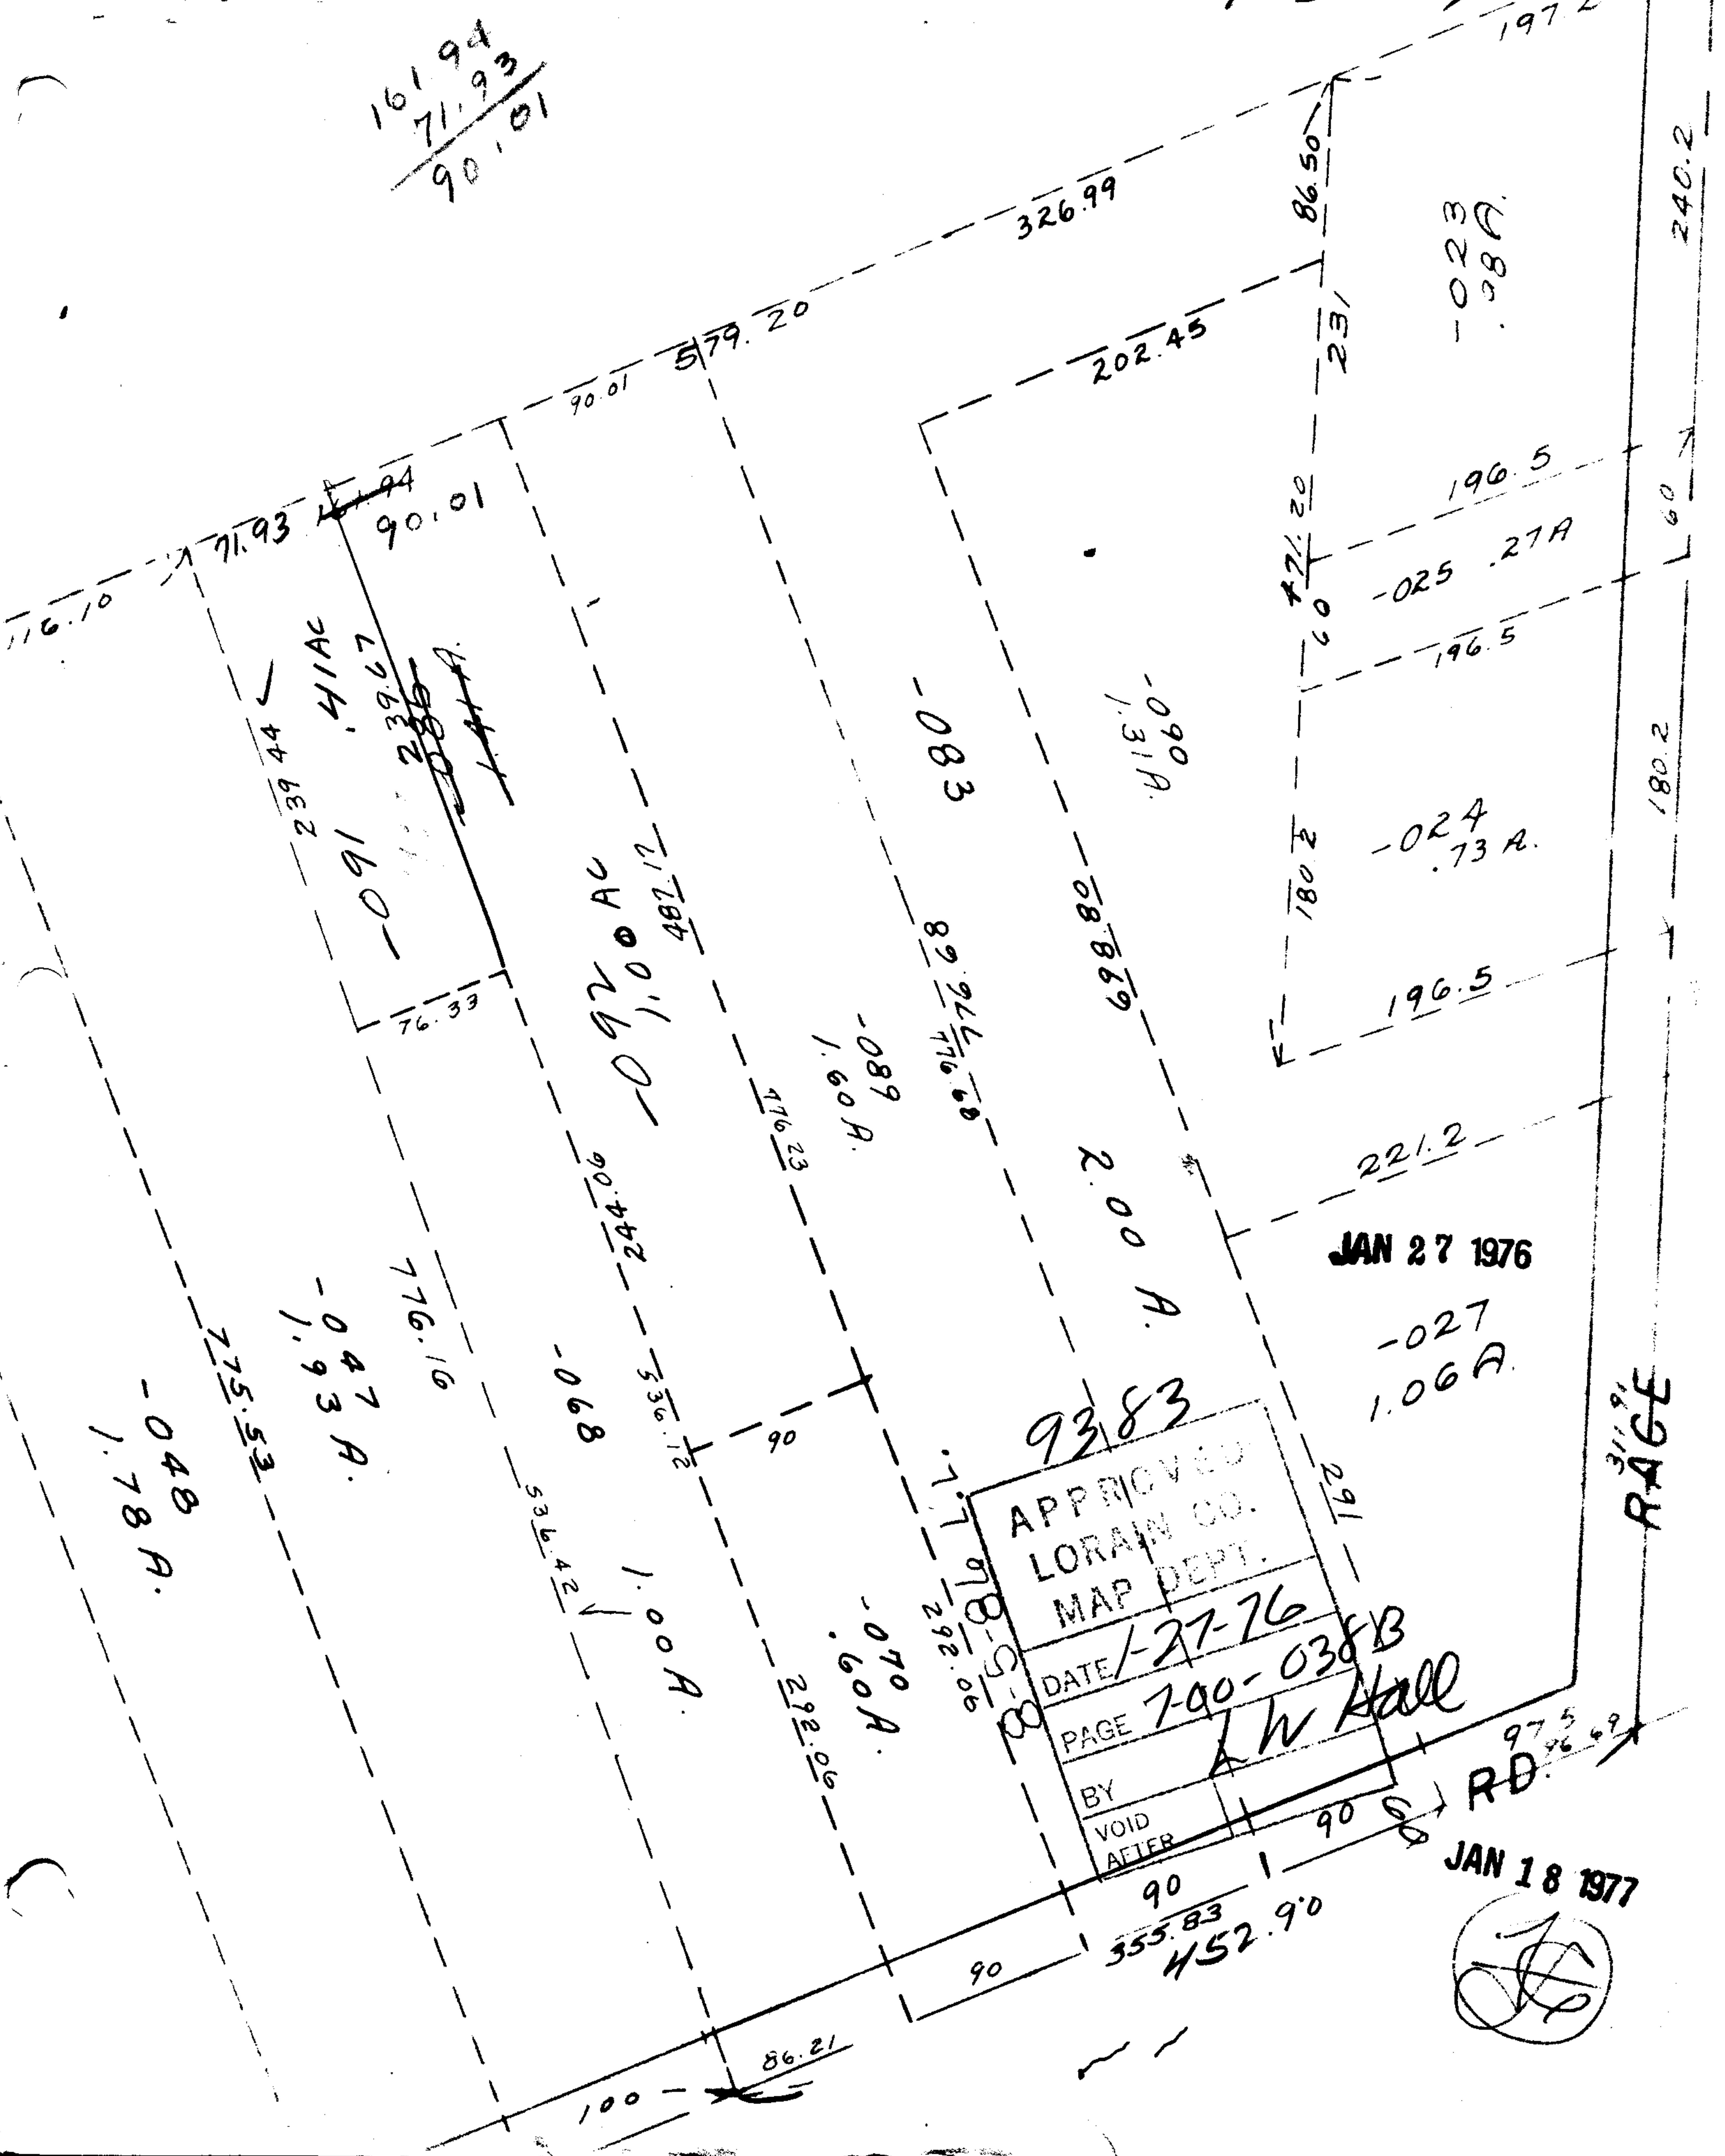

9383
 APPROVED
 LORAIN CO.
 MAP DEPT.

DATE 1-27-76
 PAGE 700-038B
 BY L W Hall
 VOID AFTER

JAN 27 1976

JAN 18 1977



RAGE