


BATES

(60)

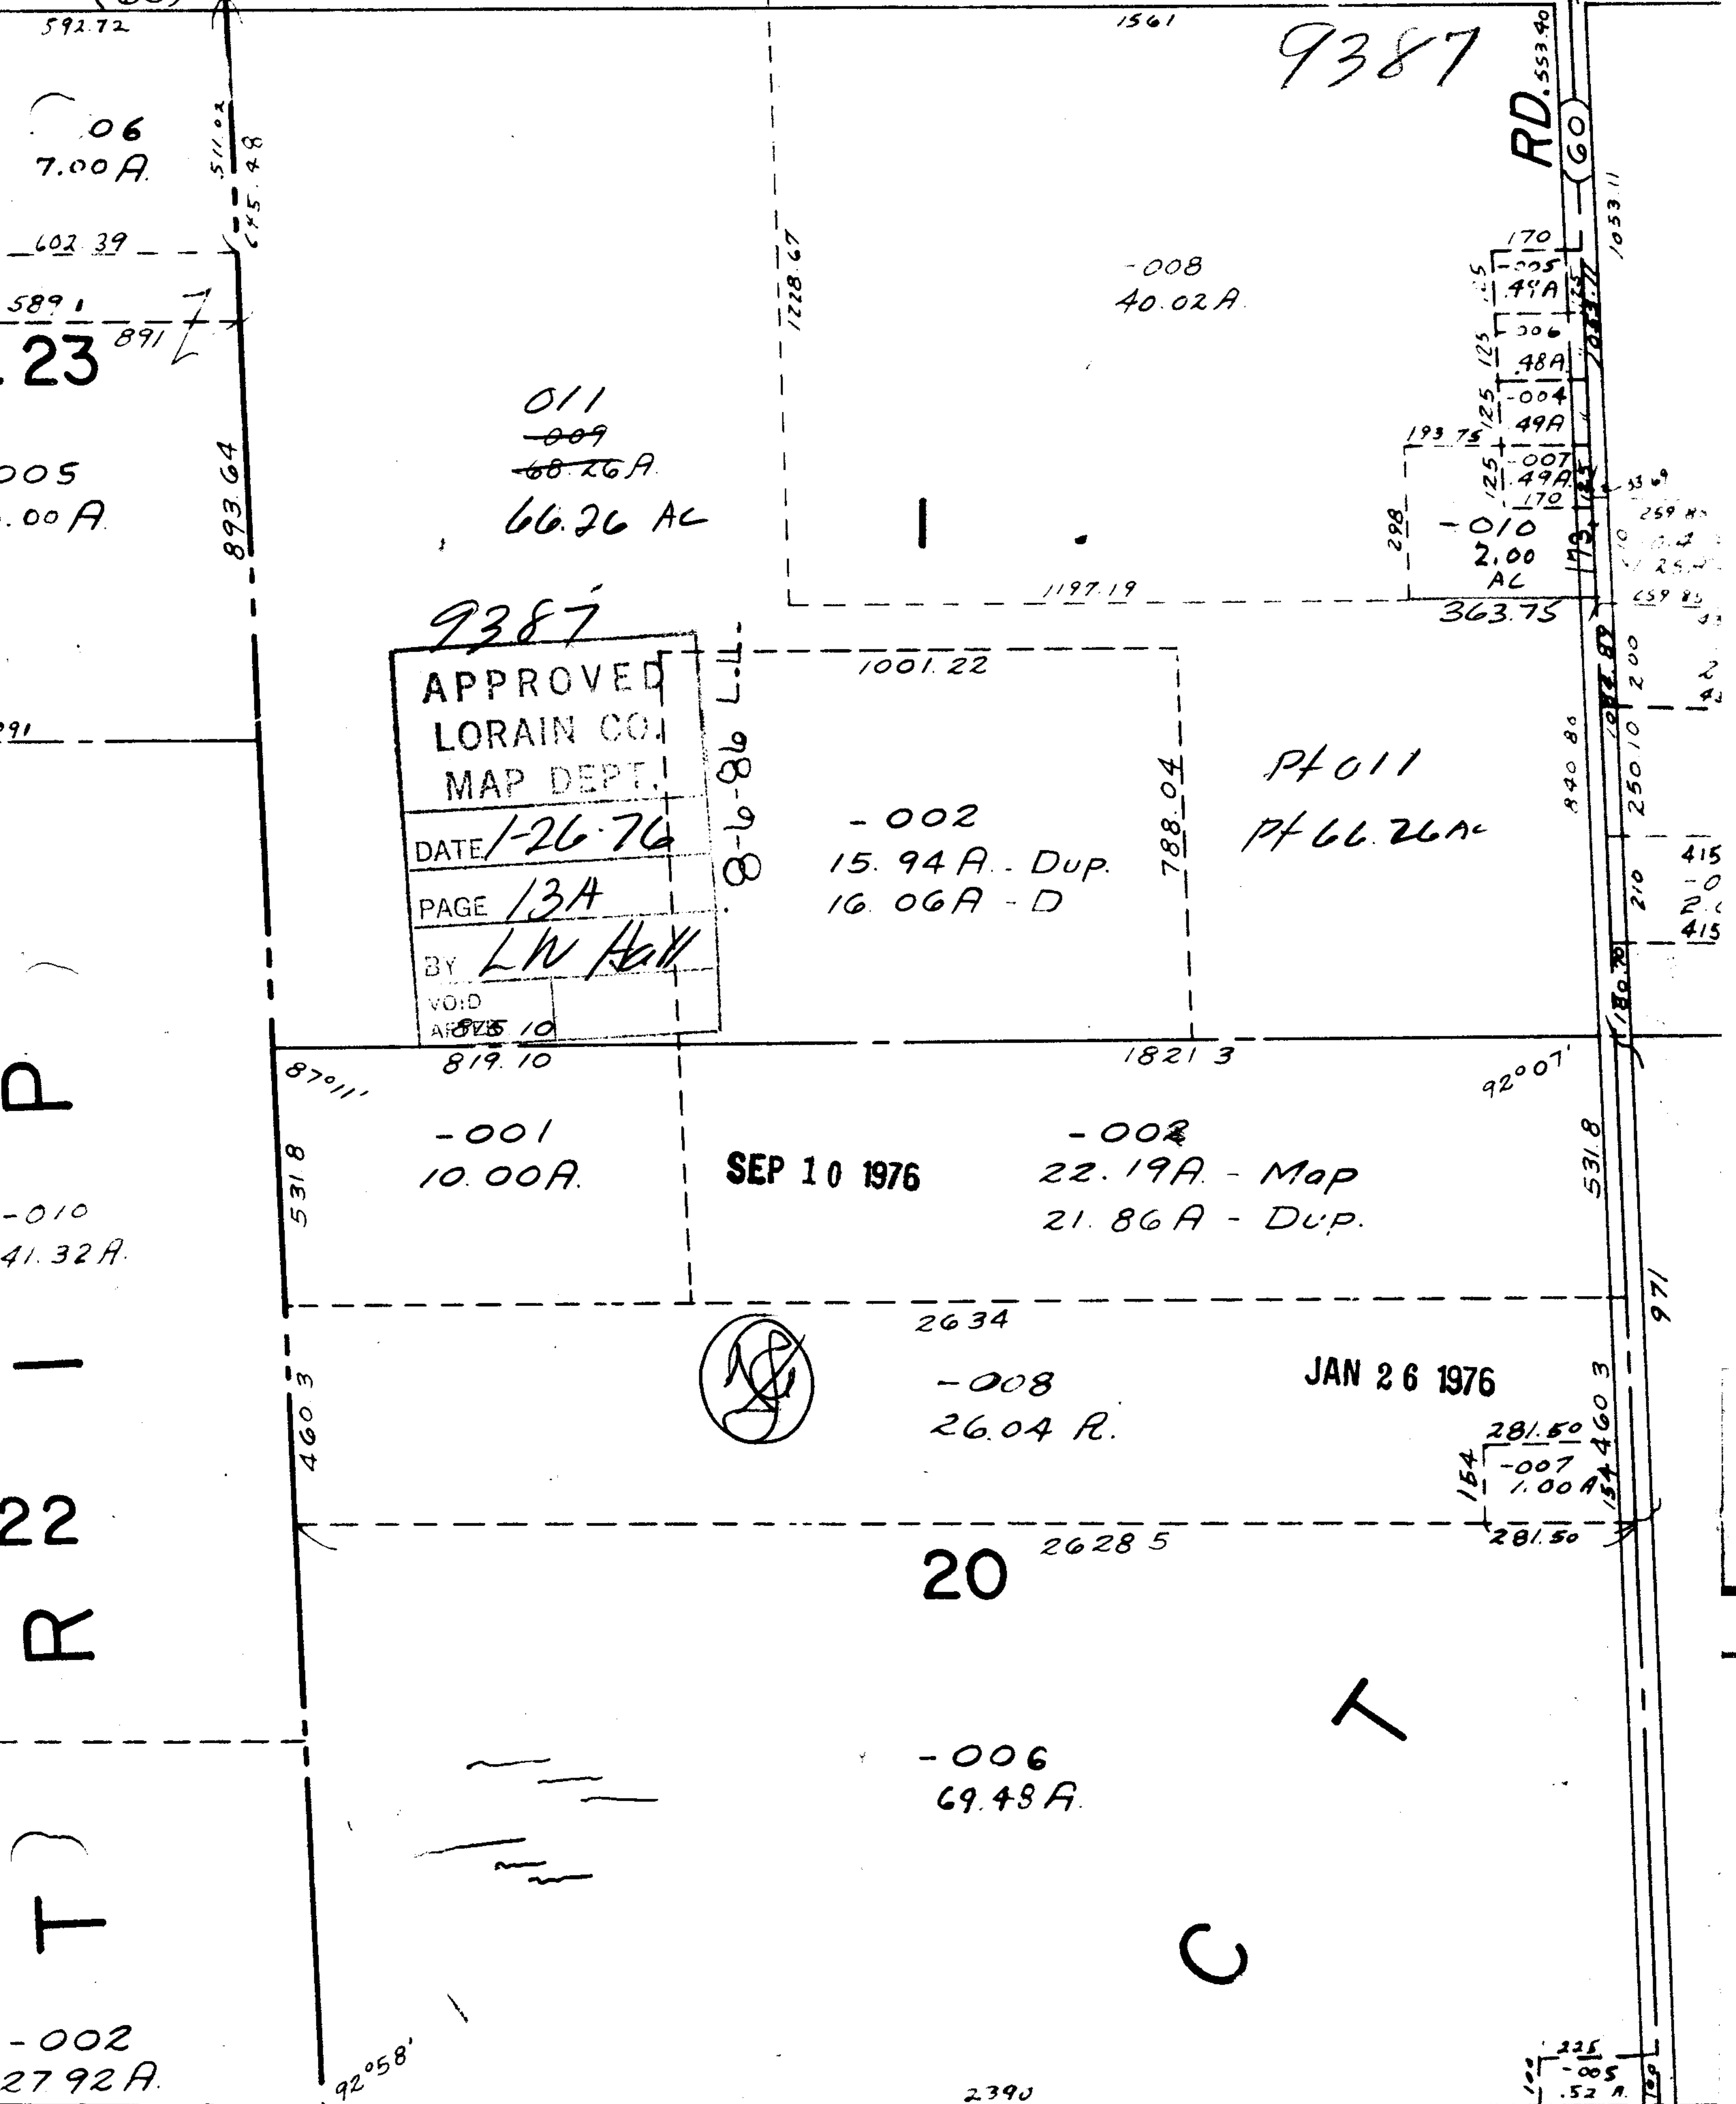

9387

RD. 553.40

06
7.00 A.

602.39

589.1
23

005
.00 A.

893.64

011
~~009~~
~~66.26 A.~~
66.26 AC

-008
40.02 A.

170
1005
49A
306
48A
1004
49A
193.75
125
125
170
1007
49A
170
298
1010
2.00
AC

9387

APPROVED
LORAIN CO.
MAP DEPT.
DATE 1-26-76
PAGE 13A
BY L W Hall
VOID
AFTER 10

-002
15.94 A. - Dup.
16.06 A - D

Pf 011
Pf 66.26 AC

879.11
819.10
-001
10.00 A.

SEP 10 1976

-002
22.19 A. - Map
21.86 A - Dup.

2634
-008
26.04 R.

JAN 26 1976

20

-006
69.48 A.

-002
27.92 A.

92°58'

2390

225
1005
52 A.