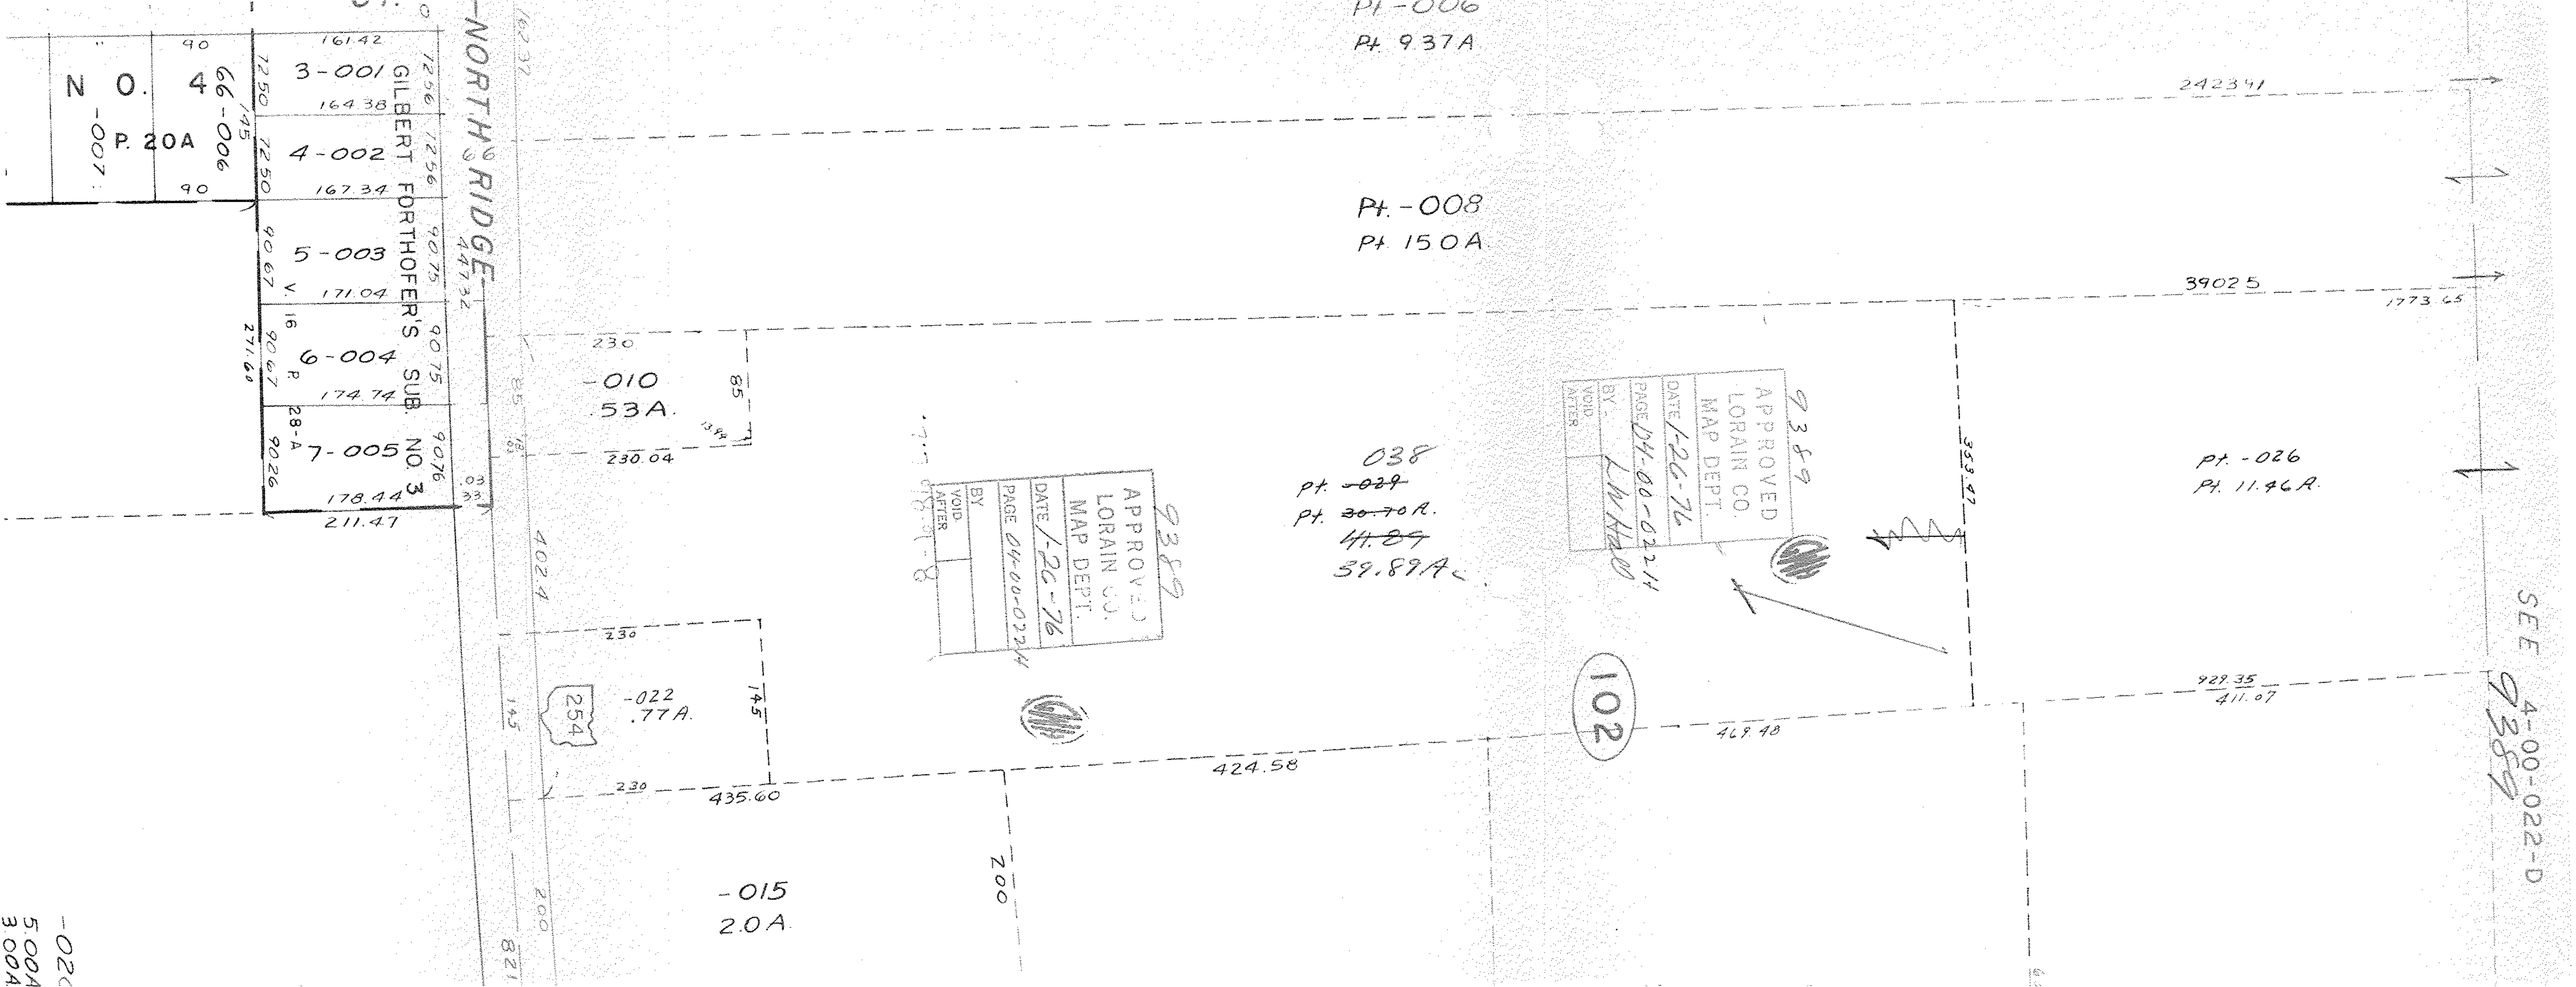

Pt.-006
Pt. 9.37A
242.39
Pt.-008
Pt. 15.0A
39025
1773.65
NORTH RIDGE
66
447.32
N O. 4
P. 20A
66-006
-007
3-001
161.42
164.38
4-002
167.34
5-003
171.04
6-004
174.74
7-005
178.44
211.47
GILBERT FORTHOFER'S SUB. NO. 3
-010
.53A.
230.04
230
85
-022
.77A.
254
145
435.60
424.58
-015
2.0A.
200
038
Pt. ~~-029~~
Pt. ~~30.70~~A.
~~41.89~~
39.89A.
9389
APPROVED
LORAIN CO.
MAP DEPT.
DATE 1-26-76
PAGE 04-00-022-14
BY
VOID
AFTER
102
469.48
353.47
Pt.-026
Pt. 11.46A.
929.35
411.07
SEE 4-00-022-D
9389
-020
5.00A
3.00A